

DRILLER: COMPLETE THIS APPLICATION AND RETURN ALL PARTS OF THIS FORM INTACT TO THE ENVIRONMENTAL AGENCY IN THE COUNTY IN WHICH THE WELL IS TO BE DRILLED. PRESS FIRMLY FOR FOURTH COPY.

EMERGENCY/TEMP NO. IF ANY

B 1	5538	SEQUENCE NO. (MDE USE ONLY)	STATE OF MARYLAND APPLICATION FOR PERMIT TO DRILL WELL please type	STATE PERMIT NUMBER
1 2 3 6				- - 1979
				70 fill in this form completely 79

Date Received (APA) 8/16/2010

OWNER INFORMATION

Thompson Last Name Jennifer First Name

755 Gaither Rd. Street or RFD

Sykesville Md. 21784

LOCATION OF WELL

Howard COUNTY

755 Gaither Rd. SUBDIVISION

SECTION _____ LOT _____

Sykesville NEAREST TOWN

MILES FROM TOWN (enter 0 if in town) 2 M I

DRILLER INFORMATION

Stanley Bollinger M S D O B I License No.

Stan's Well Drilling Firm Name

PO Box 2035, Westminster, Md. 21158 Address

Stanley Bollinger Signature 8/12/10 Date

DIRECTION OF WELL FROM TOWN (CIRCLE BOX)

ON WHICH SIDE OF ROAD (CIRCLE APPROPRIATE BOX)

Gaither Rd. NEAR WHAT ROAD

ON WHICH SIDE OF ROAD (CIRCLE APPROPRIATE BOX)

1500 DISTANCE FROM ROAD ENTER FT OR MI

TAX MAP: _____ BLK: _____ PARCEL _____

WELL INFORMATION

APPROX. PUMPING RATE 5 GAL. PER MIN.

AVERAGE DAILY QUANTITY NEEDED Less than 10,000 GAL

USE FOR WATER (CIRCLE APPROPRIATE BOX)

DOMESTIC POTABLE SUPPLY & RESIDENTIAL IRRIGATION

FARMING (LIVESTOCK WATERING & AGRICULTURAL IRRIGATION)

INDUSTRIAL, COMMERCIAL, DEWATERING

PUBLIC WATER SUPPLY WELL

TEST, OBSERVATION, MONITORING

GEO-THERMAL

NOT TO BE FILLED IN BY DRILLER HEALTH DEPARTMENT APPROVAL

COUNTY NAME _____ COUNTY NO. _____

STATE SIGNATURE _____ INSERT S → 41

DATE ISSUED _____

43 MM DD YY 48 CO SIGNATURE _____ EXP. DATE _____

NORTH GRID _____ EAST GRID _____

APPROXIMATE DEPTH OF WELL 250 FEET

APPROXIMATE DIAMETER OF WELL 6 INCH

METHOD OF DRILLING (circle one)

BORED (or Augered) JETTED Jetted & DRIVEN

AIR-ROtary AIR-PERcussion ROTARY (Hydraulic Rotary)

CABLE REVERSE-ROtary DRive-POINT

other _____

REPLACEMENT OR DEEPEMED WELLS (CIRCLE APPROPRIATE BOX)


THIS WELL WILL NOT REPLACE AN EXISTING WELL

THIS WELL WILL REPLACE A WELL THAT WILL BE ABANDONED AND SEALED

THIS WELL WILL REPLACE A WELL THAT WILL BE USED AS A STANDBY-CONTACT LOCAL APPROVING AUTHORITY FOR POLICY ON STANDBY WELLS

THIS WELL WILL DEEPEAN AN EXISTING WELL

PERMIT NUMBER OF WELL TO BE REPLACED OR DEEPEMED (IF AVAILABLE) 41 _____ 52 _____

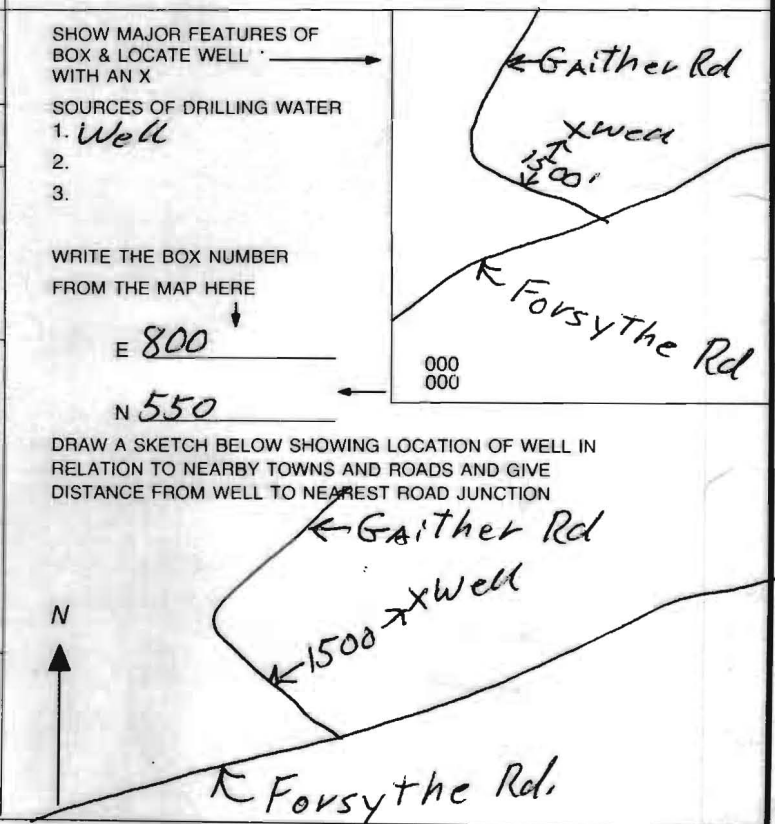

Not to be filled in by driller (MDE OR COUNTY USE ONLY)

APPROX. PERMIT NUMBER _____ G _____

PERMIT No. _____

70 71 72 73 74 75 76 77 78 79

01/02/01/08

Well Not Drilled,
Called Driller
to Meet at Site
and Never Got a
Response (BB)



Maryland Department of Assessments and Taxation
HOWARD COUNTY
 Real Property Data Search (2007 vw2.3d)

[Go Back](#)
[View Map](#)
[New Search](#)

Account Identifier: District - 03 Account Number - 307700

Owner Information

Owner Name: THOMPSON JENNIFER KATHRYN **Use:** AGRICULTURAL
Mailing Address: 755 GAITHER RD **Principal Residence:** YES
 SYKESVILLE MD 21784-5828 **Deed Reference:** 1) / 4553/ 83
 2)

Location & Structure Information

Premises Address **Legal Description**
 755 GAITHER RD LOT4 13.328 AR
 SYKESVILLE 21784 755 GAITHER RD

Map	Grid	Parcel	Sub District	Subdivision	Section	Block	Lot	Assessment Area	Plat No:
4	19	102					4	1	Plat Ref:

Special Tax Areas **Town Ad Valorem Tax Class** NO A/V, RURAL FIRE TAX

Primary Structure Built	Enclosed Area	Property Land Area	County Use
1980	1,664 SF	13.32 AC	
Stories	Basement	Type	Exterior
1	YES	STANDARD UNIT	BRICK

Value Information

	Base Value	Value Phase-in Assessments			PREFERRED LAND VALUE INCLUDED IN LAND VALUE
		As Of 01/01/2010	As Of 07/01/2010	As Of 07/01/2011	
Land	303,660	216,100			
Improvements:	223,400	252,400			
Total:	527,060	468,500	468,500	468,500	
Preferential Land:	6,160	6,100	6,100	6,100	

Transfer Information

Seller: CRAIG JENNIFER KATHRYN	Date: 12/18/1998	Price: \$0
Type: NOT ARMS-LENGTH	Deed1: / 4553/ 83	Deed2:
Seller: HEIL JOHN C	Date: 06/25/1997	Price: \$275,000
Type: IMPROVED ARMS-LENGTH	Deed1: / 4003/ 528	Deed2:
Seller: CONAWAY JAMES M	Date: 09/06/1983	Price: \$140,000
Type: IMPROVED ARMS-LENGTH	Deed1: / 1188/ 215	Deed2:

Exemption Information

Partial Exempt Assessments	Class	07/01/2010	07/01/2011
County	000	0	0
State	000	0	0
Municipal	000	0	0

Tax Exempt: NO
Exempt Class:

Special Tax Recapture:
 AGRICULTURAL TRANSFER TAX

755 Gaither Rd

Pinet Haven Farm -

Gaither Rd

1500'

New Aq Well
x

490
813

(410) 876-6952

P.O. 202
Woodbine 21797

x well

House

Septic