

MARYLAND DEPARTMENT OF THE ENVIRONMENT, WATER MANAGEMENT ADMINISTRATION
1800 Washington Blvd., Baltimore, Maryland 21230 (410) 537-3784

WATER WELL ABANDONMENT-SEALING REPORT FORM

SUBMIT COPIES OF COMPLETED FORM TO:

- * COUNTY ENVIRONMENT AGENCY (contact MDE, WMA if address needed)
- * WELL OWNER
- * MDE, WATER MANAGEMENT ADMINISTRATION, WELL PROGRAM

DATE WELL ABANDONED: Aug 15 2007 (month/day/year)

- * PERMIT NUMBER OF ABANDONED WELL (if any) N/A
- * PERMIT NUMBER OF REPLACEMENT WELL N/A


PERSON ABANDONING WELL: Ralph E. MAYNE

WELL DRILLERS LICENSE NUMBER: 117
CIRCLE: MWD/MSD/MGD

OWNER'S NAME: DORSEY FAMILY HOMES

WELL LOCATION:
 COUNTY: HOWARD
 NEAREST TOWN: WEST FRIENDSHIP
 TAX MAP BLOCK PARCEL
 SUBDIVISION: FREDERICK WOODCOCK
 SECTION: LOT: I
 NEAREST ROAD: MD RT. 144

SITE LOCATION MAP

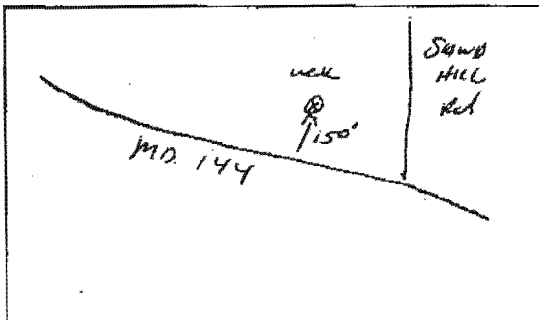

- * TYPE OF WELL BEING ABANDONED:
 DRILLED JETTED
 BORED/AUGERED HAND DUG
 OTHER (specify)

- * USE CODE:
 DOMESTIC MUNICIPAL/PUBLIC
 IRRIGATION INDUSTRIAL
 TEST/OBSERVATION GEOTHERMAL

- * TYPE OF CASING:
 STEEL PLASTIC
 CONCRETE OTHER (specify)

SIZE OF CASING: 6" INCHES IN DIAMETER

DEPTH OF WELL: 90 FEET DEEP

WAS ANY CASING REMOVED? NO
If yes, length removed, in feet:

WAS CASING RIPPED OR PERFORATED? NO

LOG OF SEALING MATERIAL

MATERIAL	FEET	
	FROM	TO
Cement	90	3
Top Soil	3	0
VOLUME OF MATERIAL USED		
20 Bags		