

APPLICATION

A 28524

P _____

SEWAGE DISPOSAL TESTING

STATE OF MARYLAND - DEPARTMENT OF HEALTH AND MENTAL HYGIENE

DISTRICT 4th

HOWARD COUNTY HEALTH DEPARTMENT
ENVIRONMENTAL HEALTH SERVICES
P O BOX 476, ELLICOTT CITY, MARYLAND 21043
TELEPHONE: 465-5000, EXT. 356

DATE 7/20/78

TO: THE COUNTY HEALTH OFFICER
ELLICOTT CITY, MARYLAND

I, HEREBY, APPLY FOR THE NECESSARY TEST IN ORDER TO CONSTRUCT (OR RECONSTRUCT) A SEWAGE DISPOSAL SYSTEM.

PROPERTY OWNER Howard Associates - Leland L. Dupont III
ADDRESS 13850 Forsythe Road
Sykesville Md 21784 PHONE 489-4391

PROPERTY LOCATION:

SUBDIVISION Lower Trail LOT NO. 7
16368
ROAD AND DESCRIPTION Route 144

SIZE OF LOT 5.058 acres m/l TYPE BLDG 3 or 4 bedrooms
NUMBER OF BEDROOMS

IF NOT SINGLE RESIDENCE DESCRIBE _____

THE SYSTEM INSTALLED UNDER THIS APPLICATION IS ACCEPTABLE ONLY UNTIL PUBLIC FACILITIES BECOME AVAILABLE.

SIGNATURE OF APPLICANT /s/ Pat Lendrim

APPROVED BY Raymond Hodger FOR Dry Well DATE 4/2/80
(KIND OF SYSTEM)

REJECTED BY _____ FOR _____ DATE _____
(KIND OF SYSTEM)

HOLD PENDING FURTHER TESTS _____ DATE _____

REASONS FOR REJECTION OR HOLDING 2/7/79 Per OK Hold for

Certified Plant B/H BLDG. PERMIT SIGNED
AND RETURNED 7/22/78
Serial # 5471 SFID

THIS IS NOT A PERMIT

Field sheet

Tests per stake

INDICATE NORTH - NAME ADJOINING ROADWAY AS BASE LINE

Soil Profile
Below clay
↓

DATE	TEST NO.	DEPTH	PRE-WET		TEST - 1" DROP		TIME
			START	STOP	START	STOP	
1/78	1						
	2						
	3						
	4						
	5						
	6						
	7		Vesical				


REMARKS High grass & weeds No tests 7/21/78

TYPE OF SOIL _____

TESTED BY _____ ALSO PRESENT: _____

HOWARD ASSOCIATES LOT 7
ROUTE 144 WEST OF LISBON

12/13/78	1S	5 1/2	327	357	little open	FAIL		LOWEST
12/13/78	1D	14	328	337	337	357	20	
	2S	4 1/2	332	334	334	337	3	NEXT LOWEST
	2D	14	331	341	341	352	11	
	3V	11 1/2	TOP 2 FT CLAY BOT	9 1/2	SANDY SHALE			NEXT HIGHEST
	4S	4	336	339	339	346	7	HIGHEST
	4D	13	340	344	344	354	10	
8/7/79	1m	6	1144	1154	1154	1214	20	

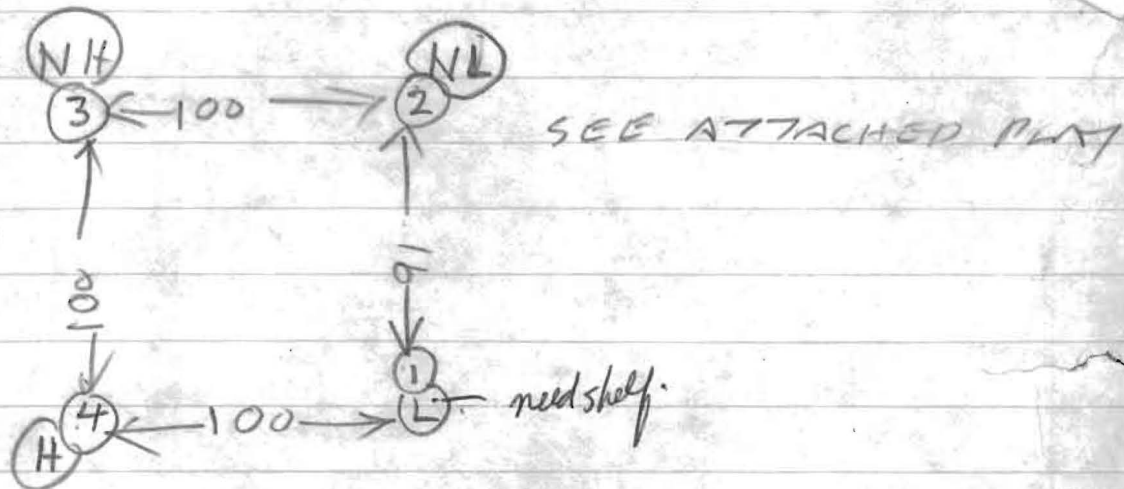

12/13/78 DIG MORE ISLOW SHELF

8/7/79 - EXTRA HOLE DUG AT 6 FT LEVEL ON HOLE ①