

Bureau of Environmental Health
 8930 Stanford Boulevard, Columbia, MD 21045
 Main: 410-313-2640 | Fax: 410-313-2648
 TDD 410-313-2323 | Toll Free 1-866-313-6300
www.hchealth.org
 Facebook: www.facebook.com/hocohealth

Maura J. Rossman, M.D., Health Officer

RECEIPT DATE: 3/21/16

ONSITE SEWAGE DISPOSAL SYSTEM

P 558042

INSTALLATION

APPROVAL DATE: 3/29/16 **SEC**

PERMIT
TANK REPLACEMENT

A _____

PROPERTY ADDRESS: 628 River Road

SUBDIVISION: Codd Property LOT: 2 TAX ID: 03-318273

CONTRACTOR: Freedom Septic EMAIL: Kristin@freedomseptic.com

CONTRACTOR ADDRESS: 2809 Liberty Road, Sykesville, MD 21784 PHONE: 410-984-6863

PROPERTY OWNER: Federal Home Loan and Mortgage Corp. EMAIL: _____

OWNER ADDRESS: 8200 Jones Branch Drive, McClean, VA 22102 PHONE: _____

NUMBER OF BEDROOMS: _____ SEPTIC TANK SIZE: _____ DRAINFIELD SIZE/TYPE: _____

LOCATION:	
NOTES:	


ISSUED BY: Jeff Williams ISSUE DATE: 3-23-16 EXPIRATION DATE: 3-23-17

- NOTE: CONTRACTOR MUST SCHEDULE AN INSPECTION AND GAIN APPROVAL OF ALL COMPONENTS PRIOR TO COVERING
- NOTE: AN ELECTRICAL PERMIT IS REQUIRED FOR INSTALLATION OF ANY ELECTRICAL COMPONENTS OF THE SYSTEM
- NOTE: MDE RECOMMENDS SEPTIC TANKS, BAT, AND OTHER PRETREATMENT UNITS BE PUMPED AT A FREQUENCY ADEQUATE TO ENSURE THAT SOLIDS ARE NOT DISCHARGED TO THE DISPOSAL AREA

NEITHER THE HOWARD COUNTY COUNCIL NOR THE HEALTH DEPARTMENT IS RESPONSIBLE FOR THE SUCCESSFUL OPERATION OF ANY SYSTEM. PERMITTEE RESPONSIBLE FOR OBTAINING FINAL APPROVAL ON THIS PERMIT. CALL 410-313-1771 FOR INSPECTION OF SEPTIC SYSTEM.

NOT TO SCALE

1" = 30'

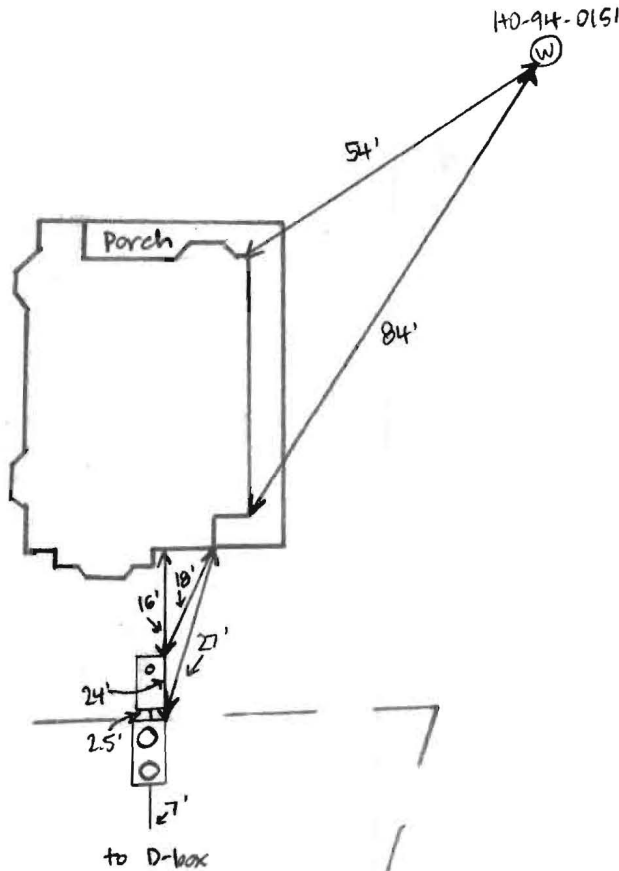

ROAD NAME

TRENCH/DRAINFIELD DATA

WIDTH _____ INLET _____ BOTTOM _____

NUMBER OF TRENCHES _____

TOTAL LENGTH _____

ABSORPTION AREA _____

DISTRIBUTION BOX LEVEL _____

DISTRIBUTION BOX BAFFLE _____

DISTRIBUTION BOX PORT _____

Existing SEPTIC TANK DATA

SEPTIC TANK I LEVEL _____

MANUFACTURER BAB?

CAPACITY 1000 GAL

SEAM LOC MID

TANK LID DEPTH 8"

BAFFLES YES

BAFFLE FILTER NO

MANHOLE LOC NONE

6" PORT LOC FRONT

WATERTIGHT TEST —

SLOTTED NO

DATE ON LID —

New

~~EXISTING~~ SEPTIC TANK LEVEL YES

MANUFACTURER BABYLON

CAPACITY 1500 GAL

SEAM LOC TOP

TANK LID DEPTH 1'

BAFFLES OUTLET

BAFFLE FILTER NO

MANHOLE LOC FRONT + REAR

6" PORT LOC NONE

WATERTIGHT TEST NO

SLOTTED YES

DATE ON LID 1-12-16

PRE-CONSTRUCTION:

INSTALLATION: 3/29/16 Second septic tank replaced with a 1500-gallon 2-compartment tank. Original 2nd tank was pumped, crushed, + removed. (SC)

FINAL INSPECTOR Sarah Collins DATE OF APPROVAL 3/29/16