

APPLICATION

SEWAGE DISPOSAL TESTING

STATE OF MARYLAND - DEPARTMENT OF HEALTH AND MENTAL HYGIENE

A 33785

P _____

HOWARD COUNTY HEALTH DEPARTMENT
ENVIRONMENTAL HEALTH SERVICES

P. O. BOX 476 ELLICOTT CITY, MARYLAND 21043
TELEPHONE: 992-2330

DISTRICT 512

DATE 4/13/84

*See separate sheet
for Revised specs
4/16/84 (B)*

TO: THE COUNTY HEALTH OFFICER
ELLICOTT CITY, MARYLAND

I, HEREBY, APPLY FOR THE NECESSARY TEST IN ORDER TO CONSTRUCT (OR RECONSTRUCT) A SEWAGE DISPOSAL SYSTEM.

PROPERTY OWNER Joseph Panichello

ADDRESS 1225 1/2 Folly Quarter Rd PHONE _____

PROPERTY LOCATION:
SUBDIVISION GLENELG MANOR II LOT NO. LOT 10 D

ROAD AND DESCRIPTION _____

SIZE OF LOT _____ TYPE BLDG. _____ (NUMBER OF BEDROOMS)

THE SYSTEM INSTALLED UNDER THIS APPLICATION IS ACCEPTABLE ONLY UNTIL PUBLIC FACILITIES BECOME AVAILABLE. I FULLY UNDERSTAND THE FEE CONNECTED WITH THE FILING OF THIS PERC TEST APPLICATION IS NON-REFUNDABLE UNDER ANY CIRCUMSTANCES. I ALSO AGREE TO COMPLY WITH ALL M.O.S.H.A. REQUIREMENTS IN TESTING THIS LOT.

(SIGNATURE OF APPLICANT)
APPROVED BY F. Shinn FOR franches DATE 4/16/84

REJECTED BY BH FOR _____ DATE 4/12/84

HOLD PENDING FURTHER TESTS _____ DATE _____



REASONS FOR REJECTION OR HOLDING : 4/12/84 - REJECT RETEST 3 Bldg.
4/12/84 Don Raver has not paid fee for this lot 97, 51 No
4/16/84 New plat on F.S.

BLDG. PERMIT SIGNED
AND RETURNED 9-17-84


THIS IS NOT A PERMIT

GLENELEW
MANOR II
LOT 10 D

W₂ WELL H0810265
ALREADY DRILLED

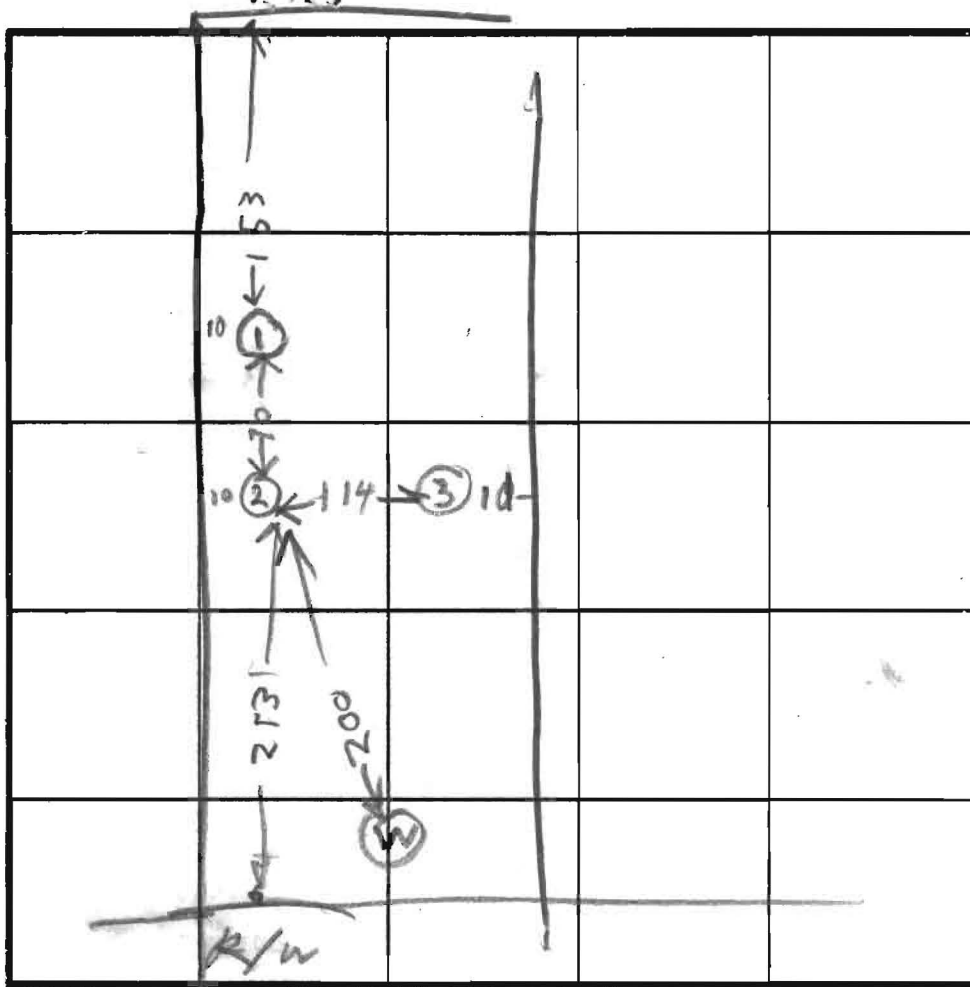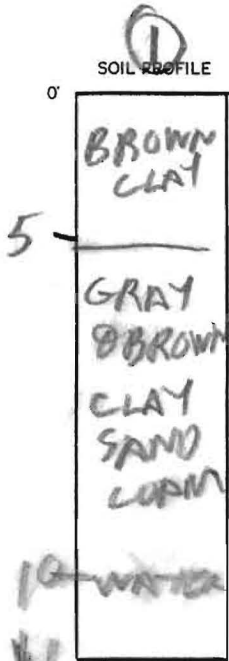

INDICATE NORTH - NAME ADJOINING ROADWAY AS BASE LINE.

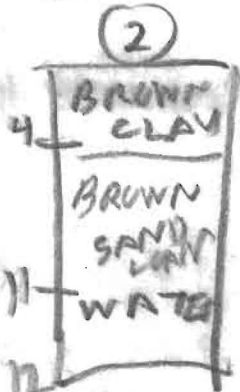


DATE	TEST NO.	DEPTH	PRE-WET		TEST - 1" DROP		TIME
			START	STOP	START	STOP	
4/12/04	1V	18	WATER		10 FT		
	2S	5 1/2	327	341	little pen		14
	2V	12	WATER		11 FT		
	3V	10	WATER		9 FT		

REMARKS _____

TYPE OF SOIL _____

TESTED BY _____ ALSO PRESENT _____

This plat supercedes perc plat approved March 20, 1979 by The Howard County Health Officer

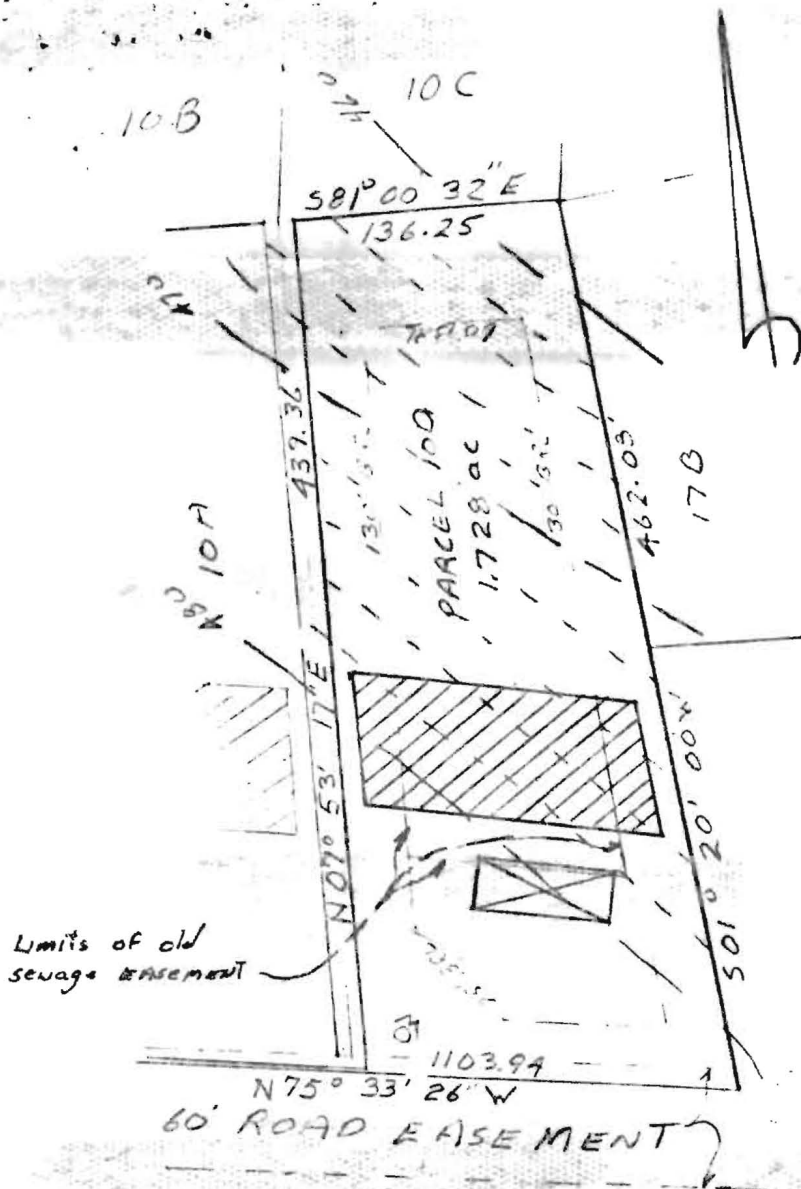

PERCOLATION TEST PLAT
 PARCEL 10-D
 GLENELG MANOR II

5th Election District
 Howard County, Maryland
 Scale 1"=100'
 Date 4/16/84

[Hatched Area] This area designates a private sewage easement of 10,000 square feet as required by the Maryland State Department of Health and Mental Hygiene for individual sewage disposal. Improvements of any nature in this area are restricted until public sewage is available. These easements shall become null and void upon connection to a public sewage system. The County Health Officer shall have the authority to grant variances for encroachments into the private sewage easement. Recordation of a modified sewage easement shall not be necessary.

Percolation test holes shown hereon have been field located and shown as "⊕".

The lots shown hereon comply with the minimum ownership width and lot areas as required by the Maryland State Department of Health and Mental Hygiene.

Percolation areas and water wells for adjoining lots have been shown where pertinent.

APPROVED: For Private Water and Private Sewage Systems

James C. Hudkins
 County Health Officer

4-17-84
 Date

NTT Associates
 101 Sterrett Place
 Columbia, MD 21044
 321-0307