

127/02
1100N
128/02
10-12

PUB. SEWER STATUS VERIFIED BY N/A

ISSUE DATE: 06/26/02
APPROVAL DATE: 2/1/02

PERMIT
05-358361

P 517329
A 24418
REPAIR

ON-SITE SEWAGE DISPOSAL SYSTEM
HOWARD COUNTY HEALTH DEPARTMENT
BUREAU OF ENVIRONMENTAL HEALTH

Zepp Plumbing & Heating IS PERMITTED TO INSTALL ALTER

ADDRESS: 6344 Ten Oaks Road PHONE NUMBER: 410-531-6712

SUBDIVISION: Glenelg Manor I LOT NUMBER: 4-A

ADDRESS: 12533 Folly Quarter Road PROPERTY OWNER: Michael Rolnick

SEPTIC TANK CAPACITY (GALLONS): Ex. 1000 gal

PUMP CHAMBER CAPACITY (GALLONS): _____

NUMBER OF BEDROOMS: 4

SQUARE FEET PER BEDROOM: 180

LINEAR FEET OF TRENCH REQUIRED: 140

TRENCHES:	Trench to be <u>3'</u> feet wide. Inlet <u>5'</u> feet below original grade. Bottom maximum depth <u>7'</u> feet below original grade. Effective area begins at <u>5.5'</u> feet below original grade. <u>2.0</u> feet of stone below distribution pipe.
LOCATION:	Existing septic system is failing. Call for inspection when ground is opened.
PURPOSE:	


PLANS APPROVED: _____ DATE: 4/22/02

- NOTE: PERMIT VOID AFTER 2 YEARS
- NOTE: CONTRACTOR RESPONSIBLE FOR SCHEDULING A PRE-CONSTRUCTION INSPECTION FOR ALL INSTALLATIONS
- NOTE: WATERTIGHT SEPTIC TANKS REQUIRED
- NOTE: ALL PARTS OF SEPTIC SYSTEM SHALL BE 100 FEET FROM ANY WATER WELL
- NOTE: MANHOLE RISERS REQUIRED ON ALL SEPTIC TANKS AND PUMP CHAMBERS

NEITHER THE HOWARD COUNTY COUNCIL NOR THE HEALTH DEPARTMENT IS RESPONSIBLE FOR THE SUCCESSFUL OPERATION OF ANY SYSTEM PERMITTEE RESPONSIBLE FOR OBTAINING FINAL APPROVAL ON THIS PERMIT CALL 410-313-2640 FOR INSPECTION OF SEPTIC SYSTEM

H 24418

NOT TO SCALE

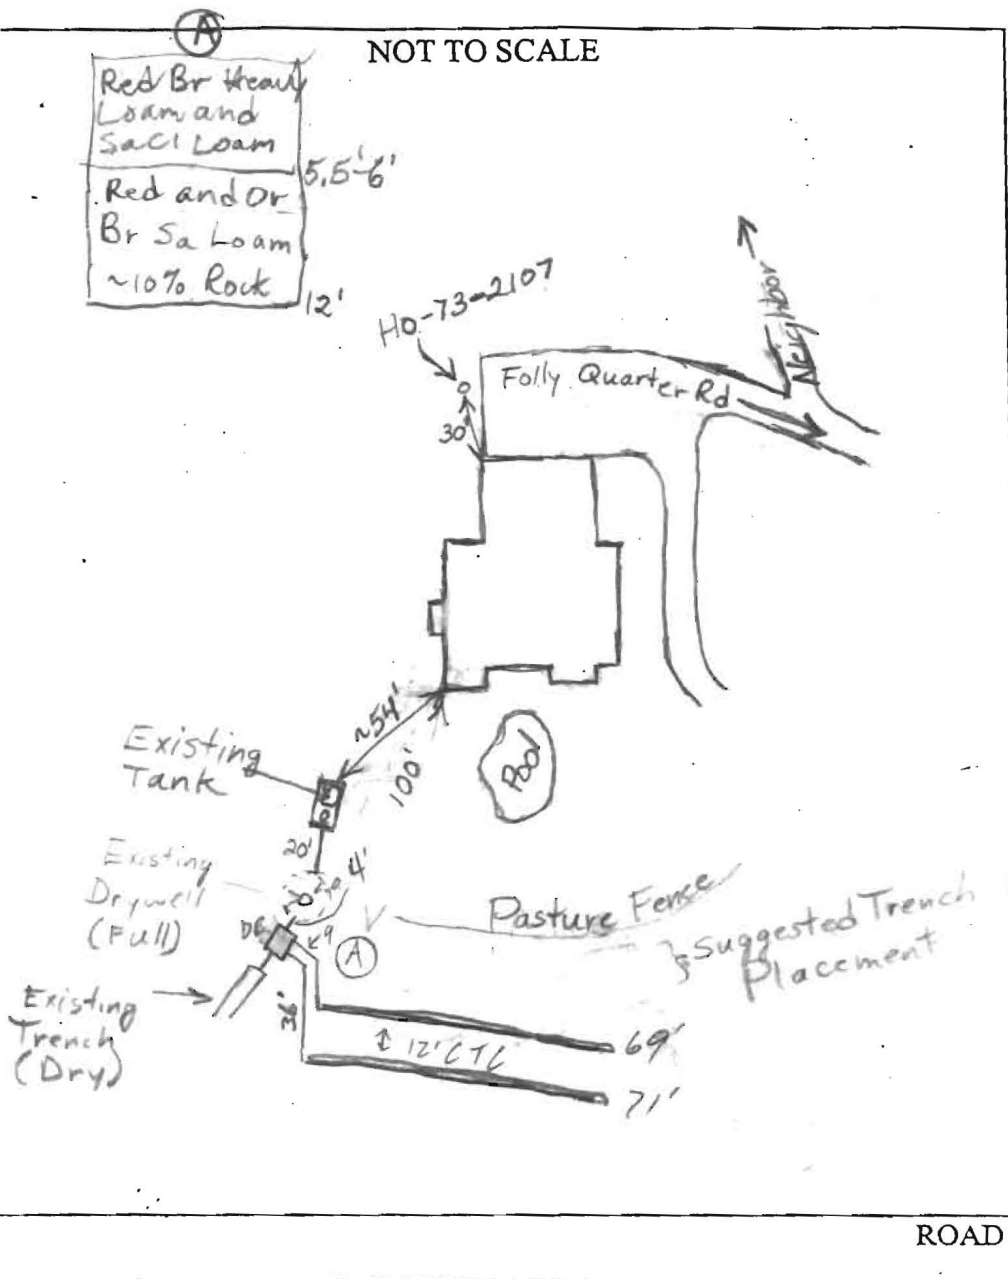

TRENCH/DRAINFIELD DATA		
WIDTH	INLET	BOTTOM
3	5	7
NUMBER OF TRENCHES		2
TOTAL LENGTH		140'
ABSORPTION AREA		420 sq ft
DISTRIBUTION BOX LEVEL		✓
DISTRIBUTION BOX BAFFLE		✓
DISTRIBUTION BOX PORT		—

SEPTIC TANK DATA	
SEPTIC TANK 1 LEVEL	Existing
CAPACITY	1000 GAL
SEAM LOC	?
TANK LID DEPTH	5'
BAFFLES	✓
BAFFLE FILTER	—
MANHOLE LOC	Front
6" PORT LOC	Back
WATERTIGHT TEST	—
SEPTIC TANK 2 LEVEL	N/A
CAPACITY	— GAL
SEAM LOC	—
TANK LID DEPTH	—
BAFFLES	—
BAFFLE FILTER	—
MANHOLE LOC	—
6" PORT LOC	—
WATERTIGHT TEST	—

PRE-CONSTRUCTION 6/27/02 To replace iron pipe between tank and drywell
 To install manhole riser on front of septic tank and 6" cleanout
 INSTALLATION on rear of tank. To place a distribution box after
 drywell and run lines to existing dry trench and two new
 trenches. Approximate trench layout shown above. (BB) 6/28/02
 Riser & Manhole on ST. DB placed between DW & existing trench.
 Ex trench to be used, is dry. Pipe going to trench was crushed OK to
 cover ST (50) OK to cover s/w work (50)

FINAL INSPECTOR [Signature] DATE OF APPROVAL 7/1/02