


SITE INSPECTION SHEET

OWNER: Tony Horwath. PHONE #: _____
 ADDRESS: 3210 Florence Rd. CONTRACTOR: Natfields
 WELL TAG #: HO-73-1125
 SUBDIVISION: Hickory Est. LOT: 3 COUNTY #: 13
 PROPOSAL: RP, submitted, Ex. system unknown @ the time.

LOCATION DIAGRAM

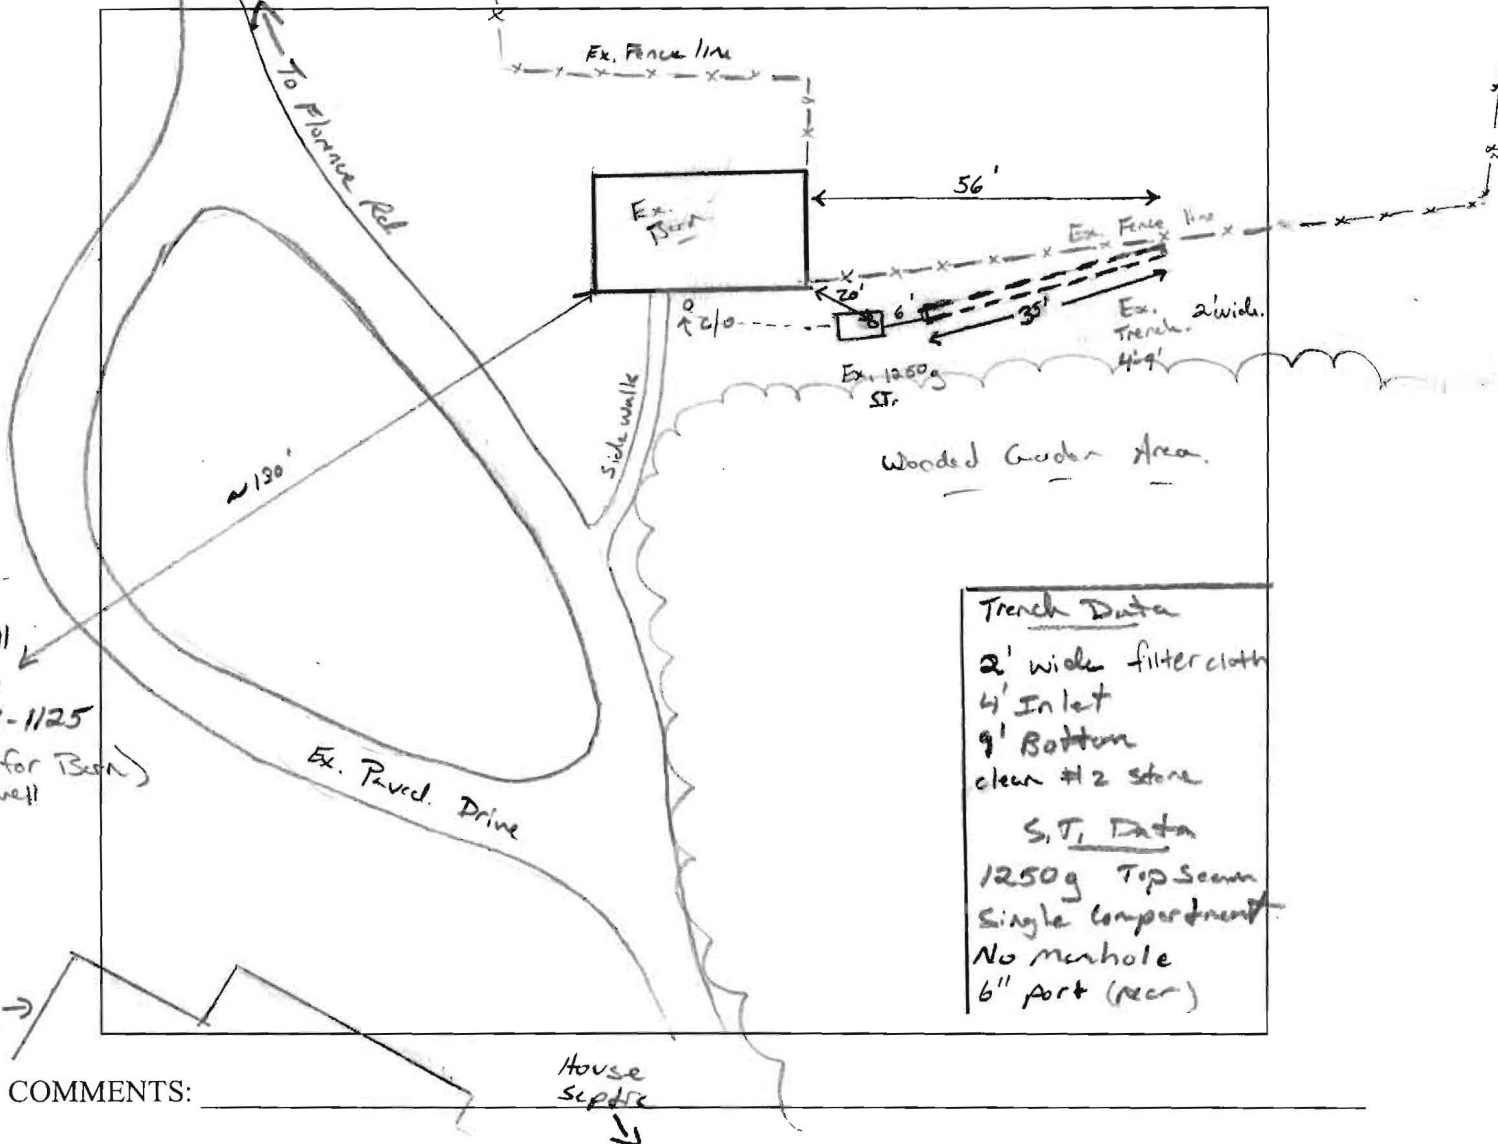

COMMENTS: _____

* See memo dated 4-7-11

DATE: 4-7-11 INSPECTOR: K. Wolf

