



17762 Hardy Road  
 Scale: 1" = 90'  
 Property Line  
 Building Restriction Line  
 → Lines to show measurements  
 Structural Markings  
 O - Well 1000 Gallon U/G LP Tank

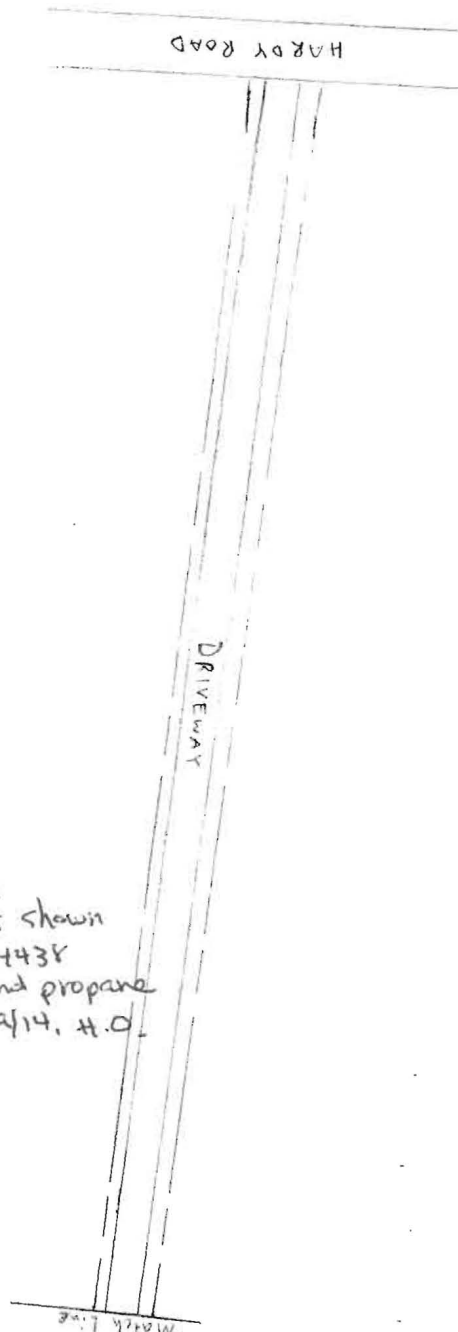

Site plan  
 Approved as shown  
 for B14004438  
 (underground propane  
 tank) 12/19/14. H.O.

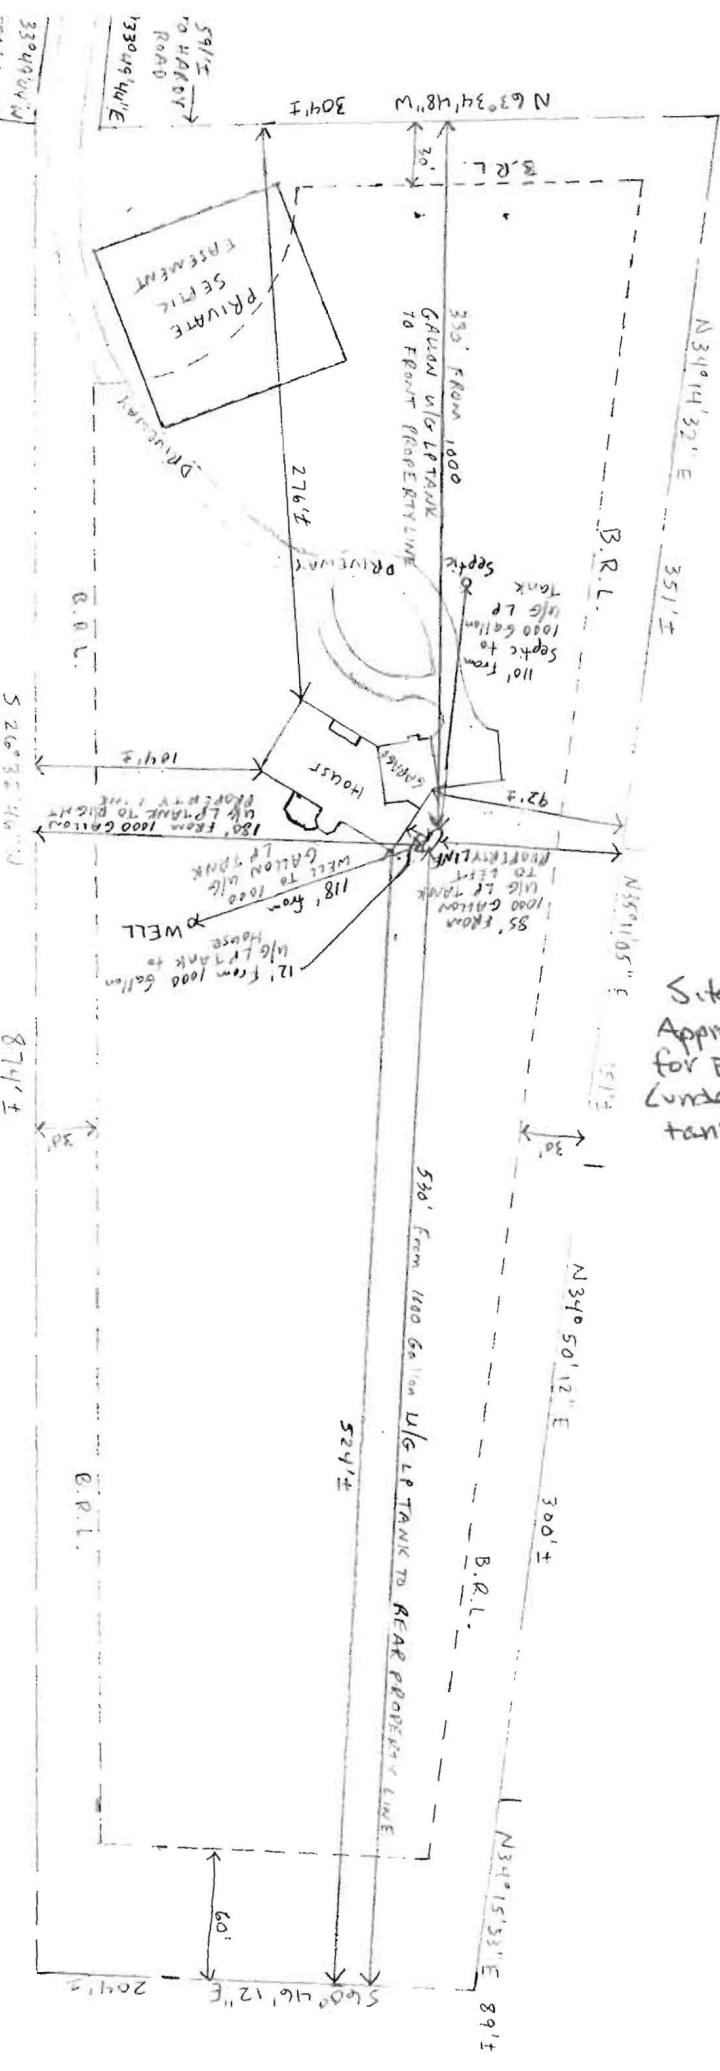

Match Line  
 339' 0" 0" W  
 786' ±  
 TO HARDY ROAD

339' 0" 0" W  
 786' ±  
 TO HARDY ROAD

591' ±  
 TO HARDY ROAD

N 63° 34' 48" W 304' ±

30' ±

355' FROM 1000 GALLON U/G LP TANK TO FRONT PROPERTY LINE

110' FROM SEPTIC TO U/G LP TANK

276' ±

HOUSE

180' FROM 1000 GALLON U/G LP TANK TO RIGHT PROPERTY LINE

118' FROM WELL TO 1000 GALLON U/G LP TANK

12' FROM 1000 GALLON U/G LP TANK TO HOUSE

N 55° 10' 05" E 151' ±

30' ±

530' FROM 1000 GALLON U/G LP TANK TO REAR PROPERTY LINE

N 34° 50' 12" E 300' ±

524' ±

B.R.L.

N 34° 15' 33" E 89' ±

89' ±

204' ±

S 60° 46' 12" E 60' ±

60' ±

874' ±

30' ±

874' ±

30' ±

874' ±

30' ±

874' ±

874' ±

30' ±

874' ±

