

\*\*\*\*\*  
 WATER WELL ABANDONMENT-SEALING REPORT FORM  
 \*\*\*\*\*

SUBMIT COPIES OF COMPLETED FORM TO:

- \* COUNTY ENVIRONMENTAL AGENCY (contact MDE, WMA if address needed)
- \* WELL OWNER
- \* MDE, WATER MANAGEMENT ADMINISTRATION, WELL PROGRAM

DATE WELL ABANDONED: 10/28/15 (month/day/year)

\* PERMIT NUMBER OF ABANDONED WELL (if any) \_\_\_\_\_

\* PERMIT NUMBER OF REPLACEMENT WELL: \_\_\_\_\_

\* PERSON ABANDONING WELL: ROBERT COPSEY WELL DRILLER'S LICENSE NUMBER: 161

CIRCLE: MWD / MSD / MGD


\* OWNER'S NAME: MG Renovations LLC

\* WELL LOCATION:  
 COUNTY: HOWARD  
 NEAREST TOWN: COLUMBIA  
 TAX MAP 0041 BLOCK \_\_\_\_\_ PARCEL 0194  
 SUBDIVISION: 0000  
 SECTION: \_\_\_\_\_ LOT: 10  
 STREET ADDRESS: 10614 Hunting Lane

LATITUDE 3 9 . 1 0 4 1 7 0

LONGITUDE 7 6 . 5 2 4 9 7 4

SITE LOCATION MAP

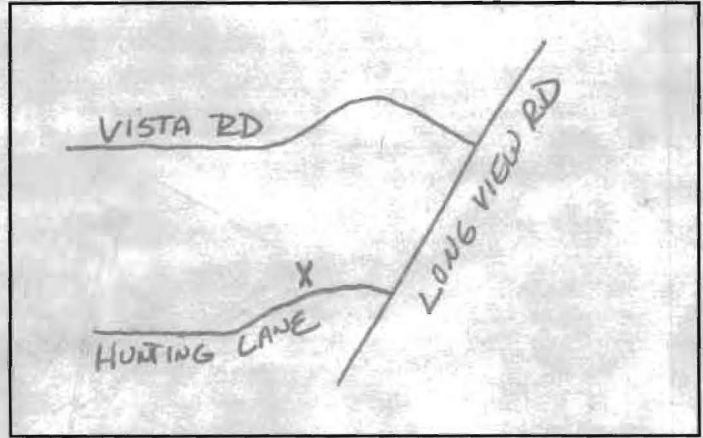

\* TYPE OF WELL BEING ABANDONED:  
 DRILLED  JETTED  
 BORED  HAND DUG  
 OTHER (specify) \_\_\_\_\_

\* USE CODE:  
 DOMESTIC  MUNICIPAL/PUBLIC  
 IRRIGATION  INDUSTRIAL  
 TEST/OBSERVATION  GEOTHERMAL

\* TYPE OF CASING:  
 STEEL  PLASTIC  
 CONCRETE  OTHER (specify) \_\_\_\_\_

SIZE OF CASING: 6" INCHES IN DIAMETER

DEPTH OF WELL: 74' FEET DEEP

WAS ANY CASING REMOVED?  YES  NO  
 If yes, length removed, in feet: \_\_\_\_\_

WAS CASING RIPPED OR PERFORATED?  YES  NO

LOG OF SEALING MATERIAL

MATERIAL	FEET	
	FROM	TO
Bentonite Clay	74	4'
VOLUME OF MATERIAL USED		
65lbs BENTONITE CLAY.		

SIGNATURE-MASTER WELL DRILLER OR SUPERVISING SANITARIAN Robert P. Copsey LICENSE# 161

MWD / MSD / MGS 10/28/15  
 CIRCLE ONE DATE

COUNTY