

Fogles Well DRIVING

443-609-4195

MARYLAND DEPARTMENT OF THE ENVIRONMENT, WATER MANAGEMENT ADMINISTRATION
1800 Washington Blvd., Baltimore, Maryland 21230 (410) 537-3784

WATER WELL ABANDONMENT-SEALING REPORT FORM

SUBMIT COPIES OF COMPLETED FORM TO:

- * COUNTY ENVIRONMENTAL AGENCY (contact MDE, WMA if address needed)
- * WELL OWNER
- * MDE, WATER MANAGEMENT ADMINISTRATION, WELL PROGRAM

DATE WELL ABANDONED: 10/25/13 (month/day/year)

* PERMIT NUMBER OF ABANDONED WELL (if any)

HO-73-4393

* PERMIT NUMBER OF REPLACEMENT WELL:

HO-94-3102

* PERSON ABANDONING WELL: Allen Compton WELL DRILLER'S LICENSE NUMBER: 009

CIRCLE: MWD (MSD/MGD)

* OWNER'S NAME: ROBERT KENDEZE-JESK


* WELL LOCATION:

COUNTY: HOWARD
 NEAREST TOWN: ELLICOTT CITY
 TAX MAP 078 BLOCK 000 PARCEL 0238
 SUBDIVISION: Glencles Manor
 SECTION: _____ LOT: 17D
 STREET ADDRESS: 12767 Folly Quarter Rd

LATITUDE 39.248863

LONGITUDE 76.957675

SITE LOCATION MAP

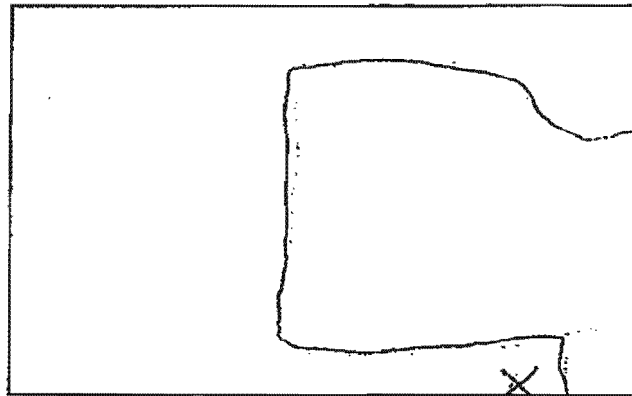

Allen Compton

* TYPE OF WELL BEING ABANDONED:
 DRILLED JETTED
 BORED HAND DUG
 OTHER (specify) _____

* USE CODE: DOMESTIC MUNICIPAL/PUBLIC
 IRRIGATION INDUSTRIAL
 TEST/OBSERVATION GEOTHERMAL

* TYPE OF CASING:
 STEEL PLASTIC
 CONCRETE OTHER (specify) _____

SIZE OF CASING: 6 INCHES IN DIAMETER

DEPTH OF WELL: 300 FEET DEEP

WAS ANY CASING REMOVED? YES NO
If yes, length removed, in feet: _____

WAS CASING RIPPED OR PERFORATED? YES NO

LOG OF SEALING MATERIAL

MATERIAL	FEET	
	FROM	TO
<u>Cement</u>	<u>0</u>	<u>300</u>

VOLUME OF MATERIAL USED

2.5 YARDS

Fogle's Well Drilling, LLC
 Woodbine, Maryland 21797
 P.O. Box 202
 Woodbine, Md 21797
 (443)609-4195

Invoice

Date	Invoice #
10/28/2013	10392275

Job Location:

Glenelg Manor Lot# 17 D
 12767 Folly Quarter Rd
 Ellicott City, Md 21042

Bill To:

Robert Kendezejeski
 15253 Callaway Ct
 Glenwood, Md 21738

Amount of Remittance

P.O. Number	Terms	Project	**1-1/2% Late charge due on balances outstanding more than 15 days from date of invoice** (18% per annum)			
	C.O.D.	12767 Folly Quarter Rd				
Quantity	Description	U/M	Price Each	Serviced	Amount	
1	Abandon 300' deep Well{HO-73-4393} per State & County Regulations. *Mail abandonment report to the County & State. Replacement Well: Well Tag# HO-94-3102, 320' Deep & Produces 11gpm when drilled. *Paperwork will be mailed once final payment is made.		1,250.00	10/25/2013	1,250.00	
It's been a pleasure working with you!! 24Hr Septic Service{410-795-5670}			Total		\$1,250.00	
			Payments/Credits			
			Balance Due		\$1,250.00	