

Dr. Peter Beilenson, M.D., M.P.H., Health Officer

## DEMOLITION REQUEST FORM

(Please fill in all blanks)

### Information of Property to be Demolished:

CM Higdon LC 16883 Scaggsville Rd 20723  
Current Owner's Name Property Address

Higdon Eula P Trustee 0046 0056 06 406378  
Subdivision (if applicable) Lot #  
All Prior Owners' Names (if requested or known) Tax Map Parcel # Tax ID #

Future Development  
Purpose/Reason for Demolition

Clean & Green For Now / Future development by others  
Future plans of property after demo (i.e. subdivision, parking lot, re-build new house, etc...)

If a subdivision, SDP# NA Has the structure(s) been deemed unsafe by DILP YES  NO

### UTILITY RECORDS:

Property currently connected to public water  YES  NO

Property currently connected to public sewer  YES  NO

Does the property currently have any wells and/or septic systems  YES  NO  
→ Explain: Fogels septic pumped septic 6-12 abandoned Receipt Attached  
Hand dug well was abandoned by Barlow well Report Attached

\*Note: Any wells and/or septic systems that are to remain may require an approved percolation certification plan under Howard County Code Sec. 3.805

\*Note: Any septic systems that are to be abandoned must be done by a septic contractor with documentation of the process.

\*Note: All abandoned wells are to be sealed by a well driller licensed by the Maryland State Board of Well Drillers COMAR Sec 26.04.04.11 Abandonment Standards D (3)

### COMMENTS:

Mark J Slowinski / Gr12  
Applicant's Name (please print)

Slowinski1@verizon.net  
Applicant's Email

Mark J Slowinski  
Applicant's Signature

410 215 1444  
Applicant's Phone #

410 592 2739  
Applicant's Fax #

8-27-2013  
Date

# Fogle's Septic Clean, Inc.

580 Obrecht Road  
 Sykesville, MD 21784  
 410-795-5670

# WORK ORDER

Date	8/19/2013
------	-----------

## JOB LOCATION

10883 SCAGGSVILLE RD  
 LAUREL, MD 20724

## Name / Address

GRIZ  
 MARK SLOWINSKI  
 3902 SWEET AIR RD  
 PHOENIX, MD 21131

Customer Phone	410 215-1444
----------------	--------------

A finance charge of 1.5% will be charged monthly on unpaid balances. And any actual and reasonable collection fees may be added if delinquent. There is a \$25 fee for a returned check.

We are not responsible for your cleanout cap if we break it when we remove it. We are not responsible for any damages to your driveway.

Description	Qty	Cost	Total
PUMP SEPTIC TANK - RIGHT SIDE PAID CC		280.00	280.00

Manhole Access YES <input checked="" type="checkbox"/> NO <input type="checkbox"/> Depth of Tank <u>2</u>
---

TO ENSURE PROPER CLEANING, FOGLE'S SEPTIC RECOMMENDS PUMPING FROM THE MANHOLE AND NOT THE 6" CLEANOUT
--

Thank you for your business.	<i>Harry</i>	<b>Total</b>	\$280.00
------------------------------	--------------	--------------	----------

Customer Signature \_\_\_\_\_

MARYLAND DEPARTMENT OF THE ENVIRONMENT, WATER MANAGEMENT ADMINISTRATION  
1800 Washington Blvd., Baltimore, Maryland 21230 (410) 537-3784

WATER WELL ABANDONMENT-SEALING REPORT FORM

SUBMIT COPIES OF COMPLETED FORM TO:

- COUNTY ENVIRONMENT AGENCY (contact MDE, WMA if address needed)
- WELL OWNER
- MDE, WATER MANAGEMENT ADMINISTRATION, WELL PROGRAM

DATE WELL ABANDONED: 8/19/13 (month/day/year)

PERMIT NUMBER OF ABANDONED WELL (if any) \_\_\_\_\_

PERMIT NUMBER OF REPLACEMENT WELL \_\_\_\_\_


PERSON ABANDONING WELL: Michael Isom

WELL DRILLERS LICENSE NUMBER: 162

CIRCLE: MWD (MSD) MGD

OWNER'S NAME: Griz

WELL LOCATION:  
 COUNTY: HOWARD  
 NEAREST TOWN: LAUREL  
 TAX MAP 46 BLOCK 11 PARCEL 56  
 SUBDIVISION: \_\_\_\_\_  
 SECTION: \_\_\_\_\_ LOT: \_\_\_\_\_  
 NEAREST ROAD: 10883 Scaggsville Road

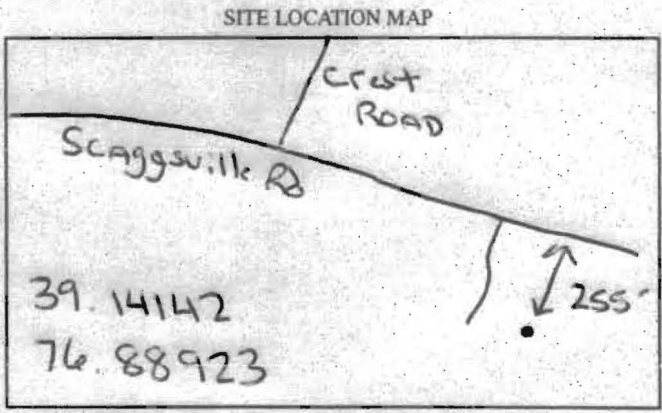

TYPE OF WELL BEING ABANDONED:

- \_\_\_\_\_ DRILLED \_\_\_\_\_ JETTED
- \_\_\_\_\_ BORED/AUGERED  HAND DUG
- \_\_\_\_\_ OTHER (specify) \_\_\_\_\_

USE CODE:

- DOMESTIC \_\_\_\_\_ MUNICIPAL/PUBLIC
- \_\_\_\_\_ IRRIGATION \_\_\_\_\_ INDUSTRIAL
- \_\_\_\_\_ TEST/OBSERVATION \_\_\_\_\_ GEOTHERMAL

TYPE OF CASING:

- \_\_\_\_\_ STEEL \_\_\_\_\_ PLASTIC
- \_\_\_\_\_ CONCRETE  OTHER (specify) Stone

SIZE OF CASING: 36 INCHES IN DIAMETER

DEPTH OF WELL: 42 FEET DEEP

WAS ANY CASING REMOVED? \_\_\_\_\_ YES  NO  
if yes, length removed, in feet: \_\_\_\_\_

WAS CASING RIPPED OR PERFORATED? \_\_\_\_\_ YES  NO

LOG OF SEALING MATERIAL

MATERIAL	FEET	
	FROM	TO
Stone	42	5
Cement	5	2
Soil	2	0

VOLUME OF MATERIAL USED

SIGNATURE-MASTER WELL DRILLER OR SUPERVISING SANITARIAN \_\_\_\_\_

162 LICENSE #

MWD (MSD) MGD  
CIRCLE ONE

8/20/13 DATE

FAX

GRIZ

3902 Sweet Air Road  
Phoenix, Maryland 21131  
410-592-9425  
Fax 410-592-2739

DATE: 9-12-2013TO: Howard Co Health Dept  
Well & Septic ProgramATTENTION: Jeffrey WilliamsFAX# 410-319-2648Please look for 1 pages

## Comments

When Griz abandones a concrete septic tank  
in place, it is dug up & crushed so there  
will not be any "bath tub" effect, then  
the area is made safe. That is how  
we handled 10883 Scaggsville Rd  
The future site contractor will  
~~that~~ take care of the final  
grading

From

Mike J. Shrink -