

APPLICATION

A 16938

P _____

SEWAGE DISPOSAL TESTING

MARYLAND STATE DEPARTMENT OF HEALTH

HOWARD COUNTY

ELLICOTT CITY

DISTRICT Fourth

DATE 4-18-72

TO: THE COUNTY HEALTH OFFICER
ELLICOTT CITY, MARYLAND

I, HEREBY, APPLY FOR THE NECESSARY TESTS IN ORDER TO CONSTRUCT (OR RECONSTRUCT) A SEWAGE DISPOSAL SYSTEM.

PROPERTY OWNER Gerald R. Baker
ADDRESS 4885 Avoca Ave., Ellicott City PHONE 465-4364

PROPERTY LOCATION:

SUBDIVISION _____ LOT NO. _____

ROAD AND DESCRIPTION located on west side of Florence road approximately 300 ft. north of New Cut road.

OCCUPANT _____ PHONE _____

PERSON TO CONSTRUCT SYSTEM _____

ADDRESS _____ PHONE _____

SIZE OF LOT 14.133 acres TYPE BLDG. Rambler, 3 bedrooms
NUMBER OF BEDROOMS

IF NOT SINGLE RESIDENCE DESCRIBE _____

SIGNATURE OF APPLICANT Gerald R. Baker


APPROVED BY DW Morgan FOR Dry Well DATE 5-16-72
(KIND OF SYSTEM)

REJECTED BY _____ FOR _____ DATE _____
(KIND OF SYSTEM)

HOLD PENDING FURTHER TESTS _____ DATE _____

REASONS FOR REJECTION OR HOLDING _____

THIS IS NOT A PERMIT

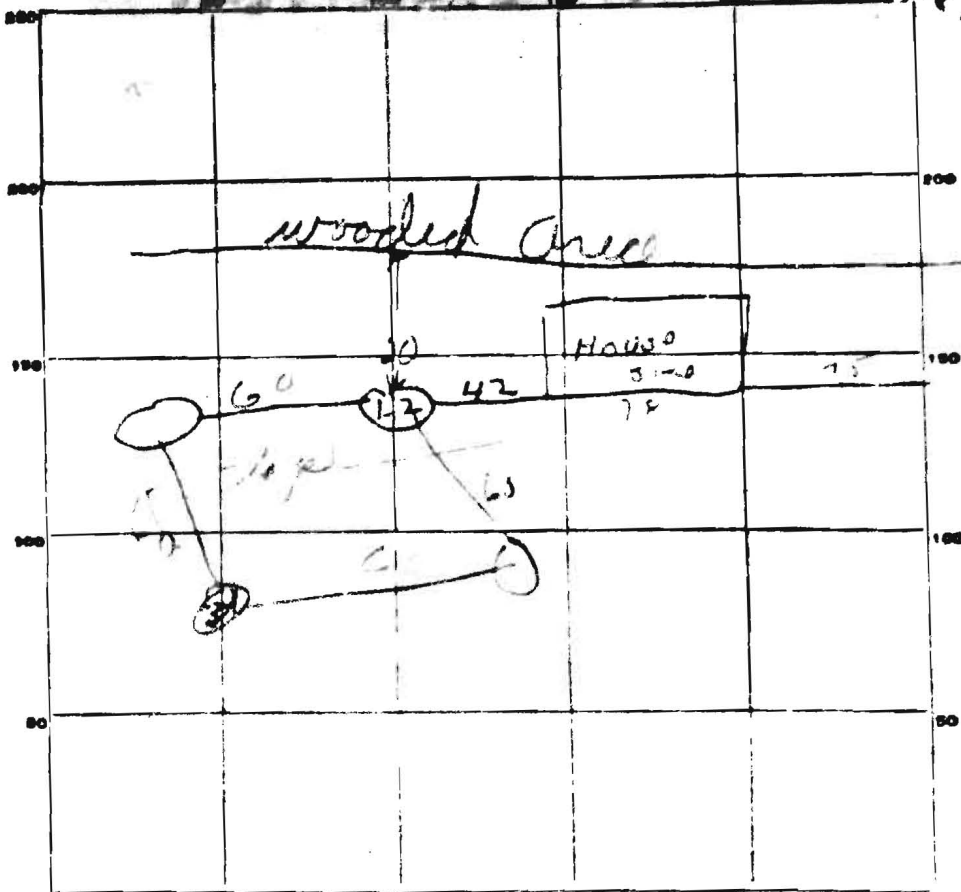

INDICATE NORTH - NAME ADJOINING ROADWAY AS BASE LINE.

DATE	TEST NO	DEPTH	PRE-WET		TEST - 1" DROP		TIME
			START	STOP	START	STOP	
5-16-72	1	1 1/2 ft	10 26	10 37	10 37	10 51	20 min
	2	11 ft	10 37	10 32	10 32	10 41	9 min
	3	4 ft	10 40	10 42	10 42	10 52	15 min
	4	14 ft	10 40	10 44	10 44	10 55	11 min

SOIL AUGER FINDING

TESTED BY

Dum

REMARKS

