

11/10/72
after 17 hours

PERMIT

11/10/72
207

P. 17531
A 16932

SEWAGE DISPOSAL SYSTEM

MARYLAND STATE DEPARTMENT OF HEALTH

HOWARD COUNTY

ELLICOTT CITY

DISTRICT 4th

INDEXED

DATE 10/6/72

Edward Pickett IS PERMITTED TO INSTALL X ALTER

ADDRESS Hatersville Road, Mt. Airy, Md. PHONE 822-0543

A SEWAGE DISPOSAL SYSTEM LOCATED AT _____

SUBDIVISION _____ ROAD ¹⁷³⁰ Lorraine Road - see 20211 lot

PROPERTY OWNER Gerald R. Baker section for directions

ADDRESS 4885 Avoca Avenue, Ellicott City, Md.

SPECIFICATIONS 3 bedrooms

DRAIN FIELD _____ DEPTH _____ FEET, BOTTOM AREA _____ SQ. FT.

SEEPAGE PITS _____ ABSORBENT SIDE-WALL AREA _____ SQ. FT.

SEPTIC TANK CAPACITY 1000 GALLONS

FOR GARBAGE GRINDER, INCREASE DISPOSAL AREA 25% & TANK CAPACITY 50%.

OTHER DRY WELL - 429 sq. ft. absorbent sidewall area to begin below the first 4 ft. of non-porous ground. Maximum depth permitted for dry well is 13 ft. below original grade. Suggest pit to be dug 14 sq. ft. - set block and top for 12 ft. diameter and fill in rest of pit with gravel. Dry well to have 8 ft. effective area below the first 4 ft. of non-absorbent ground. Place the dry well about 21 ft. from edge of woods and 195 ft. from right sideline as seen when facing lot from Florence Road.

PERMIT VOID AFTER THREE YEARS

NOTE: ALL PIPE FROM HOUSE TO SEPTIC TANK MUST BE CEMENT INCH.

NOTE: INSTALL STAND PIPE ON SEPTIC TANK AND DRY WELL.

PLANS APPROVED BY Donald W. Mordoch DATE 5/16/72

FILL SEPTIC TANK AND DISTRIBUTION BOX WITH WATER BEFORE CALLING FOR AN INSPECTION. COVER NO WORK UNTIL INSPECTED AND APPROVED.

NEITHER THE HOWARD COUNTY COMMISSIONERS NOR THE HEALTH DEPARTMENT IS RESPONSIBLE FOR THE SUCCESSFUL OPERATION OF ANY SYSTEM.

BLDG. PERMIT SIGNED
AND RETURNED 7/29/81
#47346 for Solar space addition

A 16932


15031
8000

PERMIT
WASTE DISPOSAL SYSTEM
KANSAS STATE DEPARTMENT OF HEALTH

BLUICOTT CITY DISTRICT

INDEXED

15
16
15
14
60
7 1/2 ft
630
0 1/2
628 1/2

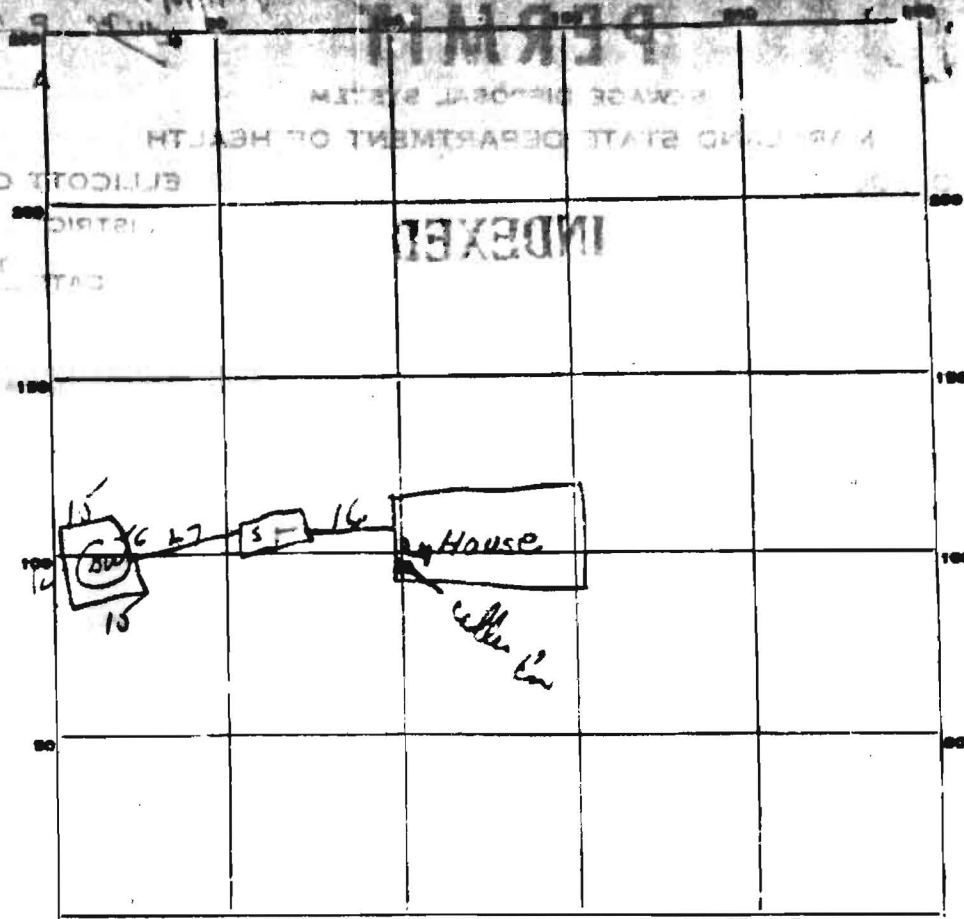

INDICATE NORTH. - NAME ADJOINING ROADWAY AS BASE LINE.

Florence St

PERMIT CARD 014

SEPTIC TANK, LEVEL _____ CLEANOUTS 014

DISTRIBUTION BOX, LEVEL _____

TILE FIELD, DEPTH _____ FT. TRENCH WIDTH _____ FT.

GRAVEL DEPTH _____ IN. TOTAL LENGTH _____ FT.

NUMBER OF TRENCHES _____ TOTAL BOTTOM AREA _____

SEEPAGE PITS, INSIDE DIAMETER 60 FT. DEPTH BELOW INLET 7 1/2 FT.

ABSORBENT AREA 450 SQ. FT. +

REMARKS _____

DATE SYSTEM APPROVED 11/14/22

INSPECTOR W. M. M...