

Feb 10 1989
1:30
Ppd on 2/2/89 H/O

APPLICATION

SEWAGE DISPOSAL TESTING

STATE OF MARYLAND - DEPARTMENT OF HEALTH AND MENTAL HYGIENE

A 43483
P _____

HOWARD COUNTY HEALTH DEPARTMENT
ENVIRONMENTAL HEALTH SERVICES

P. O. BOX 476 ELLICOTT CITY, MARYLAND 21043
TELEPHONE: 992-2330

DISTRICT 5th

DATE Jan. 12, 1989

TO: THE COUNTY HEALTH OFFICER
ELLICOTT CITY, MARYLAND

I, HEREBY, APPLY FOR THE NECESSARY TEST IN ORDER TO CONSTRUCT (OR RECONSTRUCT) A SEWAGE DISPOSAL SYSTEM.

PROPERTY OWNER Mat-Pet Partnership WARREN MATZEN
ADDRESS 10415 47th Avenue Beltsville PHONE (301) 937-4730
⁹³⁷⁻³³⁶⁶

PROPERTY LOCATION:

SUBDIVISION Hall Shop Estates LOT NO. 23
ROAD AND DESCRIPTION Intersection of MD. Rte 108 and Hall Shop Road
Southwest Corner (13047 Hall Shop Road)
SIZE OF LOT 17 ac ± TYPE BLDG. Single Family Dwlg. 4 Bdrms.
(NUMBER OF BEDROOMS)

THE SYSTEM INSTALLED UNDER THIS APPLICATION IS ACCEPTABLE ONLY UNTIL PUBLIC FACILITIES BECOME AVAILABLE. I FULLY UNDERSTAND THE FEE CONNECTED WITH THE FILING OF THIS PERC TEST APPLICATION IS NON-REFUNDABLE UNDER ANY CIRCUMSTANCES. I ALSO AGREE TO COMPLY

WITH ALL M.O.S.H.A. REQUIREMENTS IN TESTING THIS LOT. WARREN MATZEN Wm Matzen
(SIGNATURE OF APPLICANT)

APPROVED BY _____ FOR _____ DATE _____

REJECTED BY _____ FOR _____ DATE _____

HOLD PENDING FURTHER TESTS _____ DATE _____

REASONS FOR REJECTION OR HOLDING 2-10-89 P.ue Satisfactory, hold for certified plat. S. Alud

BLDG. PERMIT SIGNED
AND RETURNED 9/18/92
Serial# 45387 - SFD
3 Bedroom

THIS IS NOT A PERMIT

A-43483

LOT 1


SOIL PROFILE

0
10"
2.5'
3'
12.5'

AP 11x

STRONG BROWN
MICACEOUS
SILTY LOAM
15-21%
CLAY

Yellow Bd.
w/ PINK
CASTS
Highly
MICACEOUS
20-30%
COARSE
FRAGS

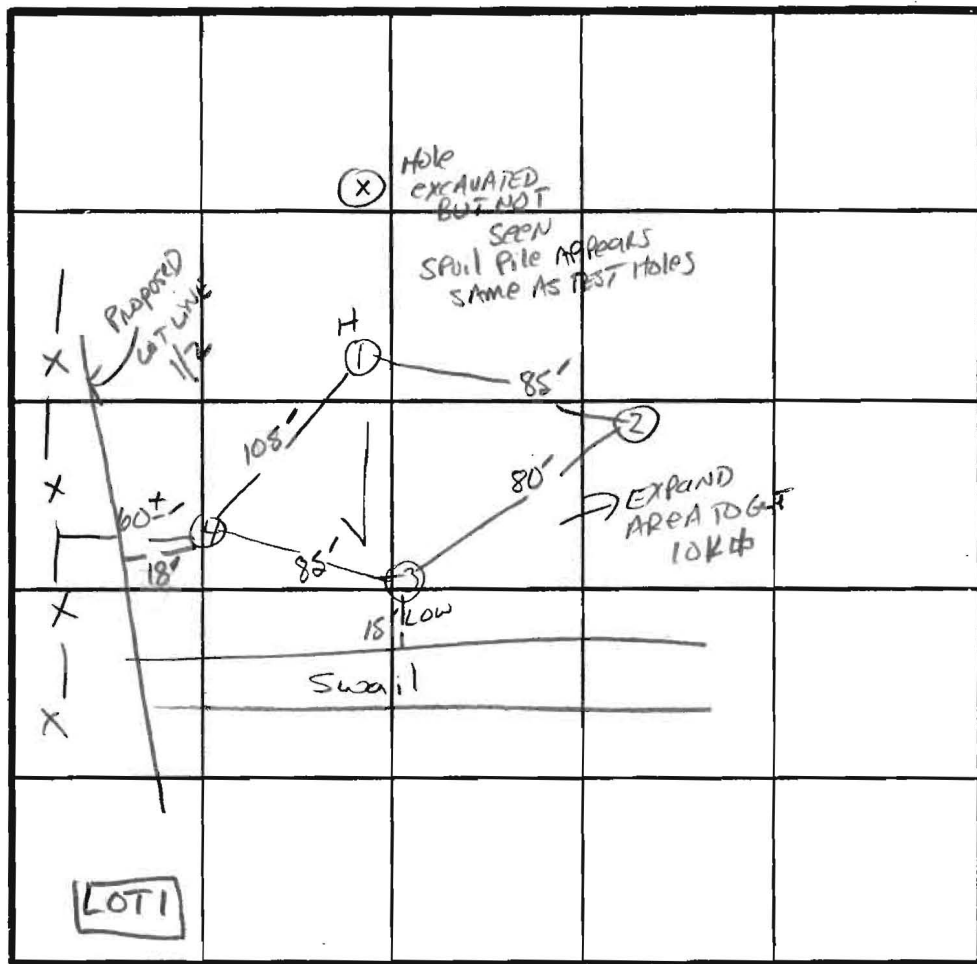

Rt 108

X Perc 8 min

210 #

Inlet 3'
Bottom 7'

INDICATE NORTH - NAME ADJOINING ROADWAY AS BASE LINE.

Hall Shop Rd.

DATE	TEST NO.	DEPTH	PRE-WET		TEST - 1" DROP		TIME
			START	STOP	START	STOP	
2/10/89	1S	3.0'	12:58	1:02	1:02	1:10	8 min
		8.0'	12:58	1:01	1:01	1:07	6 min
	1V	12.5'	AS profiled				
	2V	13'	SAME AS profile				
	3S	3'	1:03	1:09	1:09	1:20	11 min
	3V	12.5'	SAME AS profile				
	4S	3'	1:07	1:11	1:11	1:16	5 min
	4V	12'	SAME AS profile		UPPER AREA	30% frags	

REMARKS PERCED AS STAKED - NOT SURE IF SAME AS PLAT.

TYPE OF SOIL MANOR LOAM

TESTED BY S. Noel ALSO PRESENT OWNERS, D.K.