

2 inspections
10/8/76
4:30 - trench inspection
P.M. HOWARD COUNTY
11/2/75
2/27/76
Cancelled permit!!
11/2/75 -
9:20

PERMIT

SEWAGE DISPOSAL SYSTEM

P 21572

A _____

MARYLAND STATE DEPARTMENT OF HEALTH

HOWARD COUNTY

10/15/76

INDEXED

ELLICOTT CITY

DISTRICT 6th

DATE 5/29/75

Barry Allan Kessler

IS PERMITTED TO INSTALL _____ ALTER

ADDRESS 10668 Harding Road, Bx Laurel, Maryland PHONE 953-7380

A SEWAGE DISPOSAL SYSTEM LOCATED AT _____

SUBDIVISION _____ ROAD 10668 Harding Road LOT _____

PROPERTY OWNER Barry Allan Kessler

ADDRESS same as above

SPECIFICATIONS

DRAIN FIELD _____ DEPTH _____ FEET, BOTTOM AREA _____ SQ. FT.

SEEPAGE PITS _____ ABSORBENT SIDE-WALL AREA _____ SQ. FT.

SEPTIC TANK CAPACITY _____ GALLONS

FOR GARBAGE GRINDER, INCREASE DISPOSAL AREA 22% & TANK CAPACITY 30%.

OTHER REPAIR - Wall for inspection when ground is opened up so Sanitarian

can recommend repair system. DEEP DITCH 8' x 9' x 7' deep

1 1/2" dia 90 ft line filled with 4" stone
PUT WELL RINGS IN DITCH SO IT CAN BE PUMPED
OUT. DIE TANK OPEN FOR INSPECTION

PLANS APPROVED BY Palmer F. Wine DATE 5/29/75

REPAIR IT IF NEEDED, PLACE DITCH
FILL SEPTIC TANK AND DISTRIBUTION BOX WITH WATER BEFORE CALLING FOR AN INSPECTION, COVER NO WORK
UNTIL INSPECTED AND APPROVED. OFF OLD DRY WELL & MAKE


SURE DITCH IS 7.5 FT
NEITHER THE HOWARD COUNTY COMMISSIONERS NOR THE HEALTH DEPARTMENT IS RESPONSIBLE FOR THE
SUCCESSFUL OPERATION OF ANY SYSTEM. OR MORE PIPING

WATER WELLS 2 INSPECTION
OF DITCH NEEDED

5/21/76 - Trench length changed to 50 ft. per D. W. M. / R.
Mr. Kessler stated that public sewers will be there in
a year and a half.

P 21572

A 21572

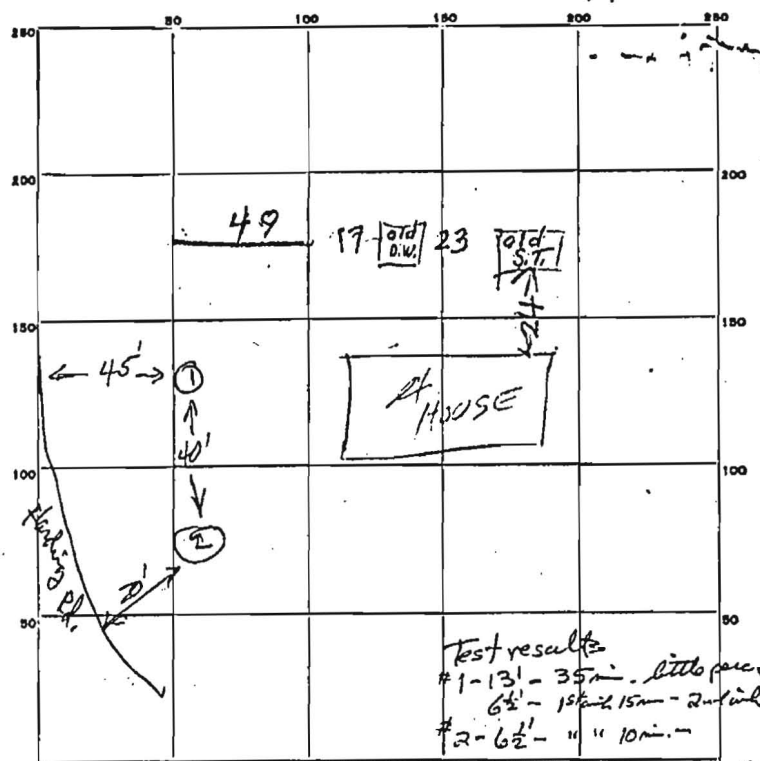

INDICATE NORTH. - NAME ADJOINING ROADWAY AS BASE LINE
 11' - all clay, no water PITS

PERMIT CARD _____

SEPTIC TANK, LEVEL _____ CLEANOUTS _____

DISTRIBUTION BOX, LEVEL _____

TILE FIELD, DEPTH 9 FT. TRENCH WIDTH 2 FT.

GRAVEL DEPTH 4-5 FT. IN. TOTAL LENGTH 49 FT.

NUMBER OF TRENCHES 1 ONE SIDE TOTAL BOTTOM AREA 196-245

SEEPAGE PITS, INSIDE DIAMETER _____ FT. DEPTH BELOW INLET _____ FT.

ABSORBENT AREA _____ SQ. FT.

REMARKS AM 10/15/76 - Add 9" PVC Pipe Cleanout
PM 10/15/76 145 - Put Pipe in Ditch & Cover
Ditch. Now Connect DW to ditch & Put
cleanout on dry Well & Call for Inspector RH

DATE SYSTEM APPROVED 1/24/78 ~~(signature)~~ INSPECTOR T.S. Oyle