

FOUNTAIN VALLEY ANALYTICAL LABORATORY, INC.

1413 Old Taneytown Rd., Westminster, MD (410) 848-1014 (410) 876-4554 FAX (410) 848-0298

REPORT OF ANALYSIS

Laboratory ID #:	66898	Account #:	10175
Reference:	Marsha Engel	Company:	CASH ACCOUNT
Location:	11036 Harding Road Laurel, MD 20723	Requested By:	Marsha Engel
Date/ Time Collected:	3/10/2008 1240	Source:	Well Water
Date/Time Rec'd:	3/10/2008 1530	Site:	Kitchen Sink Tap
Chlorine ppm:	Free: ND Total: ND	Treatment:	Sediment Filter
Collected By:	B. Dutterer 4717BD	pH:	5.4
		Well #:	No Tag

PARAMETERS	RESULTS	UNITS	REFERENCE	METHOD	DATE/TIME/ANALYST
Bacteria, Coliform, Total, MPN	<1.0	MPN/ 100 ml	<1.0	SM18 9223 B.	3/11/2008 / 0940 / AD/BD
Bacteria, E. coli, MPN	<1.0	MPN/ 100 ml	<1.0	SM18 9223 B.	3/11/2008 / 0940 / AD/BD
Nitrate	<1.0	mg/L	10	601	3/11/2008 / 1030 / AD/BD
Turbidity	0.59	NTU	<10	SM18 2130B	3/11/2008 / 0915 / AD/BD
Sand	NS	mg/L	5	Visual/Gravimct	3/11/2008 / 0915 / AD/BD

NOTES

- 1 mg/L = milligrams per liter (also, parts per million)
- 2 MPN/ 100 ml = Most Probable Number [of viable bacteria] per 100 ml of sample.
- 3 NS = None Seen (NS indicates less than 5 mg/L)
- 4 NTU - Nephelometric Turbidity Units
- 5 Results less than or within the reference range are considered satisfactory and within potable water limits at the time of sampling.
- 6 ND:None Detected
- 7 Visual well check: Sealed, vented cap
- 8 pH tested on-site

Reason for Test : Use & Occupancy

Date Reported: 3/11/2008

 WATER WELL ABANDONMENT-SEALING REPORT FORM

SUBMIT COPIES OF COMPLETED FORM TO:

- * COUNTY ENVIRONMENT AGENCY (contact MDE, WMA if address needed)
- * WELL OWNER
- * MDE, WATER MANAGEMENT ADMINISTRATION, WELL PROGRAM

DATE WELL ABANDONED: 3/25/08 (month/day/year)

* PERMIT NUMBER OF ABANDONED WELL (if any) N/A


* PERMIT NUMBER OF REPLACEMENT WELL _____

* PERSON ABANDONING WELL: self

WELL DRILLERS LICENSE NUMBER: _____
 CIRCLE: MWD/MSD/MGD

* OWNER'S NAME: Marsha Engel

* WELL LOCATION:
 COUNTY: Howard
 NEAREST TOWN: Seagroveville
 TAX MAP BLOCK 11000 PARCEL 148
 SUBDIVISION: _____
 SECTION: _____ LOT: 6
 NEAREST ROAD: Harding Road

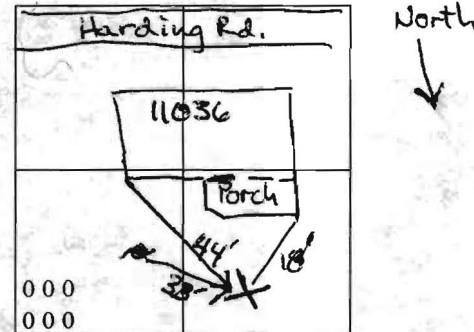

SHOW WELL LOCATION BY X WITHIN BOX

MARYLAND GRID COORDINATES

BOX NUMBER E _____
 N _____

* TYPE OF WELL BEING ABANDONED:

- _____ DRILLED
- _____ BORED/AUGURED
- _____ OTHER (specify) _____
- _____ JETTED
- HAND DUG

* USE CODE:

- DOMESTIC
- _____ IRRIGATION
- _____ TEST/OBSERVATION
- _____ MUNICIPAL/PUBLIC
- _____ INDUSTRIAL

* TYPE OF CASING:

- STEEL
- CONCRETE
- _____ PLASTIC
- _____ OTHER (specify) soil

* SIZE OF CASING: 36" INCHES IN DIAMETER

* DEPTH OF WELL: <100 FEET DEEP

* WAS ANY CASING REMOVED? _____ YES NO
 if yes, length removed, in feet: _____

* WAS CASING RIPPED OR PERFORATED? _____ YES NO

LOG OF SEALING MATERIAL

MATERIAL	FEET	
	FROM	TO
Sand + gravel	5	60
concrete	2	5
soil	0	2

SIGNATURE-MASTER WELL DRILLER OR SUPERVISING SANITARIAN Robert Bueler R.S.

LICENSE # 001408

CIRCLE ONE

DATE 3/25/08



March 25, 2008

To Whom It May Concern,

Acting as the contractor for the abandonment of my previous well, I contracted the labor to redig and seal with cement and soil five feet deep.



Marsha Engel

11036 Harding Road

Laurel, MD 20723

301-776-9044