

3170 (OEP USE ONLY)  
 (THIS NUMBER IS TO BE PUNCHED IN COLUMNS ON ALL CARDS)

**WELL COMPLETION REPORT**  
 FILL IN THIS FORM COMPLETELY  
 PLEASE PRINT OR TYPE

45 DAYS AFTER WELL IS COMPLETED.  
 COUNTY NUMBER A-31937

Date received (OEP use only)  
 DATE WELL COMPLETED 5/18/82

Depth of Well 129  
 (TO NEAREST FOOT)

PERMIT NO.  
 FROM "PERMIT TO DRILL WELL"  
MO-78-9170

OWNER Burke Fred  
 last name first name  
 STREET OR RFD 17220 Hardy Rd TOWN Poplar Springs MO.  
 SUBDIVISION \_\_\_\_\_ SECTION \_\_\_\_\_ LOT \_\_\_\_\_

**WELL LOG**  
 Not required for driven wells  
 STATE THE KIND OF FORMATIONS PENETRATED, THEIR COLOR, DEPTH, THICKNESS AND IF WATER BEARING

DESCRIPTION (Use additional sheets if needed)	FEET		Check if water bearing
	FROM	TO	
<u>Brown Shale</u>	<u>0</u>	<u>26</u>	
<u>Blue Rock</u>	<u>26</u>	<u>129</u>	

**GROUTING RECORD**  
 WELL HAS BEEN GROUTED (Circle Appropriate Box)  Y  N  
 TYPE OF GROUTING MATERIAL  
 CEMENT  M BENTONITE CLAY  B C  
 NO. OF BAGS 8 NO. OF POUNDS 752  
 GALLONS OF WATER 48  
 DEPTH OF GROUT SEAL (to nearest foot) from 0 ft. to 27 ft.  
 (enter 0 if from surface) BOTTOM 58 ft.

**CASING RECORD**  
 casing types insert appropriate code below  
 S T  C O  
 STEEL CONCRETE  
 P L  O T  
 PLASTIC OTHER  
 MAIN CASING TYPE  S T Nominal diameter top(main)casing (nearest inch) 6 Total depth of main casing (nearest foot) 30

**OTHER CASING (if used)**  
 diameter inch \_\_\_\_\_ depth (feet) from \_\_\_\_\_ to \_\_\_\_\_

**SCREEN RECORD**  
 screen type or openhole insert appropriate code below  
 S T  B R  H O  
 STEEL BRASS BRONZE OPEN HOLE  
 P L  O T  
 PLASTIC OTHER


**DEPTH (nearest ft.)**  
 E A C H S C R E E N  
1 28 129  
 SLOT SIZE \_\_\_\_\_  
 DIAMETER OF SCREEN (NEAREST INCH) \_\_\_\_\_

GRAVEL PACK \_\_\_\_\_  
 IF WELL DRILLED WAS FLOWING WELL CIRCLE BOX  F

OEP USE ONLY (NOT TO BE FILLED IN BY DRILLER)  
 T (E.R.O.S.) \_\_\_\_\_ W Q \_\_\_\_\_  
 TELESCOPE CASING \_\_\_\_\_ LOG INDICATOR \_\_\_\_\_ OTHER DATA \_\_\_\_\_

**PUMPING TEST**  
 HOURS PUMPED (nearest hour) 3  
 PUMPING RATE (gal. per min. to nearest gal.) 7  
 METHOD USED TO MEASURE PUMPING RATE Am  
 WATER LEVEL (distance from land surface) BEFORE PUMPING 27 WHEN PUMPING 31  
 TYPE OF PUMP USED (for test)  A air  P piston  T turbine  C centrifugal  R rotary  O other (describe below)  J jet  S submersible

**PUMP INSTALLED** YES  Y NO  N  
 DRILLER WILL INSTALL PUMP (CIRCLE APPROPRIATE BOX)  
 IF DRILLER INSTALLS PUMP, THIS SECTION MUST BE COMPLETED FOR ALL WELLS EXCEPT HOME USE  
 TYPE OF PUMP (WRITE APPROPRIATE LETTER IN BOX - SEE ABOVE: (A, C, J, P, R, S, T, O))  \_\_\_\_\_  
 CAPACITY: GALLONS PER MINUTE (to nearest gallon) \_\_\_\_\_  
 PUMP HORSE POWER \_\_\_\_\_  
 PUMP COLUMN LENGTH (nearest ft.) \_\_\_\_\_  
 CASING HEIGHT (circle appropriate box and enter casing height)  + above  - below 2 (nearest foot)

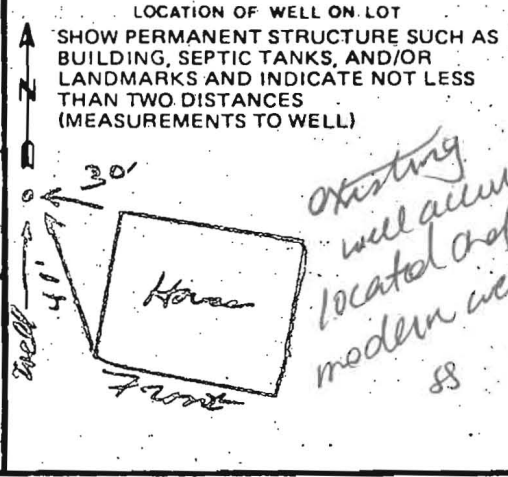

- CIRCLE APPROPRIATE BOX  
 A A WELL WAS ABANDONED AND SEALED WHEN THIS WELL WAS COMPLETED  
 E ELECTRIC LOG OBTAINED  
 P TEST WELL CONVERTED TO PRODUCTION WELL

I HEREBY CERTIFY THAT THIS WELL HAS BEEN CONSTRUCTED IN ACCORDANCE WITH COMAR 10.17.13 "WELL CONSTRUCTION" AND IN CONFORMANCE WITH ALL CONDITIONS STATED IN THE ABOVE CAPTIONED PERMIT, AND THAT THE INFORMATION PRESENTED HEREIN IS ACCURATE AND COMPLETE TO THE BEST OF MY KNOWLEDGE.

DRILLERS IDENT. NO. 238  
 DRILLERS SIGNATURE Charles L. Mays  
 (MUST MATCH SIGNATURE ON APPLICATION)

SITE SUPERVISOR (sign of driller or journeyman responsible for sitework if different from permittee)