


APV _____

A

- 5" BK 6m SL
zfgr
- RD Tan
LS
Saprolite
- 9" Gray SL
MIP-Red
- 12" Bm SL
CID-grey
CID-orange
- 24" RD Bm SL
C3D-grey
- 30" C3P-grey
MIP-orange
Rebar
hit gravel

12080 Hall Shop Rd

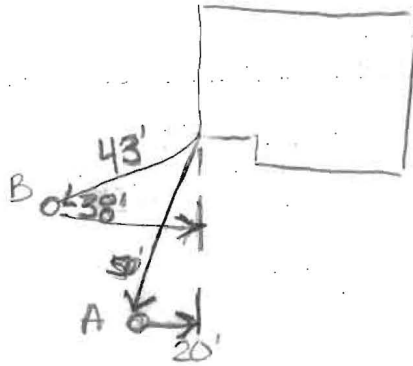

Area not large enough for sand or gravel

B

- 4" Bm SL
zfgr
- 9" Pale Bm SL
- Bm SL
zfgr
- 21" RD Tan *
LS micaceous
Saprolite
- 39" H2O seepage

DATE	TEST #	DEPTH	START	BREAK 1" DROP	STOP 2" DROP	TIME OF 2ND INCH	P/F/H

REMARKS _____

SANITARIAN RB/AT BACKHOE _____ OTHERS _____

TEST HOLES USED IN SDA _____ AVG. PERC TIME _____ SQ. FT/BR _____

TRENCH WIDTH _____ INLET DEPTH _____ MAX. BOT DEPTH _____ EFFECTIVE SW _____