

6882 Haviland Mill Road


Clarksville, MD 21029


Approved Septic System Plan
Howard County Health Department

Alma Beard
Signature
1-22-12
Date

Graphic Scale

1 inch = 30 FT

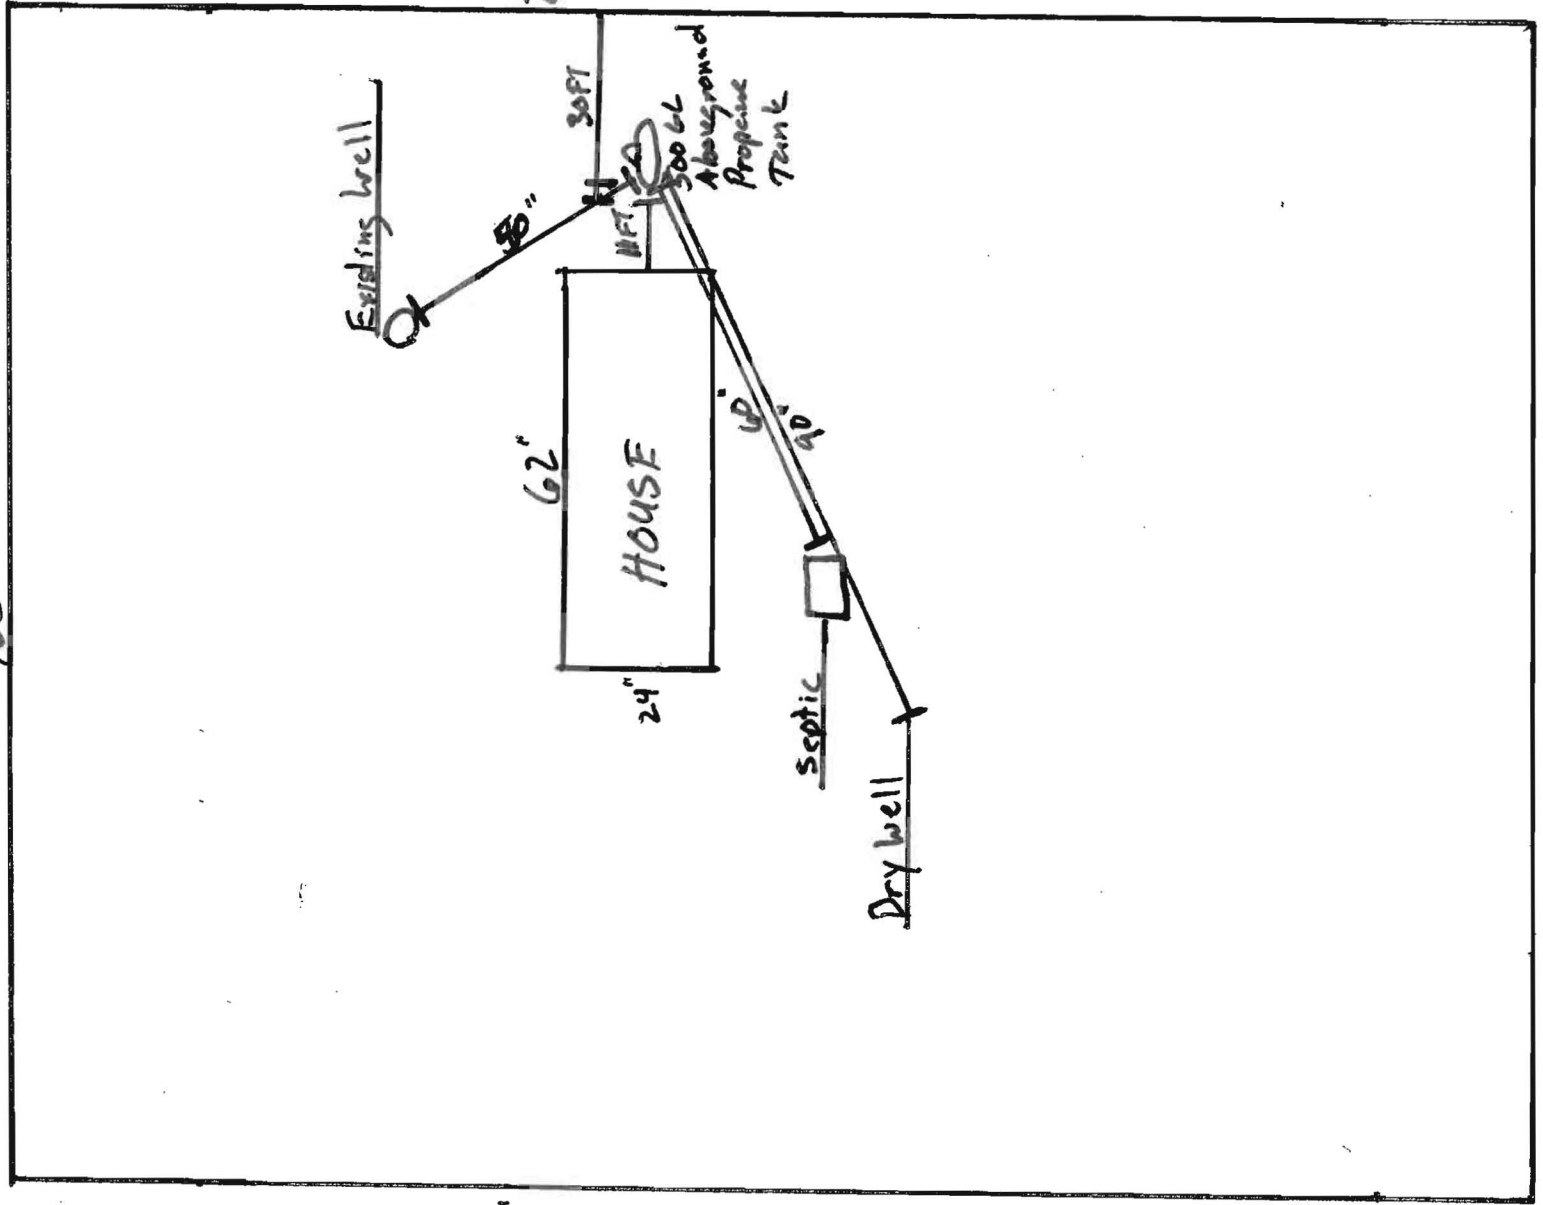

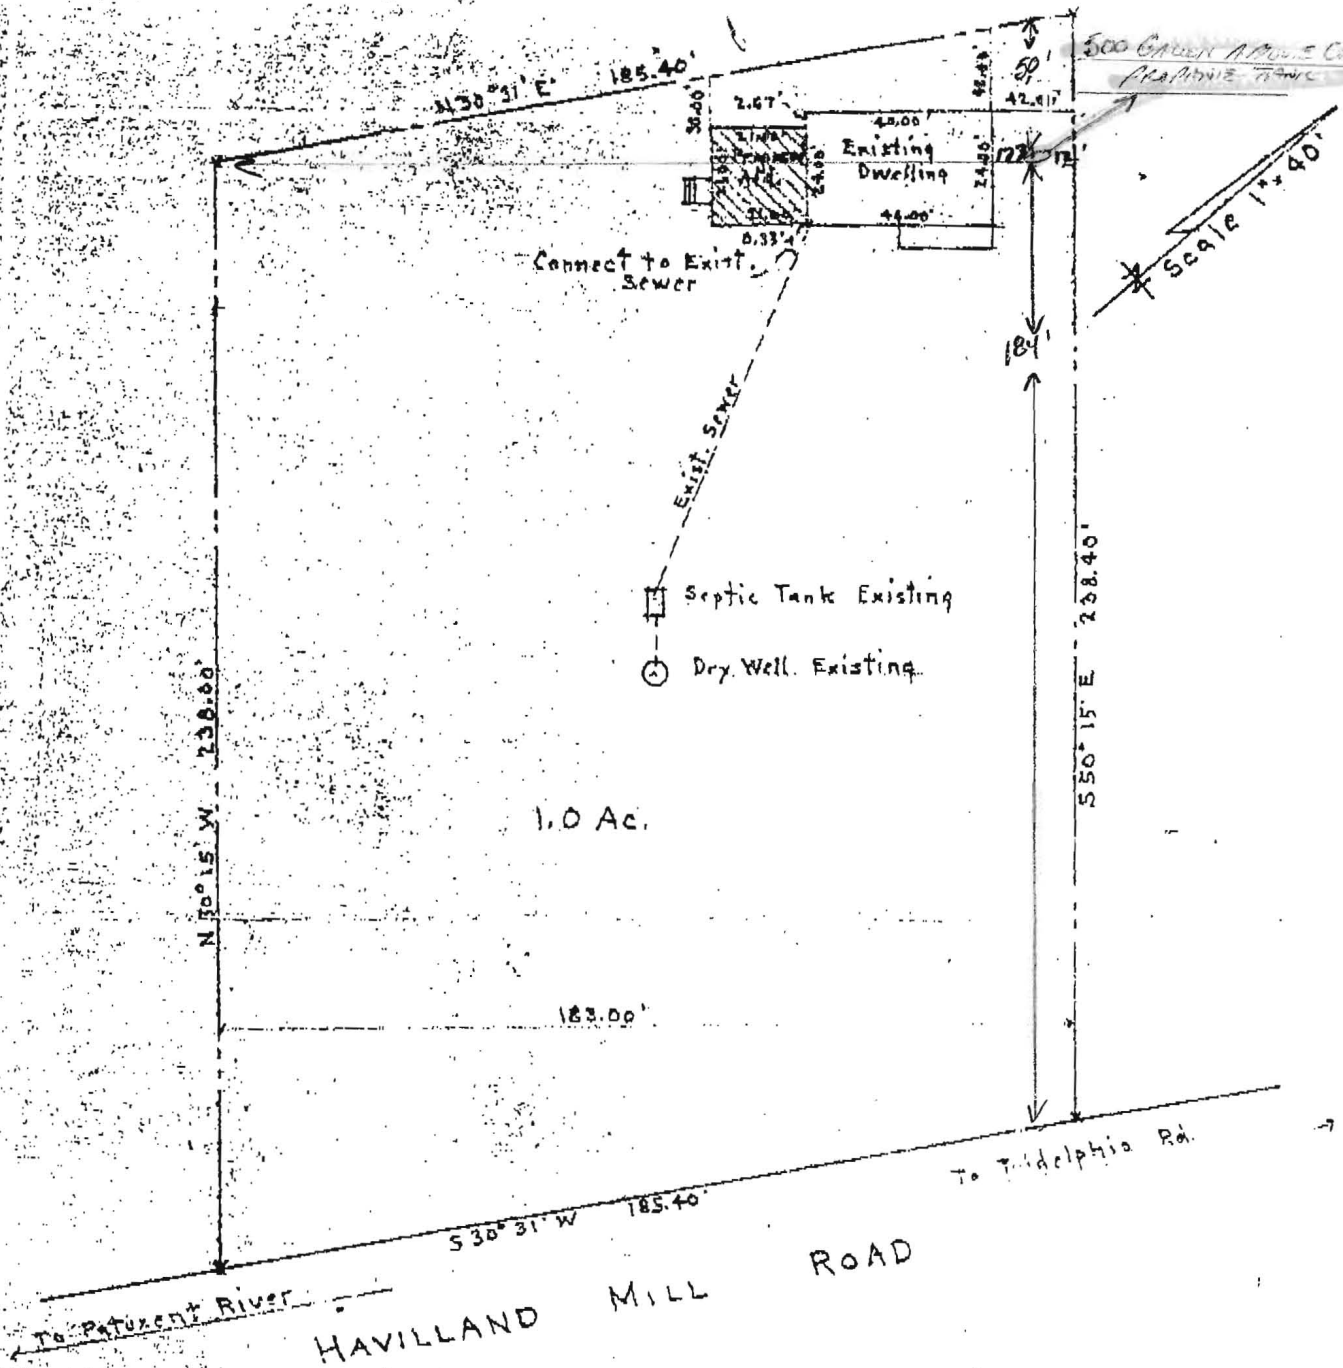

HOUSE LOCATION PLAN

EUGENE A. MARROW
 5TH ELECTION DIST., HOWARD COUNTY
 CLARKSVILLE, MARYLAND.

#23239

FILE INQUIRY NOTES

DATE	RESULTS OF REVIEW FOR FILE
6/12/13	In route to property for scheduled repair, running little late. Made phone call to Kerry Mays (contractor) replying I was in route when he explained that he wanted to hold off on repair. He He explained that homeowner never responded to him about the repair ?? (KW)
	→ site insp. made. No visual failure seen. No one home (KW)