

Final

APPLICATION

SEWAGE DISPOSAL TESTING

A 29053

STATE OF MARYLAND - DEPARTMENT OF HEALTH AND MENTAL HYGIENE

P _____

HOWARD COUNTY HEALTH DEPARTMENT
ENVIRONMENTAL HEALTH SERVICES
P.O. BOX 476 ELLICOTT, MARYLAND 21043
TELEPHONE: 992-2330

DISTRICT 5th
DATE 10/16/78

TO: THE COUNTY HEALTH OFFICER
ELLICOTT CITY, MARYLAND

I HEREBY APPLY FOR THE NECESSARY TEST IN ORDER TO CONSTRUCT (OR RECONSTRUCT) A SEWAGE DISPOSAL SYSTEM.

PROPERTY OWNER Tridelphia Mill Farms Partnership

ADDRESS 50 R. Hollenwell PHONE 286-7488
Sandy Spring, Md 20860

PROPERTY LOCATION:
SUBDIVISION Tridelphia Mill Farms LOT NO. Final #6
6-Sheet 1

ROAD AND DESCRIPTION S side of Tridelphia Mill Rd 1500' E of
Sheenbridge Rd, Dayton

SIZE OF LOT 3.4 acres TYPE BLDG. 4 bedrm - single family dwg.

THE SYSTEM INSTALLED UNDER THIS APPLICATION IS ACCEPTABLE ONLY UNTIL PUBLIC FACILITIES BECOME AVAILABLE.

I FULLY UNDERSTAND THE FEE CONNECTED WITH THE FILING OF THIS PERC TEST APPLICATION IS NON-REFUNDABLE UNDER

ANY CIRCUMSTANCES.

SIGNATURE OF APPLICANT Richard Hollenwell

APPROVED BY _____ FOR _____ DATE _____

REJECTED BY _____ FOR _____ DATE _____

HOLD PENDING FURTHER TESTS _____ DATE _____

REASONS FOR REJECTION OR HOLDING _____

THIS IS NOT A PERMIT

6 sheet 1


Tree Fence Woods T

Field
shovel
Woods T
per
stake

SOIL PROFILE

Below
clay
mic
sandy
loam

↓

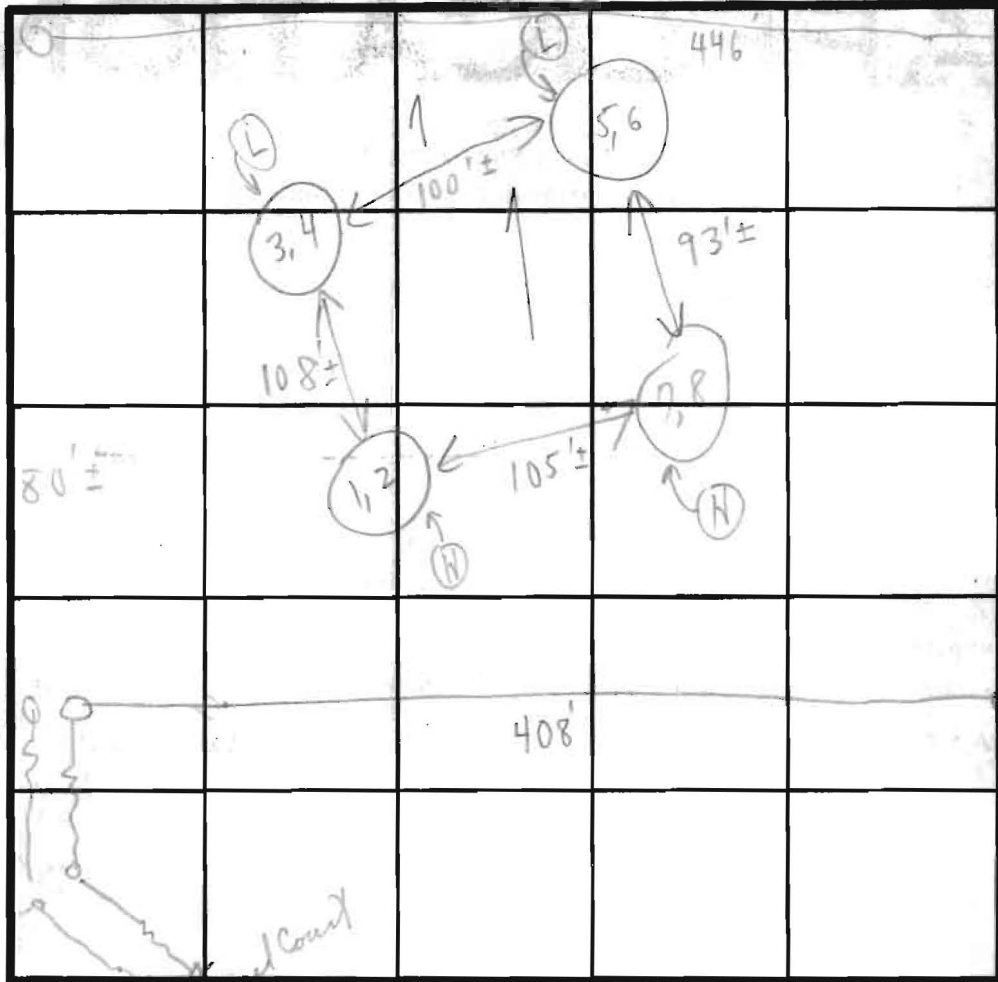

360'

INDICATE NORTH - NAME ADJOINING ROADWAY AS BASE LINE.

DATE	TEST NO.	DEPTH	PRE-WET		TEST - 1" DROP		TIME
			START	STOP	START	STOP	
12/3/75	1	4 1/2'	10:25	10:27	10:27	10:29	2m
	2	13'	10:24	10:27	10:27	10:39	12m
	3	4 1/2'	10:36	10:43	10:43	10:54	11m
	4	12 1/2'	10:36	10:39	10:39	10:49	10m
	5	4'	10:31	10:32	10:32	10:34	2m
	6	12'	10:31	10:33	10:33	10:35	2m
	7	3 1/2'	10:22	10:23	10:23	10:26	3m
	8	12 1/2'	10:22	10:26	10:26	10:32	6m
						8	8

120 #/BK

solid
4 1/2'

6 min

REMARKS Tests in open area

TYPE OF SOIL

TESTED BY C.B. ALSO PRESENT P. Schuster

F-81-64 (Signed Record Plat) 6/81
Triadelphia Mill Farms
Sec 1 Area 2

W.S.S.E.

