

9/28/65
Approved

Approved 9/28/65
R.F.

PERMIT

SEWAGE DISPOSAL SYSTEM

P 10754

A 10514

MARYLAND STATE DEPARTMENT OF HEALTH

HOWARD COUNTY

ELLICOTT CITY

INDEXED

DISTRICT 4

DATE 8/17/65

W. W. Wagner IS PERMITTED TO INSTALL ALTER

Gamber Road
ADDRESS Finksburg, Md. PHONE

A SEWAGE DISPOSAL SYSTEM LOCATED AT

SUBDIVISION 17226 ROAD Hardy Rd. LOT

PROPERTY OWNER Robert E. Boudreau & Charlotte 829 0617

ADDRESS 6407 - 85th Rd., Hyattsville, Md.

SPECIFICATIONS - 4 bedrooms

DRAIN FIELD DEPTH FEET, BOTTOM AREA SQ. FT.

SEEPAGE PITS ABSORBENT SIDE-WALL AREA SQ. FT.

SEPTIC TANK CAPACITY 1000 GALLONS

FOR GARBAGE GRINDER, INCREASE DISPOSAL AREA 22% & TANK CAPACITY 50%.

OTHER Dry well 13 ft. in dia. by 13 ft. deep below the inlet located 1072 ft. from the front property line that borders Hardy Road and 19 ft. off the right side property line as seen when facing the lot from Hardy Road. Locate inlet 3 ft. below original grade.

BP (quantity) 18388

PLANS APPROVED BY J. Hennigan DATE 7/16/65


FILL SEPTIC TANK AND DISTRIBUTION BOX WITH WATER BEFORE CALLING FOR AN INSPECTION. COVER NO WORK UNTIL INSPECTED AND APPROVED.

NEITHER THE HOWARD COUNTY COMMISSIONERS NOR THE HEALTH DEPARTMENT IS RESPONSIBLE FOR THE SUCCESSFUL OPERATION OF ANY SYSTEM.

A 10514

A10514

530

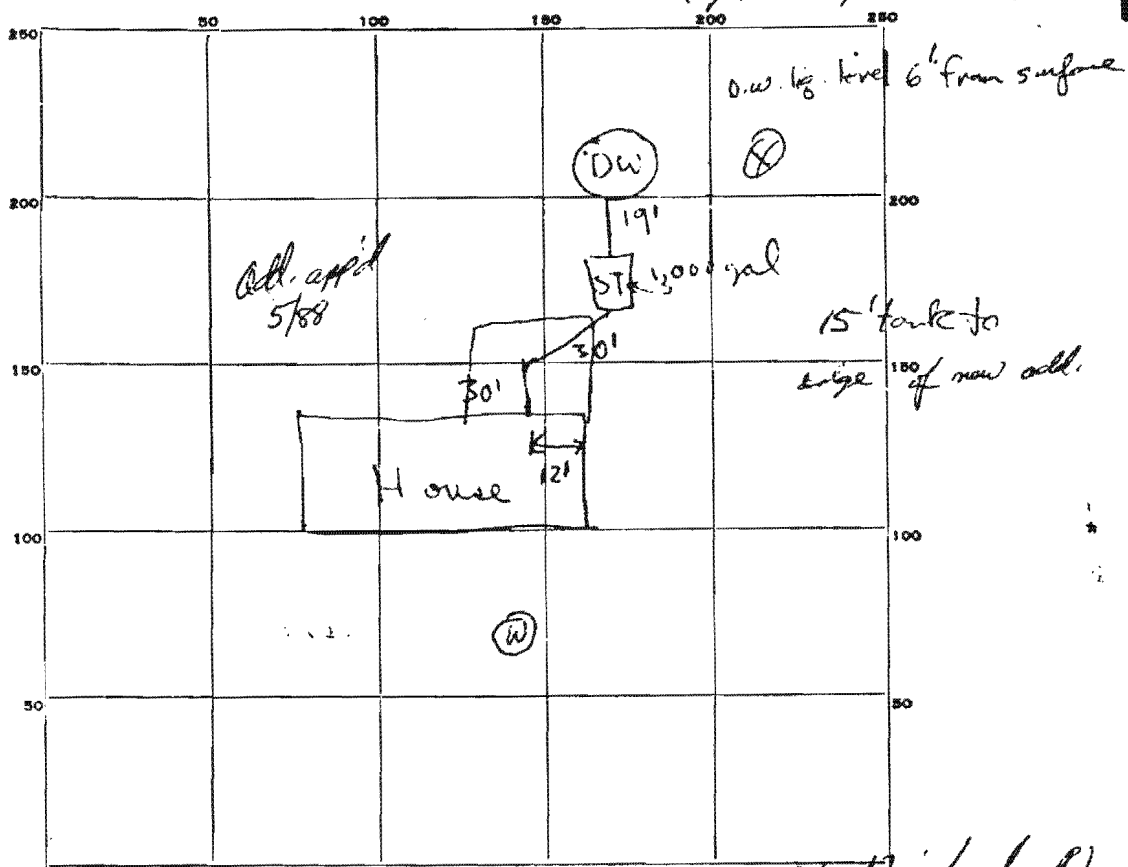

INDICATE NORTH - NAME ADJOINING ROADWAY AS BASE LINE.

Hardy Rd → Tr St. Michaels Rd.

PERMIT CARD OK

SEPTIC TANK, LEVEL OK CLEANOUTS OK

DISTRIBUTION BOX, LEVEL _____

TILE FIELD, DEPTH _____ FT. TRENCH WIDTH _____ FT.

GRAVEL DEPTH _____ IN. TOTAL LENGTH _____ FT.

NUMBER OF TRENCHES _____ TOTAL BOTTOM AREA _____

SEEPAGE PITS, INSIDE DIAMETER 12 FT. DEPTH BELOW INLET 12 FT.

ABSORBENT AREA 452 SQ. FT.

REMARKS 9/28/65 - D.W. to D.W. 15 ft x 12 ft deep = 565 sq. ft.

A10514 7/16/65 test at D.W. slow 4" & 3 in at 9 ft, 2 cut (X) 16 in at 4 ft
 good soil starts 5-5 ft, 8 in at 9 ft.
 good soil starts 1 1/2 ft

DATE SYSTEM APPROVED 9/25/65 INSPECTOR R.F. Litcher

THIS REPORT
MUST BE SUBMITTED
WITHIN 30 DAYS
AFTER COMPLETION
OF THE WELL

Robt. Boudreau WELL COMPLETION REPORT *A10514*

WELL DESCRIPTION

WELL LOG
State the kind of formations penetrated, their color, their depth, their thickness, and if water-bearing

CASING AND SCREEN RECORD
State the kind and size and position of casing, liner, shoe, screen, and other accessories (if no casing used give diameter of well).

FEET from ___ to ___	DIAM (inches)	FEET from ___ to ___
4 Gravel + sand	4 1/4"	2 1/4
2 1/2 Sand + gravel	Pipe	
10 x bits + gravel		
WELL 120		

Permit Number *664120*
Owner _____
Address _____
Subdivision *1*
Section _____ Lot _____

PUMPING TEST
Hours Pumped _____
Type of Pump Used _____
Pumping Rate _____
Gallons per Minute *10*

WATER LEVEL
Distance from land surface to water
Before Pumping *4 1/2* Ft.
When Pumping _____ Ft.

APPEARANCE OF WATER
Clear Cloudy _____
Taste _____
Odor *low*
Height of Casing Above Land Surface *2* Ft.

PUMP INSTALLED
Type _____
Capacity _____
Gallons per Minute _____
Gallons per Hour _____
Pump Column Length _____ Ft.

LOCATION OF WELL ON LOT
Show permanent structures such as building(s), septic tank, and/or other landmarks and indicate not less than 2 distances (measurements) to well.



Date Well was Completed *11/1/65* Well Driller Signature *[Signature]*