

APPLICATION

19911

A _____

P _____

SEWAGE DISPOSAL TESTING

STATE OF MARYLAND - DEPARTMENT OF HEALTH AND MENTAL HYGIENE

HOWARD COUNTY HEALTH DEPARTMENT
ENVIRONMENTAL HEALTH SERVICES

P. O. BOX 476, ELLICOTT CITY, MARYLAND 21043
TELEPHONE: 465-5000, EXT. 356

DISTRICT 5th

DATE 5/7/74

TO: THE COUNTY HEALTH OFFICER
ELLICOTT CITY, MARYLAND

I, HEREBY, APPLY FOR THE NECESSARY TEST IN ORDER TO CONSTRUCT (OR RECONSTRUCT) A SEWAGE DISPOSAL SYSTEM.

PROPERTY OWNER ~~JOHNXY~~ Dale Maisel property (Mr. Harold Brown - Contract Purchaser)

Any questions call Mr. Rettaliata
465-4920

ADDRESS _____ PHONE _____

PROPERTY LOCATION:

SUBDIVISION (Glenelg Manor) LOT NO. Parcel 10

ROAD AND DESCRIPTION Folly Quarter Road

SIZE OF LOT 11.354 acres TYPE BLDG. 3 or 4 bedrooms

NUMBER OF BEDROOMS

IF NOT SINGLE RESIDENCE DESCRIBE _____

THE SYSTEM INSTALLED UNDER THIS APPLICATION IS ACCEPTABLE ONLY UNTIL PUBLIC FACILITIES BECOME AVAILABLE.

SIGNATURE OF APPLICANT /s/ John F. Rettaliata


APPROVED BY _____ FOR _____ DATE _____
(KIND OF SYSTEM)

REJECTED BY _____ FOR _____ DATE _____
(KIND OF SYSTEM)

HOLD PENDING FURTHER TESTS _____ DATE _____

REASONS FOR REJECTION OR HOLDING _____

THIS IS NOT A PERMIT

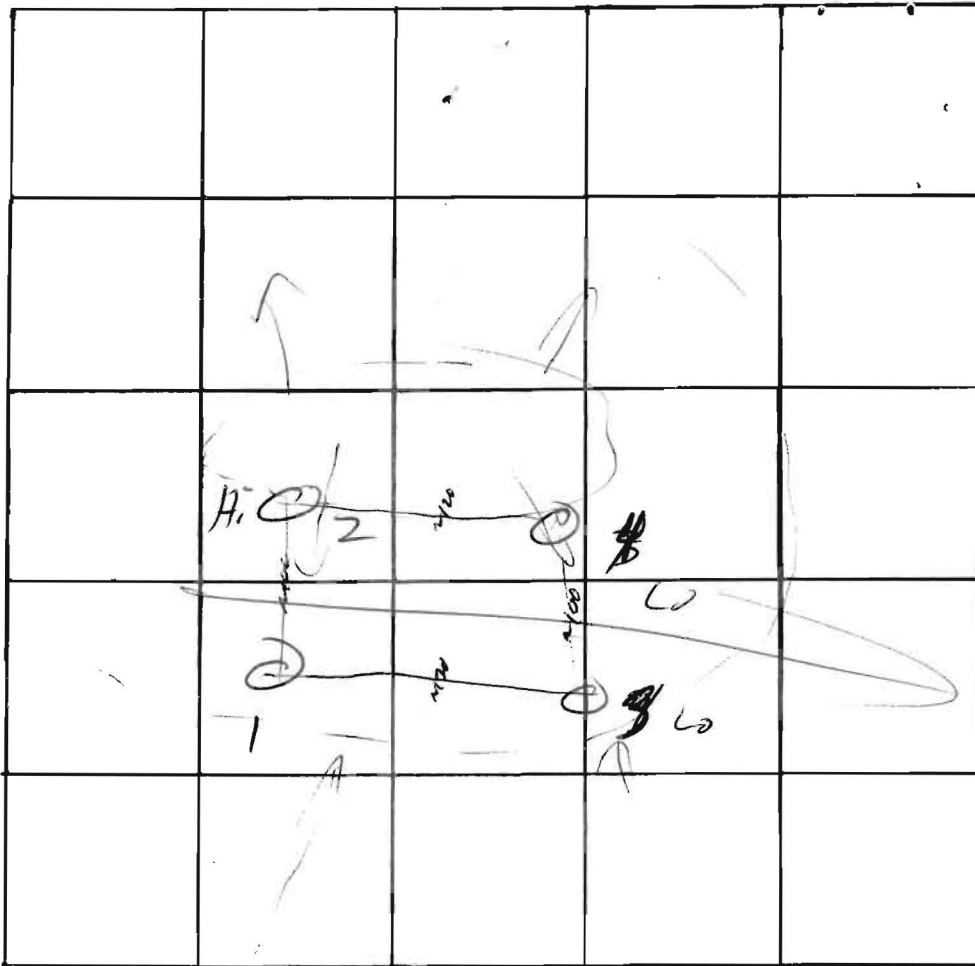

INDICATE NORTH. - NAME ADJOINING ROADWAY AS BASE LINE.

R W

DATE	TEST NO.	DEPTH	PRE-WET		TEST - 1" DROP		TIME
			START	STOP	START	STOP	
	1	10 ^{1/2}	VIS				
	2	2	10 ⁴¹	10 ⁴²	10 ⁴²	10 ⁴⁵	3
	2A	12	10 ⁴¹	10 ⁴⁵	10 ⁴⁵	11 ⁰⁰	15
	3	3	10 ¹²	10 ²⁰	10 ²⁰	10 ⁴⁸	28
	3A	10	10¹²	10²⁰	10²⁰	10⁴⁸	15
	3A	12^{1/2}	10²⁸	10³¹	10³¹	10⁴⁰	9
	4	10	VIS				

REMARKS do not use #4 until last

TYPE OF SOIL brown loam

TESTED BY R M ALSO PRESENT: Raymond Colley

(refer to note (log) of 5/11/74 R.M.)
when writing up notes

APPLICATION

Brown
19911

A _____

P _____

SEWAGE DISPOSAL TESTING

STATE OF MARYLAND - DEPARTMENT OF HEALTH AND MENTAL HYGIENE

HOWARD COUNTY HEALTH DEPARTMENT
ENVIRONMENTAL HEALTH SERVICES

DISTRICT 5th

DATE 5/7/74

P. O. BOX 476, ELLICOTT CITY, MARYLAND 21043 *Septic Tank cap.:*
TELEPHONE: 465-5000, EXT. 356 *3 B.R. - 1000 gal ; 4 B.R. - 1250 gal*

PRELIMINARY
5/10/74
9:30 A.M.

for dry well (s) (see attached sheet)

TO: THE COUNTY HEALTH OFFICER
ELLICOTT CITY, MARYLAND

I, HEREBY, APPLY FOR THE NECESSARY TEST IN ORDER TO CONSTRUCT (OR RECONSTRUCT) A SEWAGE DISPOSAL SYSTEM.

PROPERTY OWNER ~~JOHNXXY~~ Dale Maisel property (Mr. Harold B rown - Contract Purchaser)

Any questions call Mr. Rettaliata
465-4920

ADDRESS _____ PHONE _____

PROPERTY LOCATION:

SUBDIVISION (Gleneig Manor) LOT NO. Parcel 10

ROAD AND DESCRIPTION Folly Quarter Road

SIZE OF LOT 11.354 acres TYPE BLDG. 3 or 4 bedrooms
NUMBER OF BEDROOMS

IF NOT SINGLE RESIDENCE DESCRIBE _____

THE SYSTEM INSTALLED UNDER THIS APPLICATION IS ACCEPTABLE ONLY UNTIL PUBLIC FACILITIES BECOME AVAILABLE.

SIGNATURE OF APPLICANT /s/ John F. Rettaliata

APPROVED BY *Robert J. Moore* FOR *D.W.* DATE *5/29/74*
(KIND OF SYSTEM)

REJECTED BY _____ FOR _____ DATE _____
(KIND OF SYSTEM)

HOLD PENDING FURTHER TESTS _____ DATE _____

REASONS FOR REJECTION OR HOLDING *System to be installed before building permit is signed*
5/29/74 R.M.

Kept to Glenelg Country School.

THIS IS NOT A PERMIT

INDICATE NORTH. - NAME ADJOINING ROADWAY AS BASE LINE.

DATE	TEST NO.	DEPTH	PRE-WET		TEST - 1" DROP		TIME
			START	STOP	START	STOP	

REMARKS _____

TYPE OF SOIL _____

TESTED BY _____ ALSO PRESENT: _____

APPROVED FOR PRIVATE WATER & PRIVATE SEWAGE SYSTEMS HOWARD COUNTY HEALTH DEPT.

J. P. Pazar, M.D. 5/31/74
 CLINIC HEALTH DEPT. OFFICE

WELL
 FIN. GR 382.
 EX. GR 382.50



THE LOT SHOWN HEREON COMPLIES WITH THE MINIMUM OWNERSHIP WIDTH AND LOT AREA AS REQUIRED BY THE MARYLAND STATE DEPARTMENT OF HEALTH.



Philip A. Pappella 5/11/74

Call:
 Mr. Keston
 987-1100

or
 Mr. Keshino

TITLE PERCOLATION TEST PLAT			
PROJECT BROWN PROPERTY GLENELG MANOR - SECTION 1 - LOT 10			
LOCATION 5 TH ELECTION DISTRICT - HOWARD COUNTY, MD.			
DATE: MAY 1974	DES. BY:	DRAWN BY: R	CHKD. BY:
SCALE: 1" = 200'	JOB NO. 7458	DRWG. NO.: 1	

ENGINEERING
 PLANNING
 SURVEYING
 BY
**BOENDER
 ASSOCIATES
 INC.**
 BALTIMORE, MD. 465-7777
 SALISBURY, MD. 749-1286
 WESTMINSTER, MD. 848-5588