

B 1 5461
1 2 3 6

SEQUENCE NO. (MDE USE ONLY)

STATE OF MARYLAND
APPLICATION FOR PERMIT TO DRILL WELL
please type
W525114


STATE PERMIT NUMBER
HO-95-0474
70 fill in this form completely 79

Date Received (APA) 06/19/06
8 MM DD YY 13
OWNER INFORMATION
15 Last Name Mason Owner First Name Tracy 34
36 3977 High Point Road Street or RFD 55
57 Ellicott City MD 21042 Town 70 State 72 Zip 76

B 3 LOCATION OF WELL
8 COUNTY Howard 21
23 SUBDIVISION
SECTION 44 46 LOT 5 48 50
52 NEAREST TOWN Ellicott City 71
MILES FROM TOWN (enter 0 if in town) 3 MI 73 76 77 78

DRILLER INFORMATION
6 Daniel Patton M SD 163 Driller's Name 76 License No. 81
Patton Well Drilling Firm Name
6810 Cornell Road Chase, MD 21220 Address
Daniel Patt 6/09/06 Signature Date

B 4
1 2 DIRECTION OF WELL FROM TOWN (CIRCLE BOX)
11 High Point Rd. NEAR WHAT ROAD 30
ON WHICH SIDE OF ROAD (CIRCLE APPROPRIATE BOX)
NORTH SOUTH WEST EAST
34 200 37 DISTANCE FROM ROAD FT 38 39
ENTER FT OR MI
TAX MAP: 24 BLK: 17 PARCEL 458

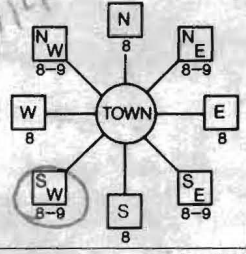

B 2 WELL INFORMATION
1 2 APPROX. PUMPING RATE (GAL. PER MIN.) 8 N/A 12
AVERAGE DAILY QUANTITY NEEDED (GAL. PER DAY) 14 20

USE FOR WATER (CIRCLE APPROPRIATE BOX)
D DOMESTIC POTABLE SUPPLY & RESIDENTIAL IRRIGATION
F FARMING (LIVESTOCK WATERING & AGRICULTURAL IRRIGATION)
22 I INDUSTRIAL, COMMERCIAL, DEWATERING
P PUBLIC WATER SUPPLY WELL
T TEST, OBSERVATION, MONITORING
G GEO-THERMAL

NOT TO BE FILLED IN BY DRILLER HEALTH DEPARTMENT APPROVAL
HOWARD (13) W525114 COUNTY NAME COUNTY NO
STATE SIGNATURE INSERT S
DATE ISSUED 7/3/06 7/4/07
43 MM DD YY 48 CO SIGNATURE EXP. DATE
NORTH GRID 520 000 EAST GRID 849 000
50 55 57 63


APPROXIMATE DEPTH OF WELL 3-300' wells 24 FEET 28
APPROXIMATE DIAMETER OF WELL 6 NEAREST INCH

SHOW MAJOR FEATURES OF BOX & LOCATE WELL WITH AN X
SOURCES OF DRILLING WATER
1.
2.
3.
WRITE THE BOX NUMBER FROM THE MAP HERE
E 849 9 000 000
N 520 519


METHOD OF DRILLING (circle one)
BORED (or Augered) JETTED Jetted & DRIVEN
30 AIR-ROTary AIR-PERCussion ROTARY (Hydraulic Rotary)
37 CABLE REVerse-ROTary DRive-POINT
other

REPLACEMENT OR DEEPEMED WELLS (CIRCLE APPROPRIATE BOX)
N THIS WELL WILL NOT REPLACE AN EXISTING WELL
Y THIS WELL WILL REPLACE A WELL THAT WILL BE ABANDONED AND SEALED
39 S THIS WELL WILL REPLACE A WELL THAT WILL BE USED AS A STANDBY-CONTACT LOCAL APPROVING AUTHORITY FOR POLICY ON STANDBY WELLS
D THIS WELL WILL DEEPEM AN EXISTING WELL
PERMIT NUMBER OF WELL TO BE REPLACED OR DEEPEMED (IF AVAILABLE) 41 52

Not to be filled in by driller (MDE OR COUNTY USE ONLY)
APPROP. PERMIT NUMBER G
PERMIT No. HO-95-0474
70 71 72 73 74 75 76 77 78 79

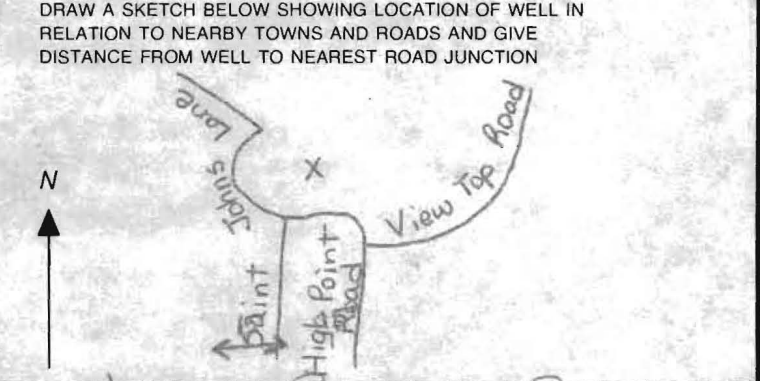

SPECIAL CONDITIONS
NOTE - APPROVING AUTHORITIES SHOULD USE SEPARATE SHEET IF NEEDED
Separate completion Reports for each hole
COUNTY

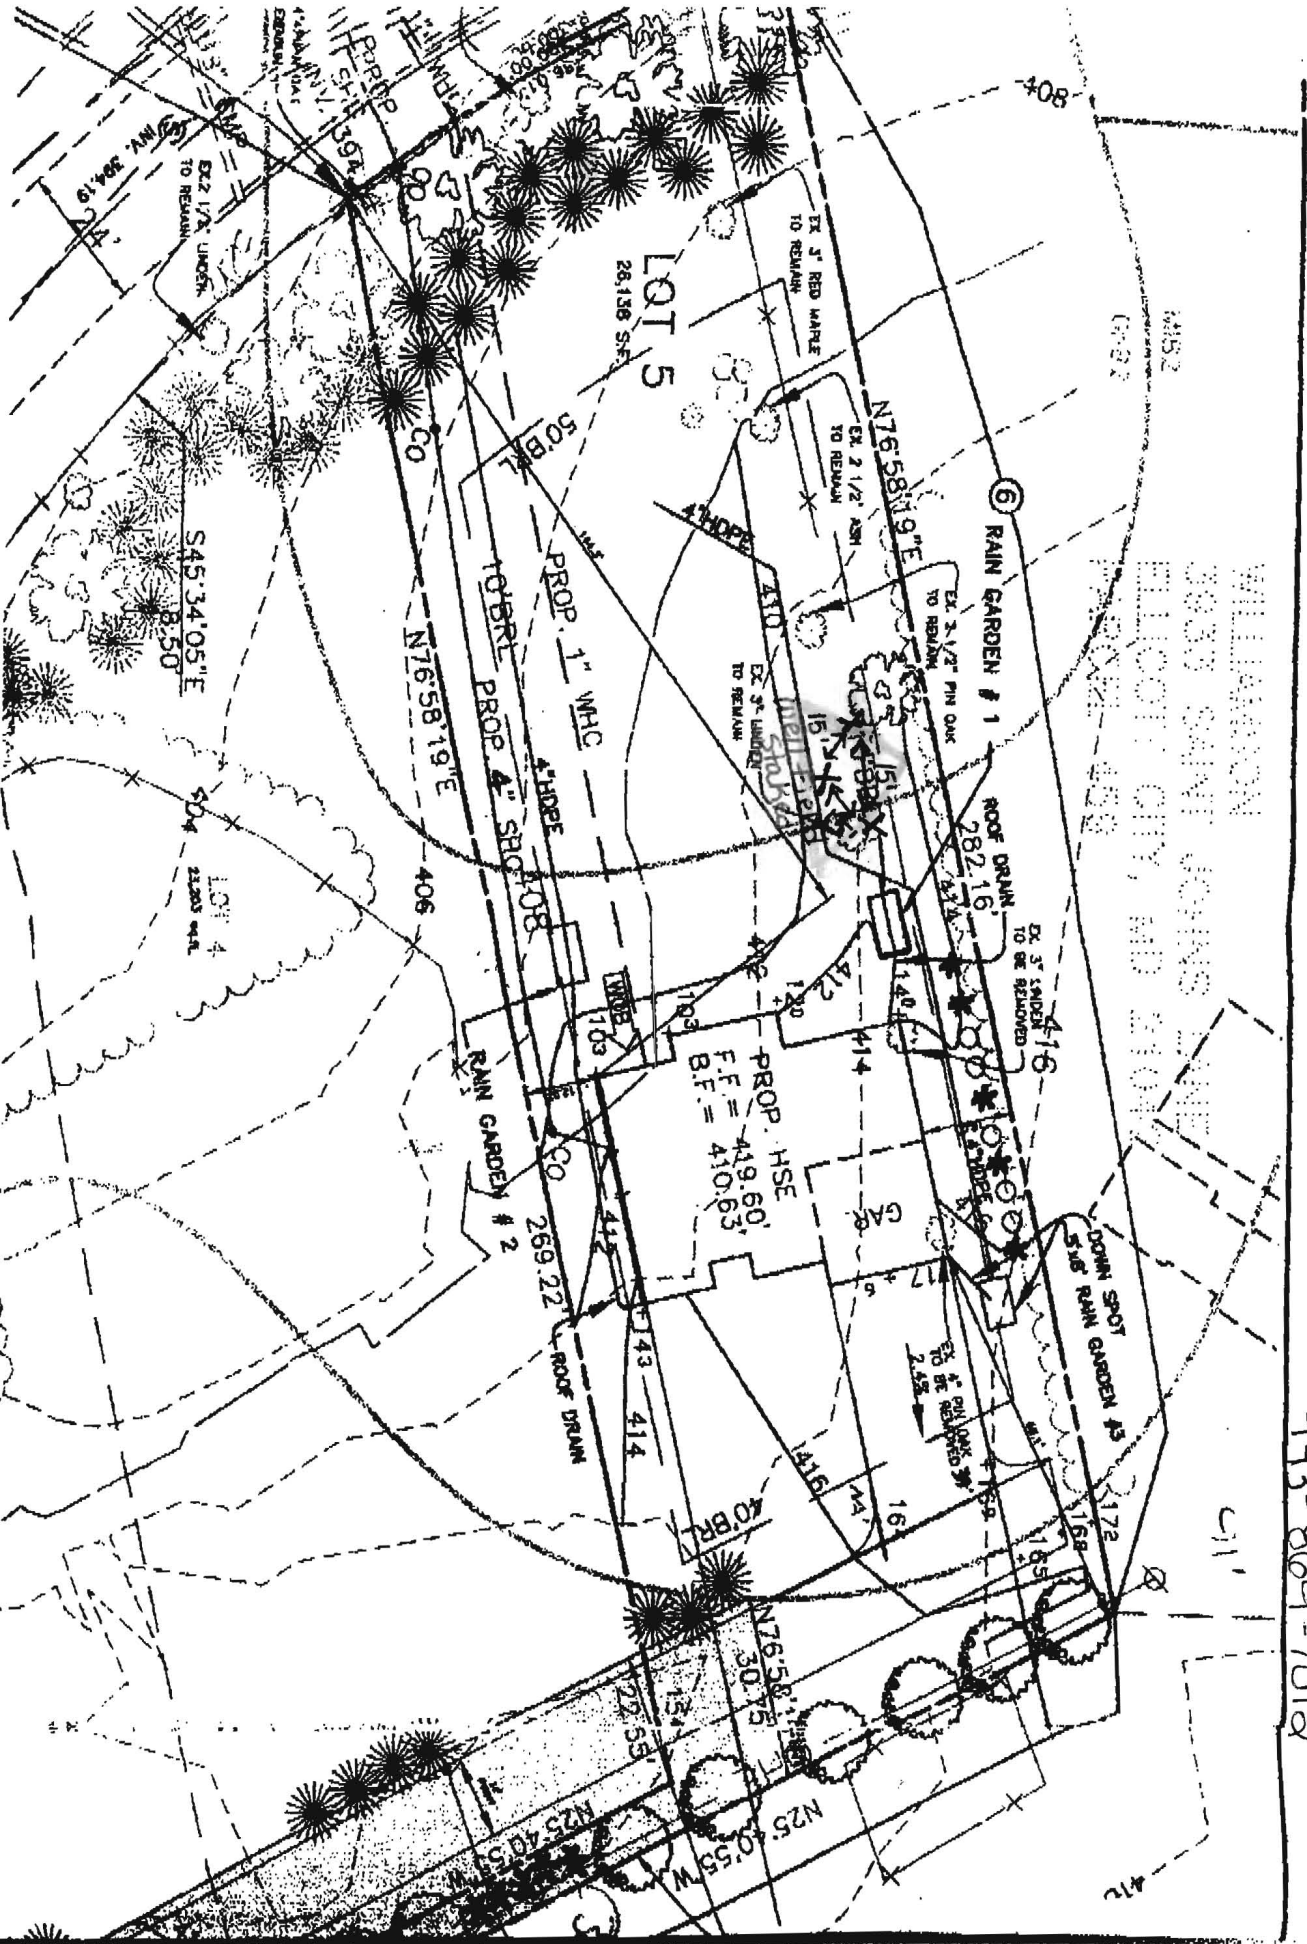

Tracy Mason
 3977 High Point Road
 Ellicott City, MD
 443-864-7012
 21042

WILLIAMSON
 3833 SAINT JOHNS AVENUE
 ELLICOTT CITY, MD 21043
 PROJECT 452