

DRILLER: REMOVE COPY AND RETAIN FOR YOUR RECORDS. RETURN COUNTY COPY TO COUNTY ENVIRONMENTAL AGENCY. SUBMIT COPY TO OWNER. RETURN ALL OTHER PARTS TO DEPARTMENT OF ENVIRONMENT, 1800 WASHINGTON BOULEVARD • BALTIMORE, MARYLAND 21230

C1	0628	SEQUENCE NO. (MDE USE ONLY)	STATE OF MARYLAND WELL COMPLETION REPORT FILL IN THIS FORM COMPLETELY PLEASE TYPE	THIS REPORT MUST BE SUBMITTED WITHIN 45 DAYS AFTER WELL IS COMPLETED.
1 2 3 4 5 6 (THIS NUMBER IS TO BE PUNCHED IN COLS. 3-6 ON ALL CARDS)				
ST/CO USE ONLY DATE Received MM DD YY 8 13		DATE WELL COMPLETED MM DD YY 15 20		Depth of Well 22 26 (TO NEAREST FOOT)
COUNTY NUMBER (13) Howard PERMIT NO. FROM "PERMIT TO DRILL WELL" HO-95-2129 28 29 30 31 32 33 34 35 36 37				

OWNER Kelly Scott
 STREET OR RFD 6719 Hitching Post Ct TOWN Clarksville
 SUBDIVISION _____ SECTION _____ LOT _____

WELL LOG
Not required for driven wells

STATE THE KIND OF FORMATIONS PENETRATED, THEIR COLOR, DEPTH, THICKNESS AND IF WATER BEARING

DESCRIPTION (Use additional sheets if needed)	FEET		check if water bearing
	FROM	TO	

GROUTING RECORD yes no

WELL HAS BEEN GROUTED (Circle Appropriate Box) **Y** **N**
44 44

TYPE OF GROUTING MATERIAL (Circle one)
 CEMENT **CM** BENTONITE CLAY **BC**

NO. OF BAGS ^{45 46} _____ NO. OF POUNDS ^{45 46} _____
 GALLONS OF WATER _____
 DEPTH OF GROUT SEAL (to nearest foot)
 from _____ 48 TOP 52 ft. to _____ 54 BOTTOM 58 ft.
 (enter 0 if from surface)

CASING RECORD

casing types insert appropriate code below

ST STEEL	CO CONCRETE
PL PLASTIC	OT OTHER

MAIN CASING TYPE Nominal diameter top (main) casing (nearest inch) Total depth of main casing (nearest foot)

_____ 60 61 _____ 63 64 _____ 66 _____ 70

OTHER CASING (if used)

E	diameter	depth (feet)	from	to
A	_____ inch	_____ from	_____ to	_____
C	_____	_____	_____	_____
H	_____	_____	_____	_____
S	_____	_____	_____	_____
I	_____	_____	_____	_____
N	_____	_____	_____	_____

SCREEN RECORD

screen type or open hole (insert appropriate code below)

ST STEEL	BR BRASS	HO OPEN HOLE
PL PLASTIC	PL BRONZE	OT OTHER

NUMBER OF UNSUCCESSFUL WELLS: _____

WELL HYDROFRACTURED yes no
Y **N**

CIRCLE APPROPRIATE LETTER

A A WELL WAS ABANDONED AND SEALED WHEN THIS WELL WAS COMPLETED
E ELECTRIC LOG OBTAINED
P TEST WELL CONVERTED TO PRODUCTION WELL

I HEREBY CERTIFY THAT THIS WELL HAS BEEN CONSTRUCTED IN ACCORDANCE WITH COMAR 26.04.04 "WELL CONSTRUCTION" AND IN CONFORMANCE WITH ALL CONDITIONS STATED IN THE ABOVE CAPTIONED PERMIT, AND THAT THE INFORMATION PRESENTED HEREIN IS ACCURATE AND COMPLETE TO THE BEST OF MY KNOWLEDGE.

DRILLERS LIC. NO. M D

DRILLERS SIGNATURE _____
(MUST MATCH SIGNATURE ON APPLICATION)

C2 DEPTH (nearest ft.)

T	8 9 11	15 17	21
A	_____	_____	_____
C	_____	_____	_____
H	_____	_____	_____
S	_____	_____	_____
C	_____	_____	_____
R	_____	_____	_____
E	_____	_____	_____
S	_____	_____	_____
L	_____	_____	_____
O	_____	_____	_____
S	_____	_____	_____
I	_____	_____	_____
N	_____	_____	_____

SLOT SIZE 1 _____ 2 _____ 3 _____

DIAMETER OF SCREEN _____ (NEAREST INCH)
56 60
 from _____ to _____

GRAVEL PACK IF WELL DRILLED WAS FLOWING WELL INSERT F IN BOX 68 _____ 68

MDE USE ONLY

C3 **PUMPING TEST**

HOURS PUMPED (nearest hour) _____ 8 9

PUMPING RATE (gal. per min.) _____ 11 15

METHOD USED TO MEASURE PUMPING RATE _____

WATER LEVEL (distance from land surface)

BEFORE PUMPING _____ 17 20 ft.

WHEN PUMPING _____ 22 25 ft.

TYPE OF PUMP USED (for test)

A air	P piston	T turbine
C centrifugal	R rotary	O other (describe below)
J jet	S submersible	

PUMP INSTALLED

DRILLER INSTALLED PUMP (CIRCLE) (YES or NO) YES NO

IF DRILLER INSTALLS PUMP, THIS SECTION MUST BE COMPLETED FOR ALL WELLS.

TYPE OF PUMP INSTALLED PLACE (A,C,J,P,R,S,T,O) IN BOX 29 _____ 29

CAPACITY: GALLONS PER MINUTE (to nearest gallon) _____ 31 35

PUMP HORSE POWER _____ 37 41

PUMP COLUMN LENGTH (nearest ft.) _____ 43 47

CASING HEIGHT (circle appropriate box and enter casing height)

+ above } LAND SURFACE (nearest foot)
 49

- below } _____ (nearest foot)
 49 50 51

LOCATION OF WELL ON LOT

SHOW PERMANENT STRUCTURE SUCH AS BUILDING, SEPTIC TANKS, AND /OR LANDMARKS AND INDICATE NOT LESS THAN TWO DISTANCES (MEASUREMENTS TO WELL)

DRILLER: COMPLETE THIS APPLICATION AND RETURN ALL PARTS OF THIS FORM INTACT TO THE ENVIRONMENTAL AGENCY IN THE COUNTY IN WHICH THE WELL IS TO BE DRILLED. PRESS FIRMLY FOR FOURTH COPY.

EMERGENCY/TEMP NO. IF ANY

B 1	5553	SEQUENCE NO. (MDE USE ONLY)	STATE OF MARYLAND APPLICATION FOR PERMIT TO DRILL WELL please type	STATE PERMIT NUMBER Ho - 95 - 2129 <small>70 fill in this form completely 79</small>
------------	-------------	--------------------------------	--	---

OWNER INFORMATION

Date Received (APA) _____

8 MM DD YY 13

15 Last Name KELLY Owner SCOTT First Name _____ 34

36 Street or RFD 6719 Hitching Post Ct. 55

57 Town Clarksville 70 State MD 72 Zip 21029 76

B 3 LOCATION OF WELL

8 COUNTY Howard 21

23 SUBDIVISION _____ 42

SECTION 44 46 LOT 48 50

52 NEAREST TOWN Clarksville 71

MILES FROM TOWN (enter 0 if in town) 4 M I
73 76 77 78

DRILLER INFORMATION

Driller's Name Allen Compton M S D 009 License No. 81

Firm Name Eugles Well Drilling

Address 580 Obrecht rd. Sykesville

Signature Allen Compton Date 5-2-11

B 4

1 2 DIRECTION OF WELL FROM TOWN (CIRCLE BOX)

6719 Hitching Post Ct. NEAR WHAT ROAD 30

ON WHICH SIDE OF ROAD (CIRCLE APPROPRIATE BOX)

34 25' 37 DISTANCE FROM ROAD FT
ENTER FT OR MI 38 39

TAX MAP: 0035 BLK: _____ PARCEL 0182

B 2 WELL INFORMATION

APPROX. PUMPING RATE (GAL. PER MIN.) 5 8 12

AVERAGE DAILY QUANTITY NEEDED (GAL. PER DAY) 500 14 20

USE FOR WATER (CIRCLE APPROPRIATE BOX)

DOMESTIC POTABLE SUPPLY & RESIDENTIAL IRRIGATION

FARMING (LIVESTOCK WATERING & AGRICULTURAL IRRIGATION)

INDUSTRIAL, COMMERCIAL, DEWATERING

PUBLIC WATER SUPPLY WELL

TEST, OBSERVATION, MONITORING

GEO-THERMAL

NOT TO BE FILLED IN BY DRILLER HEALTH DEPARTMENT APPROVAL

Howard COUNTY NAME COUNTY NO. 13

STATE SIGNATURE _____ INSERT S → 41

DATE ISSUED _____

43 MM DD YY 48 CO SIGNATURE EXP. DATE

NORTH GRID 492 000 EAST GRID 0826 000
50 55 57 63

APPROXIMATE DEPTH OF WELL 300 FEET
24 28

APPROXIMATE DIAMETER OF WELL 6 INCH
NEAREST INCH

METHOD OF DRILLING (circle one)

BORED (or Augered) JETTED Jetted & DRIVEN

AIR-ROTary AIR-PERcussion ROTARY (Hydraulic Rotary)

CABLE REVerse-ROTary DRive-POINT

other _____

REPLACEMENT OR DEEPEINED WELLS (CIRCLE APPROPRIATE BOX)

THIS WELL WILL NOT REPLACE AN EXISTING WELL

THIS WELL WILL REPLACE A WELL THAT WILL BE ABANDONED AND SEALED

THIS WELL WILL REPLACE A WELL THAT WILL BE USED AS A STANDBY-CONTACT LOCAL APPROVING AUTHORITY FOR POLICY ON STANDBY WELLS

THIS WELL WILL DEEPEIN AN EXISTING WELL

PERMIT NUMBER OF WELL TO BE REPLACED OR DEEPEINED (IF AVAILABLE) 41 _____ 52

SHOW MAJOR FEATURES OF BOX & LOCATE WELL WITH AN X

SOURCES OF DRILLING WATER

- 1.
- 2.
- 3.

WRITE THE BOX NUMBER FROM THE MAP HERE

0826 820
E

492 480
N

DRAW A SKETCH BELOW SHOWING LOCATION OF WELL IN RELATION TO NEARBY TOWNS AND ROADS AND GIVE DISTANCE FROM WELL TO NEAREST ROAD JUNCTION

32

Not to be filled in by driller (MDE OR COUNTY USE ONLY)

RECEIVED MAY 10 2011

Ford rd.

-76°54'27"



39°11'6."



39°11'6."

Disclaimer: Howard County, Maryland assumes no responsibility for the accuracy of this report or the information contained herein or derived therefrom. The user assumes all risks and liabilities whatsoever resulting from or arising out of the use of this information. There are no oral agreements or warranties relating to the use of this report.

-76°54'27"

Howard County


 **Howard County**
M A R Y L A N D

By:
Office:
Map Width: 455.00 ft.
Print Date: 5/17/2011
Scale: 1 in. = 50 ft.

SCOTT KELLY

owner - Mr + Mrs. ~~XXXXXXXXXX~~

Boulder ~~XXXXXXXXXX~~
MCWHORTER CONT. LLC

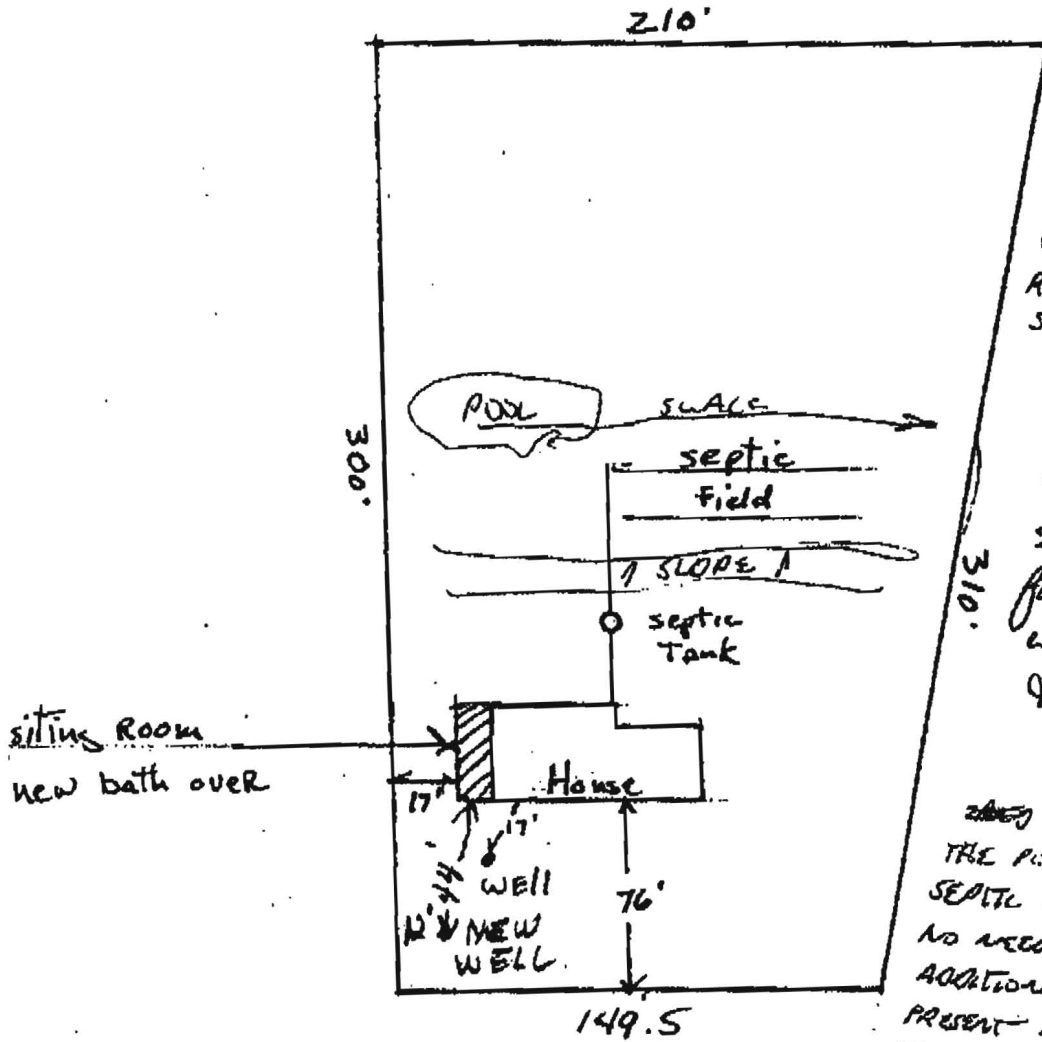

6/30/97

BPI NO EVIDENCE OF
SEWER CLEANOUTS, OR OF
DISCHARGE, LOT IS UNDEVELOPED
REAR AREA EXIST ON LOT
SINCE OWNERS HAVE THE MEANS

6/30/97

We understand the septic
system is old and could
fail in the near future. We
will fix promptly when
this happens.

Cynthia Owens

added TO EXIST SEPTIC AND
THE POSSIBILITY OF A FAILING
SEPTIC GOING UNNOTICED IS SLIM
NO NEED TO HOLD PERMIT.
ADDITION DOES NOT APPEAR TO
PRESENT A SIGNIFICANT INCREASE
TO SEWER. WELL WORKING OK

6719 Hitching Post Ct.
Clarksville, Md 21029
Lot 24 Section 24

Scale: 1" = 60'

