

**C1** 2915

SEQUENCE NO. (MDE USE ONLY)

**STATE OF MARYLAND  
WELL COMPLETION REPORT**  
FILL IN THIS FORM COMPLETELY  
PLEASE TYPE

THIS REPORT MUST BE SUBMITTED WITHIN  
45 DAYS AFTER WELL IS COMPLETED.

1 2 3 6  
(THIS NUMBER IS TO BE PUNCHED  
IN COLS. 3-6 ON ALL CARDS)

COUNTY  
NUMBER

ST/CO USE ONLY  
DATE RECEIVED  
MM DD YY  
8 13

DATE WELL COMPLETED

Depth of Well

PERMIT NO.  
FROM "PERMIT TO DRILL WELL"

OWNER BAXER, BRETT O.K. (BB)  
STREET OR RFD 12416 Hooper Ct. TOWN FULTON  
SUBDIVISION \_\_\_\_\_ SECTION \_\_\_\_\_ LOT 2

**WELL LOG**  
Not required for driven wells

STATE THE KIND OF FORMATIONS PENETRATED, THEIR  
COLOR, DEPTH, THICKNESS AND IF WATER BEARING

DESCRIPTION (Use additional sheets if needed)	FEET		check if water bearing
	FROM	TO	
Dirt	0	8	
Med Brown	8	59	
Med Hard Gray	59	305	
X 2 305 Coas			

**GROUTING RECORD**

WELL HAS BEEN GROUTED (Circle Appropriate Box) **Y** **N**  
TYPE OF GROUTING MATERIAL (Circle one)  
CEMENT **CM** BENTONITE CLAY **BC**  
NO. OF BAGS 15 NO. OF POUNDS 150  
GALLONS OF WATER 375  
DEPTH OF GROUT SEAL (to nearest foot)  
from 2 ft. to 305 ft.  
(enter 0 if from surface)

**CASING RECORD**  
casing types insert appropriate code below  
**ST** STEEL **CO** CONCRETE  
**PL** PLASTIC **OT** OTHER

**MAIN CASING TYPE**  
Nominal diameter top (main) casing (nearest inch): 60  
Total depth of main casing (nearest foot): 70

**OTHER CASING (if used)**  
EACH CASING diameter inch depth (feet) from to

**SCREEN RECORD**  
screen type or open hole (insert appropriate code below)  
**ST** STEEL **BR** BRASS **HO** OPEN HOLE  
**PL** PLASTIC **OT** OTHER

**C2** DEPTH (nearest ft.)  
E 1 8 9 11 15 17 21  
A 2 23 24 26 30 32 36  
C 3 38 39 41 45 47 51  
S R E E N  
SLOT SIZE 1 \_\_\_\_\_ 2 \_\_\_\_\_ 3 \_\_\_\_\_  
DIAMETER OF SCREEN \_\_\_\_\_ (NEAREST INCH)  
from \_\_\_\_\_ to \_\_\_\_\_


GRAVEL PACK IF WELL DRILLED WAS FLOWING WELL INSERT F IN BOX 88 **88**

MDE USE ONLY (NOT TO BE FILLED IN BY DRILLER)  
T \_\_\_\_\_ (E.R.O.S.) W Q \_\_\_\_\_  
70 \_\_\_\_\_ 72 \_\_\_\_\_  
TELESCOPE CASING LOG INDICATOR OTHER DATA

**C3** **PUMPING TEST**

HOURS PUMPED (nearest hour) 8  
PUMPING RATE (gal. per min.) 11  
METHOD USED TO MEASURE PUMPING RATE \_\_\_\_\_  
WATER LEVEL (distance from land surface)  
BEFORE PUMPING 17 ft.  
WHEN PUMPING 22 ft.  
TYPE OF PUMP USED (for test)  
**A** air **P** piston **T** turbine  
**C** centrifugal **R** rotary **O** other (describe below)  
**J** jet **S** submersible

**PUMP INSTALLED**  
DRILLER INSTALLED PUMP (CIRCLE) (YES or NO) YES NO  
IF DRILLER INSTALLS PUMP, THIS SECTION MUST BE COMPLETED FOR ALL WELLS.  
TYPE OF PUMP INSTALLED PLACE (A,C,J,P,R,S,T,O) IN BOX 29 **29**  
CAPACITY: GALLONS PER MINUTE (to nearest gallon) 31  
PUMP HORSE POWER 37  
PUMP COLUMN LENGTH (nearest ft.) 43  
CASING HEIGHT (circle appropriate box and enter casing height)  
**+** above } LAND SURFACE (nearest foot)  
**-** below } 49

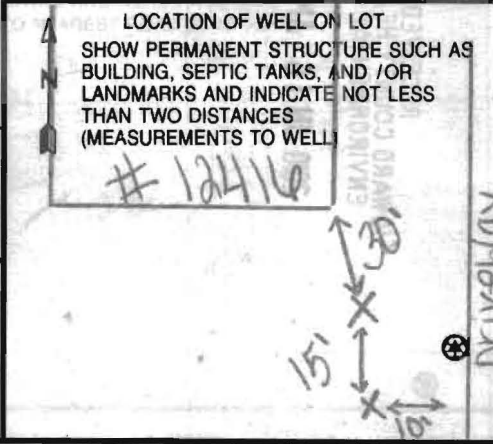

NUMBER OF UNSUCCESSFUL WELLS: 0  
WELL HYDROFRACTURED **Y** **N**

CIRCLE APPROPRIATE LETTER  
**A** A WELL WAS ABANDONED AND SEALED WHEN THIS WELL WAS COMPLETED  
**E** ELECTRIC LOG OBTAINED  
**P** TEST WELL CONVERTED TO PRODUCTION WELL

I HEREBY CERTIFY THAT THIS WELL HAS BEEN CONSTRUCTED IN ACCORDANCE WITH COMAR 26.04.04 "WELL CONSTRUCTION" AND IN CONFORMANCE WITH ALL CONDITIONS STATED IN THE ABOVE CAPTIONED PERMIT, AND THAT THE INFORMATION PRESENTED HEREIN IS ACCURATE AND COMPLETE TO THE BEST OF MY KNOWLEDGE.

DRILLERS LIC. NO. M D 353  
DRILLERS SIGNATURE (MUST MATCH SIGNATURE ON APPLICATION)  
LIC. NO. D 553

SITE SUPERVISOR (sign. of driller or journeyman responsible for sitework if different from permittee)

B 1 3141

SEQUENCE NO. (MDE USE ONLY)

STATE OF MARYLAND APPLICATION FOR PERMIT TO DRILL WELL

STATE PERMIT NUMBER

40-95-1858

532492 please type

fill in this form completely

Date Received (APA)

OWNER INFORMATION

Supreme Air, LLC
Owner
1205 Collinsway Road
Pattersonville, Md 21228

B 3 LOCATION OF WELL


Howard
8 COUNTY
Beaufort Park
23 SUBDIVISION
SECTION 4 LOT 2
52 NEAREST TOWN

DRILLER INFORMATION

Michael Barion MWD 355
Barion Well Drilling Service
522 Underwood Ln, Bel Air, Md

B 4

DIRECTION OF WELL FROM TOWN (CIRCLE BOX)

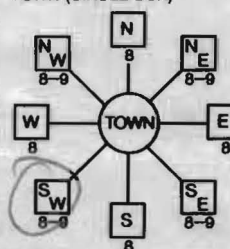

12116 Hooper Court
NEAR WHAT ROAD
ON WHICH SIDE OF ROAD (CIRCLE APPROPRIATE BOX)
DISTANCE FROM ROAD 20
ENTER FT OR MI
TAX MAP: 45 BLK: 12 PARCEL 48

B 2 WELL INFORMATION

APPROX. PUMPING RATE (GAL. PER MIN.) 0
AVERAGE DAILY QUANTITY NEEDED (GAL. PER DAY) 200

NOT TO BE FILLED IN BY DRILLER HEALTH DEPARTMENT APPROVAL

Howard 13 A17725
COUNTY NAME COUNTY NO.
STATE SIGNATURE INSERT S
DATE ISSUED 1/21/2010 Brian Baker 1/21/2011
CO SIGNATURE EXP. DATE
NORTH GRID 476 000 EAST GRID 816 000

USE FOR WATER (CIRCLE APPROPRIATE BOX)

- DOMESTIC POTABLE SUPPLY & RESIDENTIAL IRRIGATION
FARMING (LIVESTOCK WATERING & AGRICULTURAL IRRIGATION
INDUSTRIAL, COMMERCIAL, DEWATERING
PUBLIC WATER SUPPLY WELL
TEST, OBSERVATION, MONITORING
GEO-THERMAL

APPROXIMATE DEPTH OF WELL 300 FEET

APPROXIMATE DIAMETER OF WELL 6 INCH

METHOD OF DRILLING (circle one)

- BORED (or Augered) JETTED
AIR-ROTary AIR-PERCussion ROTARY (Hydraulic Rotary)
CABLE REVERSE-ROTary DRIVE-POINT

REPLACEMENT OR DEEPEMED WELLS (CIRCLE APPROPRIATE BOX)

- THIS WELL WILL NOT REPLACE AN EXISTING WELL
THIS WELL WILL REPLACE A WELL THAT WILL BE ABANDONED AND SEALED
THIS WELL WILL REPLACE A WELL THAT WILL BE USED AS A STANDBY-CONTACT LOCAL APPROVING AUTHORITY FOR POLICY ON STANDBY WELLS
THIS WELL WILL DEEPEM AN EXISTING WELL

Not to be filled in by driller (MDE OR COUNTY USE ONLY)

APPROP. PERMIT NUMBER G
PERMIT No. 40-95-1858


SHOW MAJOR FEATURES OF BOX & LOCATE WELL WITH AN X

- SOURCES OF DRILLING WATER
1.
2.
3.

WRITE THE BOX NUMBER FROM THE MAP HERE


E 82016
N 48076

DRAW A SKETCH BELOW SHOWING LOCATION OF WELL IN RELATION TO NEARBY TOWNS AND ROADS AND GIVE DISTANCE FROM WELL TO NEAREST ROAD JUNCTION


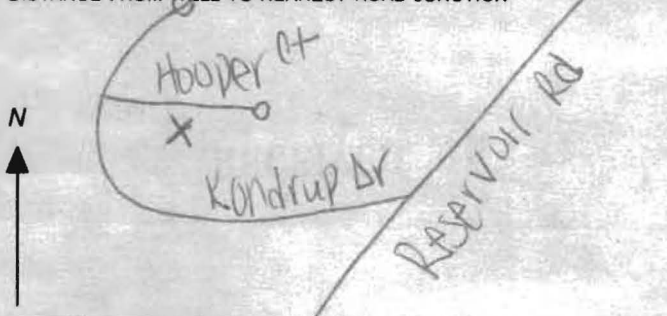


SPECIAL CONDITIONS

NOTE - APPROVING AUTHORITIES SHOULD USE SEPARATE SHEET IF NEEDED
Grant Boreholes from Bottom Up with Tremse Pipe

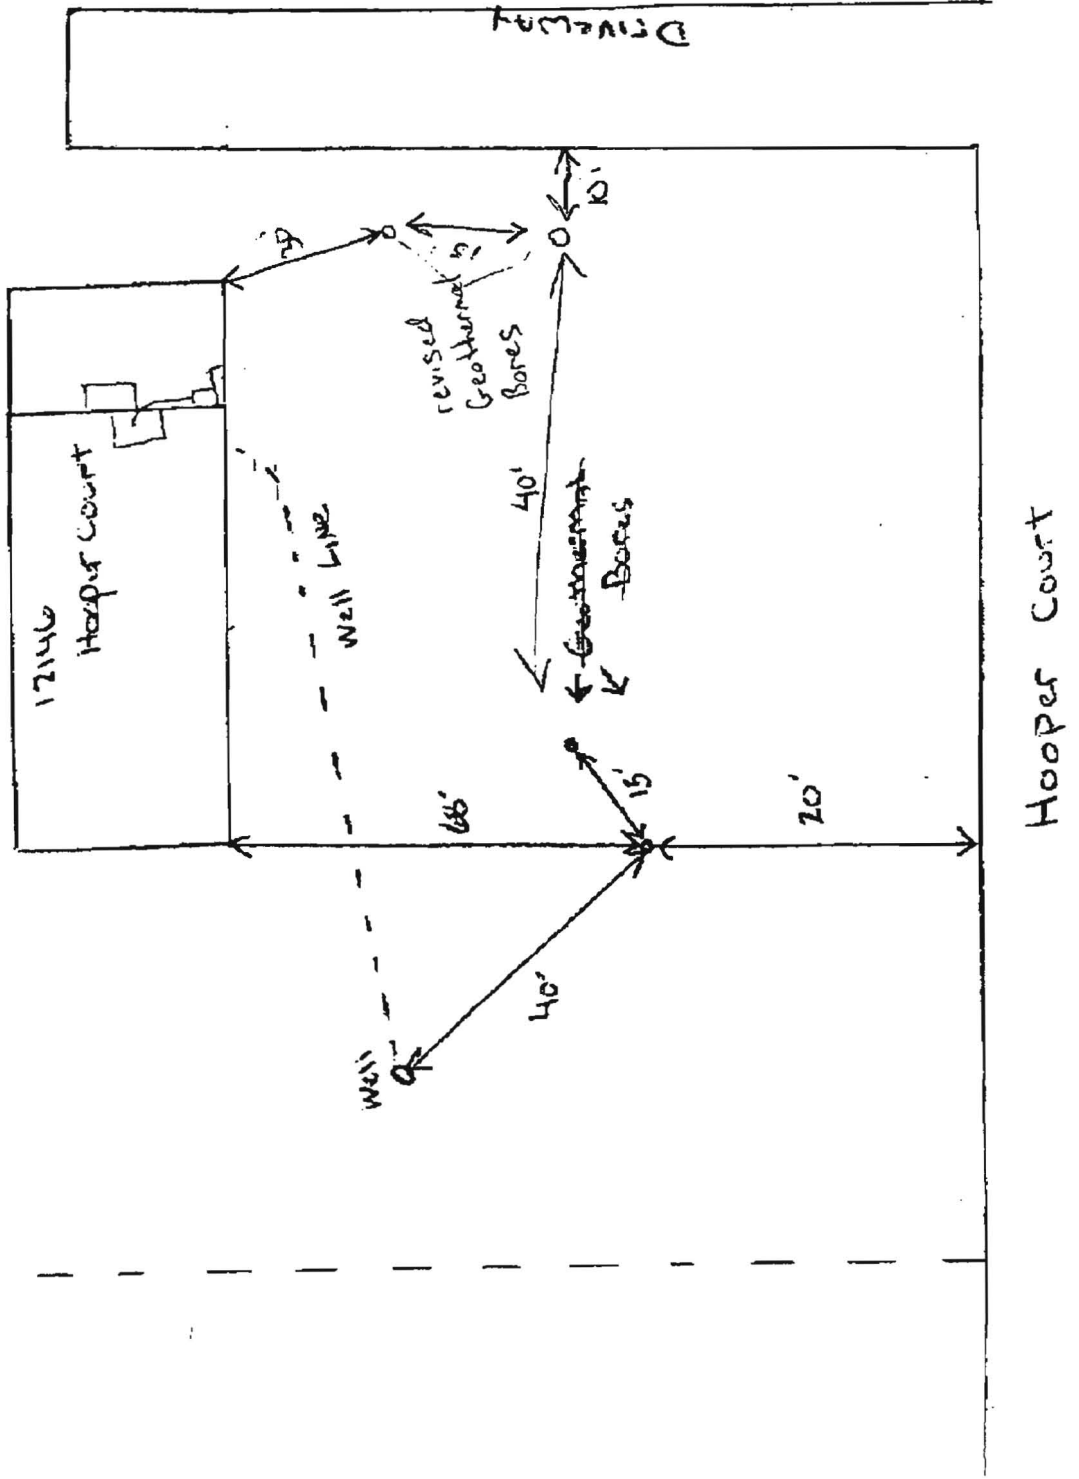

See

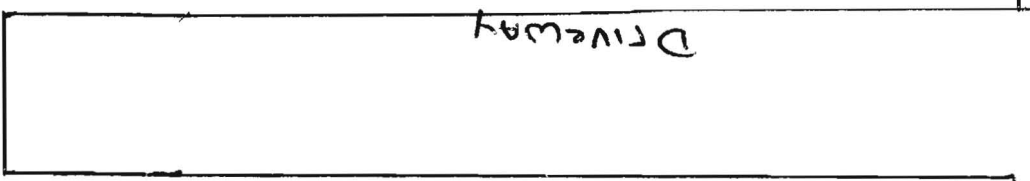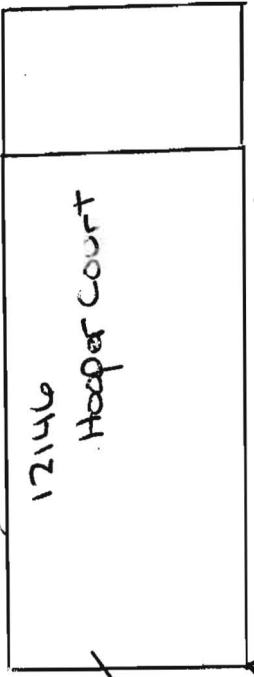

Hooper Court

100' x 100' to Septic

Well

Well Line

68'

40'

15'

20'

Geothermal Bores

