

PRELIMINARY

# APPLICATION

SEWAGE DISPOSAL TESTING

A 31875

STATE OF MARYLAND - DEPARTMENT OF HEALTH AND MENTAL HYGIENE

P \_\_\_\_\_

HOWARD COUNTY HEALTH DEPARTMENT  
ENVIRONMENTAL HEALTH SERVICES

DISTRICT 4th

P O BOX 473 ELLICOTT CITY, MARYLAND 21043  
TELEPHONE: 992-2330

DATE 4/13/82

TO: THE COUNTY HEALTH OFFICER  
ELLICOTT CITY, MARYLAND

I, HEREBY, APPLY FOR THE NECESSARY TEST IN ORDER TO CONSTRUCT (OR RECONSTRUCT) A SEWAGE DISPOSAL SYSTEM.

PROPERTY OWNER Hoods Mill Farms, Inc.

ADDRESS 12979 Clarksville Pike, Highland, Md. 20777 PHONE William Swann - 286-2608

PROPERTY LOCATION:

SUBDIVISION Hoods Mill Farm LOT NO. Parcel F

ROAD AND DESCRIPTION Route 97 (Applebaum is name on mail box - Look for red international flat bed truck at entrance on left hand side of road)

SIZE OF LOT 13 acres m/1 TYPE BLDG. 3 or 4 bedrooms  
(NUMBER OF BEDROOMS)

THE SYSTEM INSTALLED UNDER THIS APPLICATION IS ACCEPTABLE ONLY UNTIL PUBLIC FACILITIES BECOME AVAILABLE. I FULLY UNDERSTAND THE FEE CONNECTED WITH THE FILING OF THIS PERC TEST APPLICATION IS NON-REFUNDABLE UNDER ANY CIRCUMSTANCES. I ALSO AGREE TO COMPLY

WITH ALL M.O.S.H.A. REQUIREMENTS IN TESTING THIS LOT. /s/ William F. Swann  
(SIGNATURE OF APPLICANT)

APPROVED BY \_\_\_\_\_ FOR \_\_\_\_\_ DATE \_\_\_\_\_


REJECTED BY \_\_\_\_\_ FOR \_\_\_\_\_ DATE \_\_\_\_\_

HOLD PENDING FURTHER TESTS \_\_\_\_\_ DATE \_\_\_\_\_

REASONS FOR REJECTION OR HOLDING \_\_\_\_\_  
\_\_\_\_\_  
\_\_\_\_\_


# THIS IS NOT A PERMIT

SEC  
PLAY

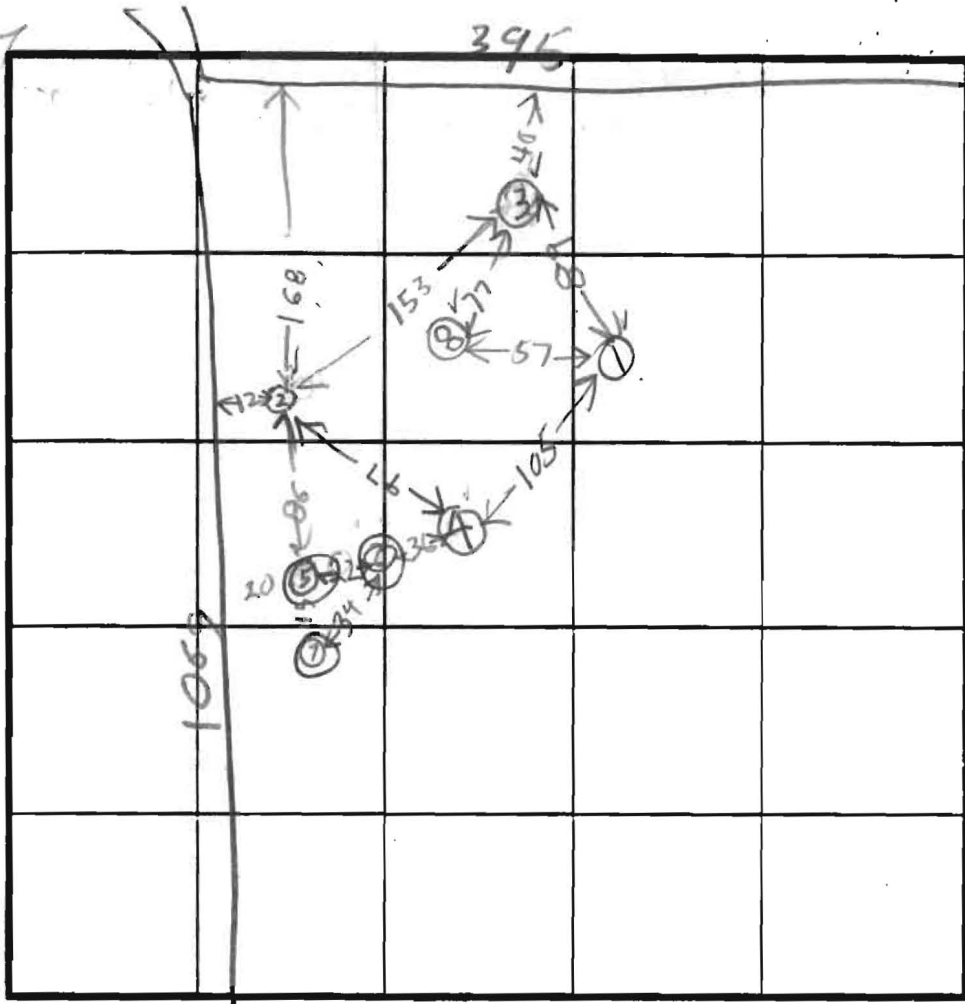

INDICATE NORTH - NAME ADJOINING ROADWAY AS BASE LINE.

①  
SOIL PROFILE

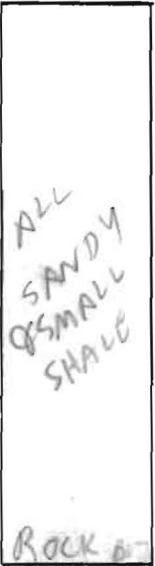

DATE	TEST NO.	DEPTH	PRE-WET		TEST - 1" DROP		TIME
			START	STOP	START	STOP	
4/13/82	1S	3 1/2	149	151	151	155	4
4/13/82	1D	1	ROCK SEE SOIL		PROFILE		
	2S	4	200	208	208	220	12
	2D	8	211	219	219	231	12
	3D	8	223	228	228	238	10
	3S	4	224	232	232	248	15
	4D	8	241	248	242	244	2
4/13/82	4S	3	242	243	243	246	3
	4V	9	SANDY SHALE ROCK BOTTOM				
	2V	12 1/2	ALL SANDY & SMALL SHALE				
	3V	11	ALL SANDY & SMALL SHALE				
	5V	7	ROCK BOTTOM				
	6V	7	"				
	7V	8	"				
	8V	12	SEE SOIL PROFILE				

REMARKS

TYPE OF SOIL

TESTED BY

R. HODGES

W. SWANN REAL ESTATE  
KETTERMAN BACK HOLE  
TALLEY REAL ESTATE  
BRULO VADEN BUYER

ALSO PRESENT  
(GEMPLER) DIM

- ② = HIGHEST
- ⑧③ = HIGH
- ① = LOW
- ④ = LOWEST
- ⑤⑥⑦ } ROCK

HOLE  
ELEV

12

11

0