

APPLICATION

FOR PERCOLATION TESTING AND SITE EVALUATION

TEST DATE(S) _____ TEST TIME _____

APR 5 2010 8-2

AGENCY REVIEW: _____

DATE 4/9/04

DO NOT WRITE ABOVE THIS LINE

I HEREBY APPLY FOR THE NECESSARY TESTING/EVALUATION PRIOR TO ISSUANCE OF SEWAGE DISPOSAL SYSTEM PERMIT(S) TO:

CHECK AS NEEDED:

- CONSTRUCT NEW SEPTIC SYSTEM(S)
- REPAIR/ADD TO AN EXISTING SEPTIC SYSTEM
- REPLACE AN EXISTING SEPTIC SYSTEM

CHECK AS NEEDED:

- NEW STRUCTURE(S)
- ADDITION TO AN EXISTING STRUCTURE
- REPLACE AN EXISTING STRUCTURE

CHECK ONE:

- CREATE NEW LOT(S)
- BUILD ON AN EXISTING LOT IN A SUBDIVISION
- BUILD ON AN EXISTING PARCEL OF RECORD

IS THE PROPERTY WITHIN 2500' OF ANY RESERVOIR?

- YES
- NO

THE TYPE OF STRUCTURE IS:

- RESIDENTIAL WITH UNKNOWN PROPOSED BEDROOMS IN THE COMPLETED STRUCTURE (NOTE UNKNOWN IF APPROPRIATE)
- COMMERCIAL (PROVIDE DETAIL OF NUMBERS AND TYPES OF EMPLOYEES/ CUSTOMERS ON ACCOMPANYING PLAN)
- INSTITUTIONAL/GOVERNMENT (PROVIDE DETAIL OF NUMBERS AND TYPES OF EMPLOYEES/USERS ON ACCOMPANYING PLAN)

PROPERTY OWNER(S) LDG Inc. J Lee Plaza

DAYTIME PHONE 301-585-7000 CELL _____ FAX _____

MAILING ADDRESS 3601 Georgia Ave. Silver Spring MD 20910
STREET CITY/TOWN STATE ZIP

APPLICANT Vanmar Associates Inc.

DAYTIME PHONE 301-829-2890 CELL _____ FAX _____

MAILING ADDRESS 310 South Main St. Mount Airy MD 21771
STREET CITY/TOWN STATE ZIP

APPLICANT'S ROLE: DEVELOPER BUILDER BUYER RELATIVE/FRIEND REALTOR CONSULTANT

PROPERTY LOCATION
SUBDIVISION/PROPERTY NAME Schwabe Farms LOT NO. 13

PROPERTY ADDRESS MD Route 32 West Friendship 21794
STREET TOWN/POST OFFICE

TAX MAP PAGE(S) 15 GRID 5 PARCEL(S) 12 PROPOSED LOT SIZE 1AC±

AS APPLICANT, I UNDERSTAND THE FOLLOWING: THE SYSTEM INSTALLED SUBSEQUENT TO THIS APPLICATION IS ACCEPTABLE ONLY UNTIL PUBLIC SEWERAGE IS AVAILABLE. THIS APPLICATION IS COMPLETE WHEN ALL APPLICABLE FEES AND A SUITABLE SITE PLAN HAVE BEEN RECEIVED. I ACCEPT THE RESPONSIBILITY FOR COMPLIANCE WITH ALL M.O.S.H.A. AND "MISS UTILITY" REQUIREMENTS. APPROVAL IS BASED UPON SATISFACTORY REVIEW OF A PERC CERTIFICATION PLAN.

TEST RESULTS WILL BE MAILED TO APPLICANT.

Danielle Stout

SIGNATURE OF APPLICANT


HOWARD COUNTY HEALTH DEPARTMENT, BUREAU OF ENVIRONMENTAL HEALTH, WELL AND SEPTIC PROGRAM
3525-H ELLICOTT MILLS DRIVE, ELLICOTT CITY, MARYLAND 21043-4544 (410) 313-1771 FAX (410) 313-2648
TDD (410) 313-2323 TOLL FREE 1-877-4MD-DHMH

AP

462
Brown L 1'
Red/Orange Sid 5'
Brown/Yellow micaceous sil 8'
Brown/Black IF mottles trace rock 11'
Water 12'

464
Brown L 1'
Red/Orange micaceous sil 5 1/2'
Yellow/Brown Orange micaceous sil trace rock 10 1/2'
Water 11'

463
Brown/Red L 1'
Red/Orange Brown micaceous sil 4 1/2'
Yellow/Brown micaceous sil 10'
mottles yellow/orange water 11'

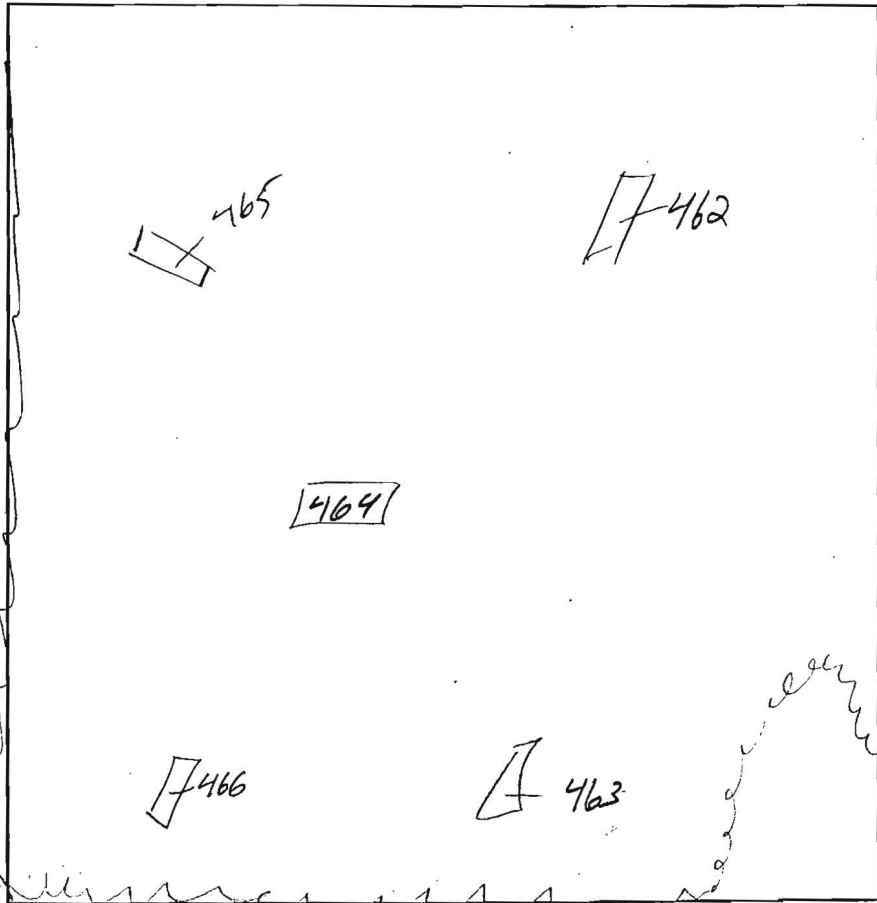

466
Brown L
Orange/Yellow sil 4 1/2'
Brown/Yellow micaceous sil 5 1/2'
Brown/Orange 8'
Water 11'

465
Brown L
Orange/Red Brown micaceous sil
Black/Brown micaceous sil
- trace rock -
Water 11'

DATE	TEST #	DEPTH	START	BREAK 1" DROP	STOP 2" DROP	TIME OF 2ND INCH	P/F/H
7/14/04	462	4 1/2' / 12'	12:09	- Pulled	12:39	-	F
	463	4 1/2' / 11'	12:23	12:34	12:48	1 1/4 min	P
	464	- 11' -	Visual	-			P
	466	3 1/2' / 11'	12:42	- Pulled	1:12	- Slow	F
	465	4' / 11'	12:48	12:59	1:12	13 min	P

REMARKS 466 could have perched H₂O table
 SANITARIAN KJR BACKHOE Justin OTHERS Zack
 TEST HOLES USED IN SDA _____ AVG. PERC TIME _____ SQ. FT/BR _____
 TRENCH WIDTH _____ INLET DEPTH _____ MAX. BOT DEPTH _____ EFFECTIVE SW _____

AP
544

Brown L	1/2'
Red/orange micaceous Scl	4'
Yellow/Brown micaceous sil w/ 15% qtz frags.	12'


534

Brown L	1/2'
Orange/Brown Red micaceous Scl	4'
Yellow/Brown micaceous sil w/ 10% Saprolite	13'

-moist-

535

Brown L	1'
Yellow/Brown Red scl w/ D-3 gray/orange mottling	4'
Yellow/Brown scl w/ D-3 mottling + 5% saprolite	6'

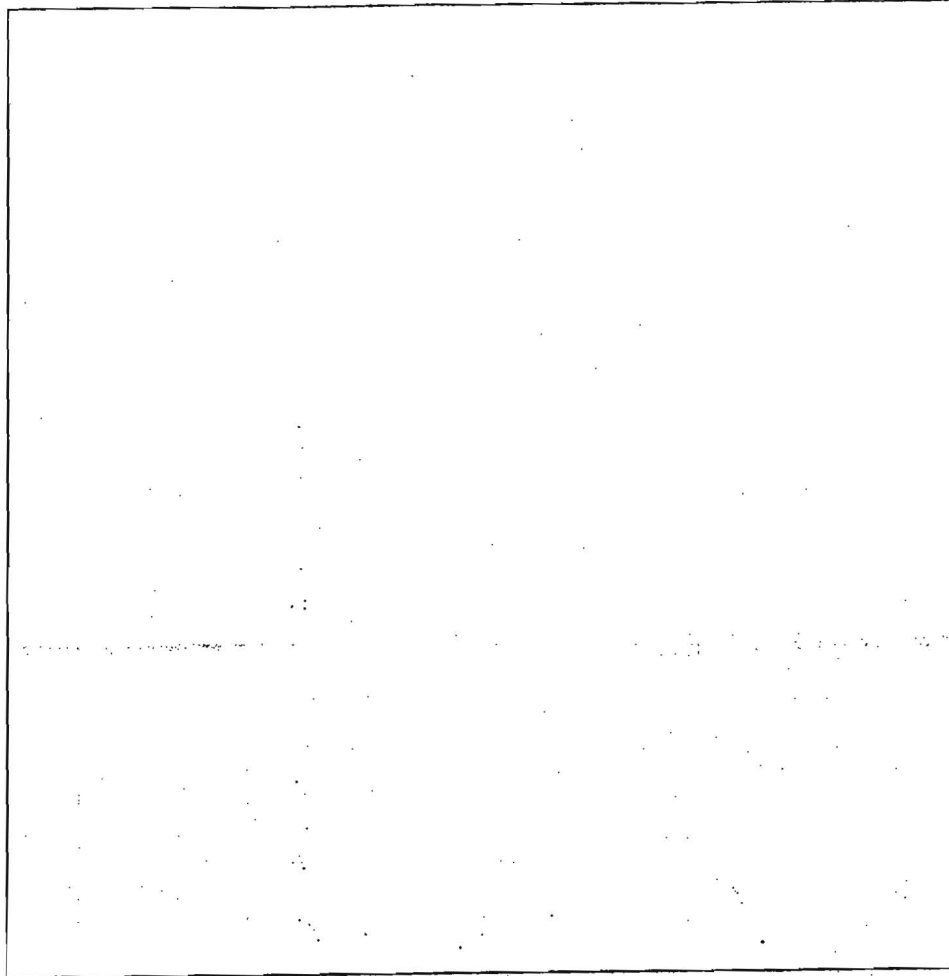

DATE	TEST #	DEPTH	START	BREAK 1' DROP	STOP 2' DROP	TIME OF 2nd INCH	P/F/H
11/3/04	544	4 1/2' / 12'	10:04	10:06	10:11	5 min	P
	534	4 1/2' / 13'	10:39	10:41	10:47	6 min	P
	535	- / 11'	Visual	-	-	H2O	F
	533	4 1/2' / 12'	11:20	11:22	11:24	2 min	P
	A	4 1/2' / 12'	11:30	11:32	11:36	4 min	P
	536	5 1/2' / 15'	11:58	12:00	12:03	3 min	P

533

Brown L	1/2'
Red/orange Scl	4'
Yellow/Brown micaceous scl w/ 5% Saprolite	12'

A

Brown L	1'
Red/orange Brown Scl	4'
Yellow/Brown micaceous scl w/ 10% Saprolite	12'

536

Brown L	1'
Brown/Yellow non Scl	5'
Brown/Yellow micaceous scl w/ 10% saprolite	11'
Water	13'

REMARKS all notes dug per plan.
 SANITARIAN KJB BACKHOE Justin OTHERS _____