

PERMIT

SEWAGE DISPOSAL SYSTEM

MARYLAND STATE DEPARTMENT OF HEALTH*

P 35703

A 33667

HOWARD COUNTY

BUREAU OF ENVIRONMENTAL HEALTH
992-2330

ELLICOTT CITY

DISTRICT 4th

DATE 3/8/85

INDEXED

LOT 2 HINZMAN
PROPERTY
F96-104

Randy Hinzman IS PERMITTED TO INSTALL ALTER

ADDRESS 3760 Jennings Chapel road PHONE _____

SUBDIVISION Hoods Mill Farm ROAD 820 Hoods Mill LOT Parcel E

PROPERTY OWNER Randy Hinzman

ADDRESS _____

IF GARBAGE GRINDER IS USED INCREASE SEPTIC TANK CAPACITY BY 50% AND ABSORPTION AREA BY 22%.

GARBAGE GRINDER? YES _____ NO

SEPTIC TANK CAPACITY 1000 GALLONS NUMBER OF BEDROOMS 3

PER PLAT NOTE #24:
SEPTIC CROSSES
ONTO NEW LOT 3
& IS TO BE
REPLACED PRIOR
TO SALE OF
EITHER PROPERTY.

TRENCHES - 180 sq. ft. per bedroom. Trench to be 2 feet wide. Inlet 4 feet below original grade. Bottom maximum depth 9 feet below original grade. Effective area begins at 4 feet below original grade. 5 feet of stone below distribution pipe. LOCATION: Start the first trench at perc hole 2 which is located 300 feet from the rear 957.3' lot line and 100 feet southwest of the well. Run trench(s) along level ground toward the southeast corner of the lot. NOTE: No trench to exceed 100 feet in length. If more than one trench used, a distribution box is required. Call for inspection of trench(s) before and after gravel is installed. Provide 6" - 8" diameter cleanout and cap to grade or above on septic tank.

PLANS APPROVED BY C. Williams DATE 2/1/85

COVER NO WORK UNTIL INSPECTED AND APPROVED.

NEITHER THE HOWARD COUNTY COUNCIL NOR THE HEALTH DEPARTMENT IS RESPONSIBLE FOR THE SUCCESSFUL OPERATION OF ANY SYSTEM.

NOTE: IF TRENCH IS USED CALL FOR INSPECTION BEFORE AND AFTER PLACING GRAVEL IN TRENCH.

NOTE: NO DRY WELL SHALL EXCEED 15 FOOT IN DIAMETER. NO ABSORPTION TRENCH TO EXCEED 100 FEET IN LENGTH.

NOTE: ALL PIPE FROM HOUSE TO SEPTIC TANK MUST BE CAST IRON OR SCHEDULE 40 PVC OR ABS.

PERMIT VOID AFTER THREE YEARS.


NOTE: INSTALL STAND PIPE ON SEPTIC TANK AND DRY WELL. STAND PIPES MUST BE 6 INCHES IN DIAMETER. CAST IRON, CONCRETE OR TERRA COTTA, OR PVC OR ABS ACCEPTED. IF TOP OF SEPTIC TANK IS DEEPER THAN 3 FEET MANHOLE TO GRADE REQUIRED.

***INSTALLER IS RESPONSIBLE FOR OBTAINING FINAL APROVAL ON THIS PERMIT**

*CALL 992-2330 FOR INSPECTION OF SEPTIC SYSTEMS.

EH - 2-1082

A 33667

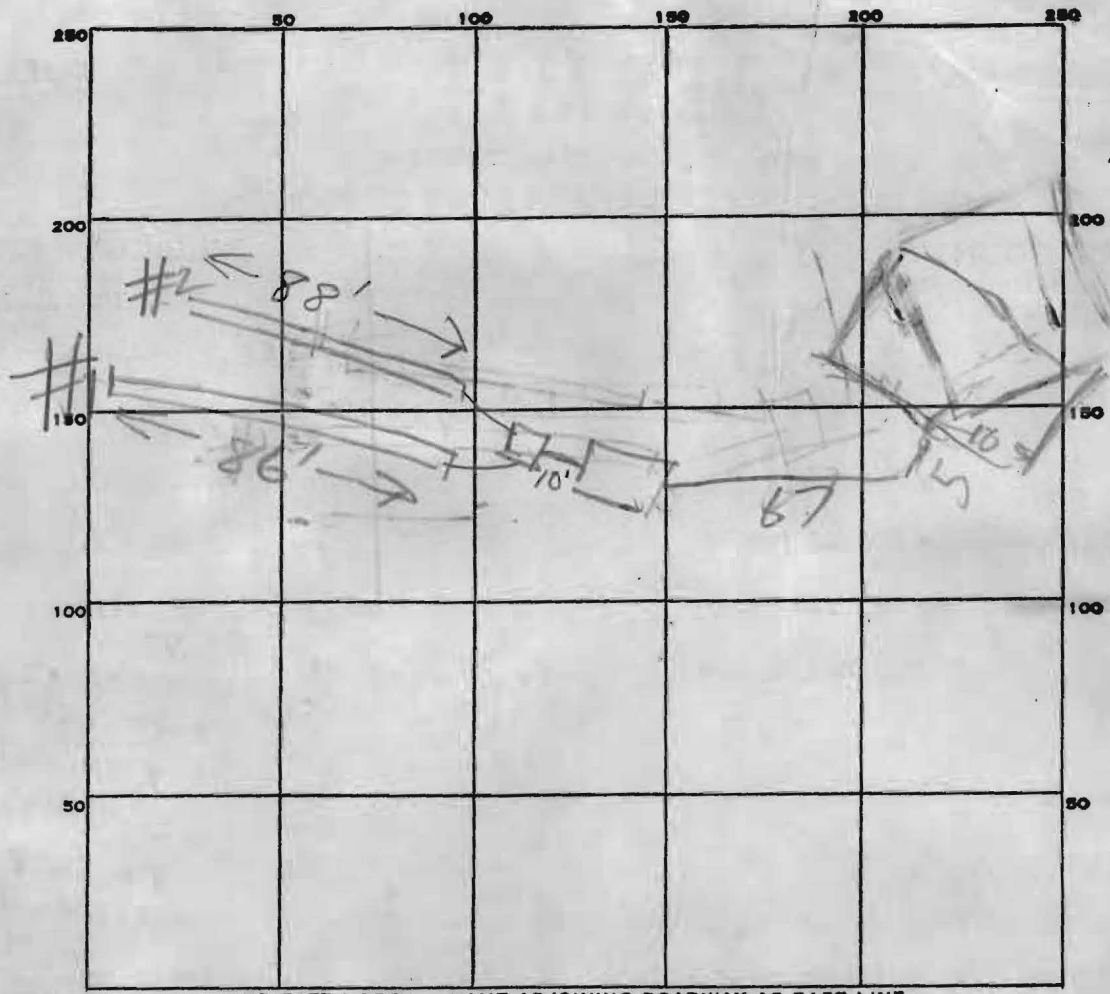

INDICATE NORTH. - NAME ADJOINING ROADWAY AS BASE LINE.

PERMIT CARD _____

SEPTIC TANK, LEVEL 1500

CLEANOUTS ST 20

DISTRIBUTION BOX, LEVEL #1 #2 OK

TILE FIELD, DEPTH #1 10 #2 2 FT. TRENCH WIDTH #1 2 #2 2 FT.

GRAVEL DEPTH #1 5 #2 5 IN. TOTAL LENGTH #1 86 #2 88 FT.

NUMBER OF TRENCHES 2 TOTAL BOTTOM AREA 870

174
5
870

SEEPAGE PITS, INSIDE DIAMETER _____ FT. DEPTH BELOW INLET _____ FT.

ABSORBENT AREA 870 SQ. FT.

REMARKS 6/3/85 OK LOCATION LOOKS SIMILAR TO PLANS. PAT LINDRIN: CAID TRENCH #2 WAS 9 FT DEEP & STONE & CRAIG SAID OK TO ADD STONE BEFORE INSPECTION 6/3/85 OK to cover all work

DATE SYSTEM APPROVED 6/3/85 INSPECTOR Stayer