

C.1 3116

SEQUENCE NO. (OEP USE ONLY)

STATE OF MARYLAND WELL COMPLETION REPORT

THIS REPORT MUST BE SUBMITTED WITHIN 45 DAYS AFTER WELL IS COMPLETED.

COUNTY NUMBER A 07875

(THIS NUMBER IS TO BE PUNCHED IN COLS. 3-6 ON ALL CARDS)

Date Received (OEP use only)

DATE WELL COMPLETED

2 20 83

Depth of Well

300

(TO NEAREST FOOT)

PERMIT NO.

FROM "PERMIT TO DRILL WELL"

40-73-4121

OWNER White last name Robert first name

STREET OR RFD 12800 Linden Church Road TOWN Clarksville

SUBDIVISION SECTION LOT

WELL LOG

Not required for driven wells

STATE THE KIND OF FORMATIONS PENETRATED, THEIR COLOR, DEPTH, THICKNESS AND IF WATER BEARING

DESCRIPTION (Use additional sheets if needed) FEET FROM TO Check if water bearing

Table with 3 columns: DESCRIPTION, FEET (FROM, TO), Check if water bearing. Contains handwritten entries: Sand 0-100, Gray mica rock 100-300.

GROUTING RECORD

WELL HAS BEEN GROUTED (Circle Appropriate Box) YES Y NO N. TYPE OF GROUTING MATERIAL CEMENT CM BENTONITE CLAY BC. NO. OF BAGS 20 NO. OF POUNDS 1800. GALLONS OF WATER 120. DEPTH OF GROUT SEAL (to nearest foot) from 0 ft. to 70 ft.

CASING RECORD

MAIN CASING TYPE ST Nominal diameter top(main)/casing (nearest inch) 6 Total depth of main casing (nearest foot) 105. OTHER CASING (if used) diameter inch depth (feet) from to.

SCREEN RECORD

screen type or open hole. insert appropriate code below. ST STEEL BR BRASS BRONZE PL PLASTIC HO OPEN HOLE OT OTHER.

C 2 (Seq. no.)

DEPTH (nearest ft.) 103 300. E A C H S C R E E N 1 40 2 3 3 39 41 45 47 51.

- CIRCLE APPROPRIATE BOX. A A WELL WAS ABANDONED AND SEALED WHEN THIS WELL WAS COMPLETED. E ELECTRIC LOG OBTAINED. P TEST WELL CONVERTED TO PRODUCTION WELL.

I HEREBY CERTIFY THAT THIS WELL HAS BEEN CONSTRUCTED IN ACCORDANCE WITH COMAR 10.17.13 "WELL CONSTRUCTION" AND IN CONFORMANCE WITH ALL CONDITIONS STATED IN THE ABOVE CAPTIONED PERMIT, AND THAT THE INFORMATION PRESENTED HEREIN IS ACCURATE AND COMPLETE TO THE BEST OF MY KNOWLEDGE.

DRILLERS IDENT. NO. 238

DRILLERS SIGNATURE (MUST MATCH SIGNATURE ON APPLICATION)

SITE SUPERVISOR (sign. of driller or journeyman responsible for sitework if different from permittee)

SLOT SIZE 1 2 3. DIAMETER OF SCREEN (NEAREST INCH) from to.

GRAVEL PACK IF WELL DRILLED WAS FLOWING WELL CIRCLE BOX F

OEP USE ONLY (NOT TO BE FILLED IN BY DRILLER). T (E.R.O.S.) W Q. TELESCOPE CASING LOG INDICATOR OTHER DATA.

C 3 (Seq. no.)

PUMPING TEST. HOURS PUMPED (nearest hour) 6.

PUMPING RATE (gal. per min. to nearest gal.) 2. METHOD USED TO MEASURE PUMPING RATE air.

WATER LEVEL (distance from land surface) BEFORE PUMPING 48.

WHEN PUMPING 130. TYPE OF PUMP USED (for test) A air P piston T turbine.

C centrifugal R rotary O other (describe below). J jet S submersible.

PUMP INSTALLED. DRILLER WILL INSTALL PUMP (CIRCLE APPROPRIATE BOX) YES Y NO N.


IF DRILLER INSTALLS PUMP, THIS SECTION MUST BE COMPLETED FOR ALL WELLS EXCEPT HOME USE.

TYPE OF PUMP (WRITE APPROPRIATE LETTER IN BOX - SEE ABOVE: (A, C, J, P, R, S, T, O)). CAPACITY: GALLONS PER MINUTE (to nearest gallon) 31 35.

PUMP HORSE POWER 37 41. PUMP COLUMN LENGTH (nearest ft.) 43 47.

CASING HEIGHT (circle appropriate box and enter casing height) above below 2 (nearest foot).

LOCATION OF WELL ON LOT. SHOW PERMANENT STRUCTURE SUCH AS BUILDING, SEPTIC TANKS, AND/OR LANDMARKS AND INDICATE NOT LESS THAN TWO DISTANCES (MEASUREMENTS TO WELL).

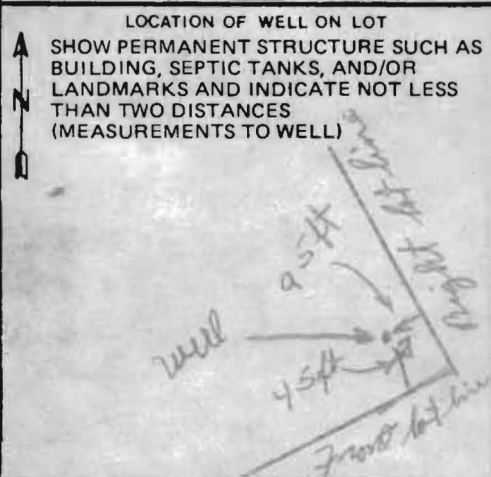

EMERGENCY/ TEMP NO. IF ANY H0-734121

B 1 7362 SEQUENCE NO. WRA USE ONLY
THIS NUMBER IS TO BE PUNCHED IN COLS. 3-6 ON ALL CARDS


STATE OF MARYLAND
APPLICATION FOR PERMIT TO DRILL WELL
please print or type

WRA PERMIT NUMBER
H0-73-4121
fill in this form completely

DATE RECEIVED 02-18-82
2/25/82 9:30 A.M. (WRA USE ONLY) 13
OWNER INFORMATION
White Robert
LAST NAME OWNER FIRST NAME
12800 Linden Church Rd.
STREET OR RFD
Clarksville Md.
TOWN STATE ZIP

B 3 LOCATION OF WELL
COUNTY Howard
SUBDIVISION
SECTION 46 LOT 48
NEAREST TOWN Clarksville
MILES FROM TOWN (enter 0 if in town) 3 8/10 **MI**

B 1 CONTINUED **DRILLER INFORMATION**
Joseph L. Mayne 238
DRILLER'S NAME LICENSE NO.
Joseph L. Mayne Feb 18, 82
SIGNATURE DATE

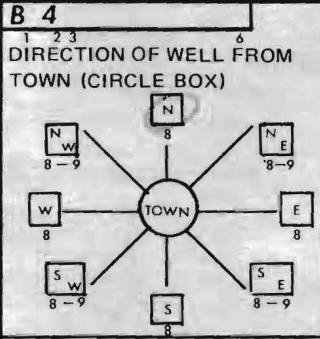


Linden Church Rd.
NEAR WHAT ROAD
ON WHICH SIDE OF ROAD (CIRCLE APPROPRIATE BOX) WEST EAST SOUTH NORTH
35
DISTANCE FROM ROAD (CIRCLE APPROPRIATE BOX) **FT**

B 2 WELL INFORMATION
APPROX. PUMPING RATE (GAL. PER MIN) 5
AVERAGE DAILY QUANTITY NEEDED (GAL. PER DAY) 750

SHOW LOCATION OF WELL WITH AN "X" IN THIS BOX
WRITE THE BOX NUMBER FROM THE MAP HERE
E 810 2
N 500 8

Locations OK
X
105' - casing
3' - above gr.
70' - open
20 - bags cement
2/25/82 JS

USE FOR WATER (CIRCLE APPROPRIATE BOX)
 HOME (SINGLE OR DOUBLE HOUSEHOLD UNIT ONLY)
 FARMING (LIVESTOCK WATERING & AGRICULTURAL IRRIGATION)
 INDUSTRIAL, COMMERCIAL, STATE AND FEDERAL GOV. OTHER (REQUIRES APPROPRIATION PERMIT)
 PUBLIC OR PRIVATE WATER COMPANY (REQUIRES APPROPRIATION PERMIT AND STATE HEALTH DEPARTMENT APPROVAL)
 TEST, OBSERVATION, MONITORING (MAY REQUIRE APPROPRIATION PERMIT)

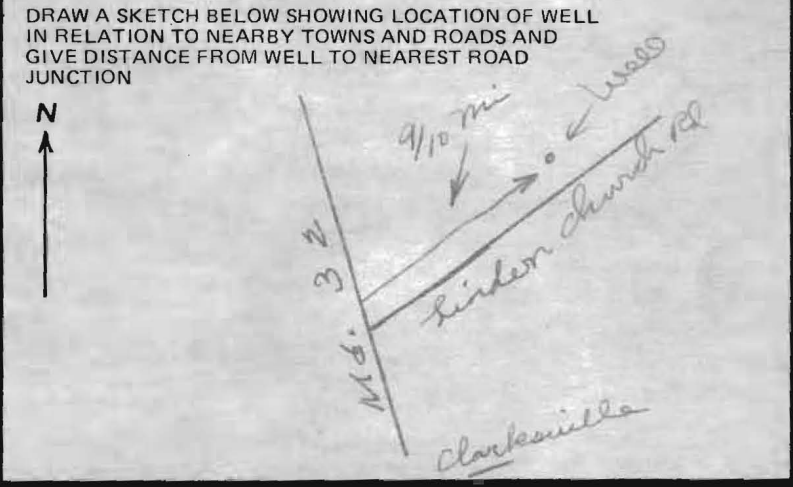

APPROXIMATE DEPTH OF WELL 200 FEET
APPROXIMATE DIAMETER OF WELL 6 INCH

Method of Drilling (circle one)
BORED (OR AUGERED) JETTED JETTED & DRIVEN
AIR ROTARY AIR-PERCUSSION ROTARY (HYDRAULIC) ROTARY
CABLE REVERSE ROTARY DRIVE POINT
other

REPLACEMENT OR DEEPEINED WELLS (Circle Appropriate Box)
 THIS WELL WILL NOT REPLACE AN EXISTING WELL
 THIS WELL WILL REPLACE A WELL THAT WILL BE ABANDONED AND SEALED
 THIS WELL WILL REPLACE A WELL THAT WILL BE USED AS A STANDBY
 THIS WELL WILL DEEPEIN AN EXISTING WELL
PERMIT NUMBER OF WELL TO BE REPLACED OR DEEPEINED (IF AVAILABLE)

B 4 NOT TO BE FILLED IN BY DRILLER HEALTH DEPARTMENT APPROVAL
HOWARD COUNTY NAME
A07875 COUNTY NO.
EHA SIGNATURE Frank Skinner STATE HEALTH SIGNATURE
MO DAY YR 02 18 82 DATE
NORTH 508 EAST 0812 ELEV. (FT.)
GRID 50 55 GRID 57 63 65 68

Not to be filled in by driller (WRA USE ONLY)
APPROX. PERMIT NUMBER GAP
FORCE INITIALS IN BOX ES CONDITIONS 40-73-401

B 5 SPECIAL CONDITIONS (WRA USE ONLY)

FILE Emergency Well Site Check

DATE REPORTED 2/17/82

PROPERTY OWNER Robert White Sr.

P.O. ADDRESS 12800 Linden Church Rd. TELEPHONE 854-0069

DIRECTIONS TO PROPERTY left side of road 2 story brick house

INFORMANT (son) - Layton White (789-8654) says had dry well

Joseph Mayne - 829-2164 to drill well


Septic area ~100' away from right rear corner of house

CONDITION FOUND 2/18/82 Talked with Mr. White Sr. Hand dug well dry. New well to be located 60 ft from right side of house and 40 ft from center of Linden Church Rd.

Handwritten notes:
J.S. ON
to 2/18/82 drawing of
10' ip

ACTION TAKEN

FINAL DISPOSITION

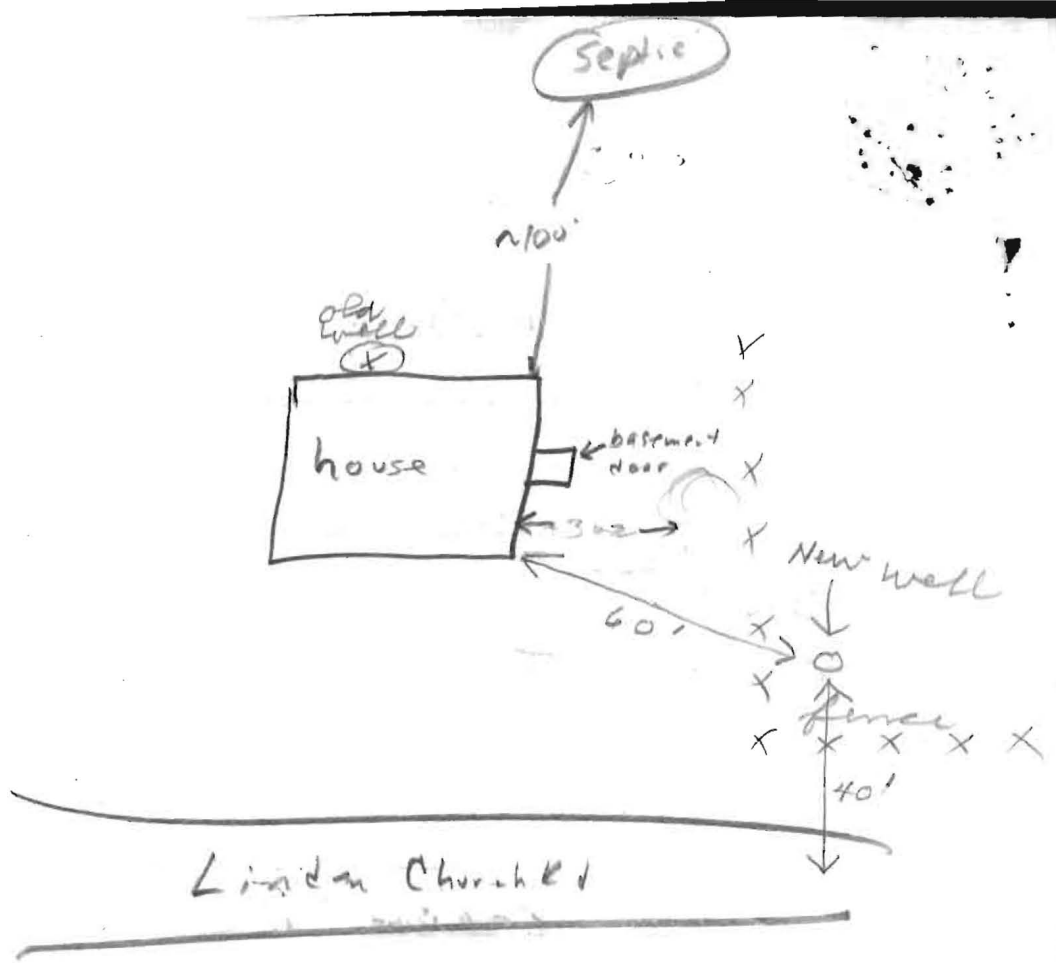

tag 40-73-4121
 given to Mrs. Mayne on 2/18/82