

5/5/64

PERMIT

approved
5/6/64

P 08072
A ~~07875~~
46498

SEWAGE DISPOSAL SYSTEM

MARYLAND STATE DEPARTMENT OF HEALTH

HOWARD COUNTY

INDEXED

ELLICOTT CITY

DISTRICT 3

DATE 2/27/64

5/5/64
Completed

Howard Triplett IS PERMITTED TO INSTALL ALTER

ADDRESS Rt. 3 - Mt. Airy, Md. PHONE Hu 9-4535

A SEWAGE DISPOSAL-SYSTEM LOCATED AT
12800 Linden Chapel Rd. - last house on left from new Rt. 32
Church

SUBDIVISION _____ ROAD _____ LOT _____

PROPERTY OWNER Robert White

ADDRESS Linden Chapel Rd.,

SPECIFICATIONS 4 bedrooms

DRAIN FIELD _____ DEPTH _____ FEET, BOTTOM AREA _____ SQ. FT.

SEEPAGE PITS _____ ABSORBENT SIDE-WALL AREA _____ SQ. FT.

SEPTIC TANK CAPACITY 1,000 GALLONS

FOR GARBAGE GRINDER, INCREASE DISPOSAL AREA 22% & TANK CAPACITY 50%.

OTHER Leaching bed - 400 sq. ft. bottom area. Place the bed 100 to 120 ft. behind the house. Keep tank at least 50 ft. from water well and use cast iron pipe within 50 ft. of the water well.


PLANS APPROVED BY Raymond Hodges DATE 12/17/63

FILL SEPTIC TANK AND DISTRIBUTION BOX WITH WATER BEFORE CALLING FOR AN INSPECTION. COVER NO WORK UNTIL INSPECTED AND APPROVED.

NEITHER THE HOWARD COUNTY COMMISSIONERS NOR THE HEALTH DEPARTMENT IS RESPONSIBLE FOR THE SUCCESSFUL OPERATION OF ANY SYSTEM.

Repair Perc for 5/6
46498

A 46498
09975

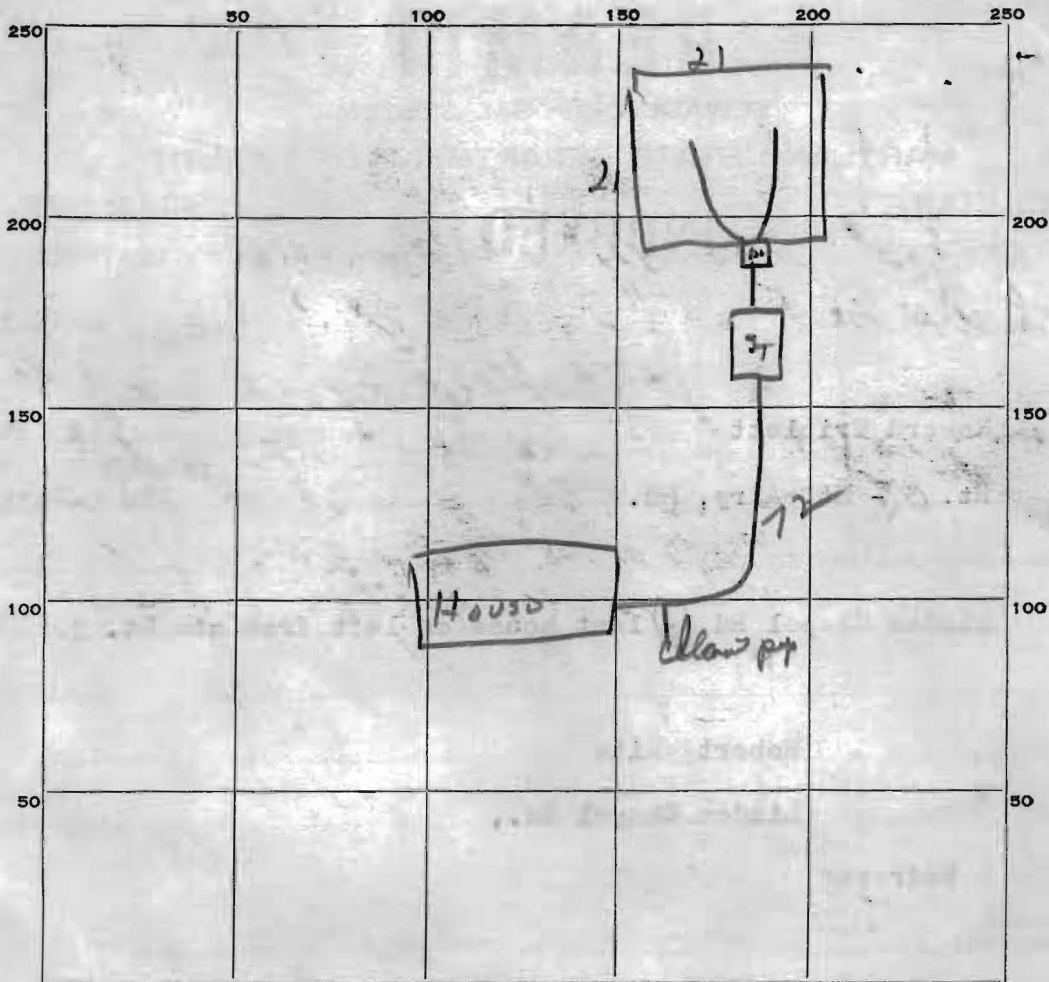

INDICATE NORTH. - NAME ADJOINING ROADWAY AS BASE LINE.

Linda Chapel R.

PERMIT CARD not posted

SEPTIC TANK, LEVEL line made - not complete

CLEANOUTS needs 8" diameter clean out pipe

DISTRIBUTION BOX, LEVEL OK

TILE FIELD, DEPTH 5 ft ^{I Bed} inches FT. TRENCH WIDTH 21 ^{I Bed} FT.

GRAVEL DEPTH 36 ^{I Bed} IN. TOTAL LENGTH 21 FT.

NUMBER OF TRENCHES _____ TOTAL BOTTOM AREA 441 sq ft

SEEPAGE PITS, INSIDE DIAMETER _____ FT. DEPTH BELOW INLET _____ FT.

ABSORBENT AREA _____ SQ. FT.

REMARKS 5/5/64 - I Bed has only 2 distribute lines - needs extra line.
OK to cover line from house to tank ~~sewer~~. Sept Tank need to be uninstalled
and need 8" diameter cleanout pipe ~~line~~
5/6/64 - I Bed OK with 5 line Sept tank OK.
cleanout OK

DATE SYSTEM APPROVED 5/6/64

INSPECTOR J. M. Murray