

# APPLICATION

LOT 3

PERCOLATION TESTING

A 46498  
P \_\_\_\_\_

HOWARD COUNTY HEALTH DEPARTMENT  
BUREAU OF ENVIRONMENTAL HEALTH  
P.O. BOX 476 ELLICOTT CITY, MARYLAND 21043  
TELEPHONE: 461-9933

*orig perc  
A 07825*

DISTRICT \_\_\_\_\_  
DATE 10-19-90  
~~9-28-90~~

TO: THE COUNTY HEALTH OFFICER  
ELLICOTT CITY, MARYLAND

I, HEREBY, APPLY FOR THE NECESSARY TEST IN ORDER TO CONSTRUCT (OR RECONSTRUCT) A SEWAGE DISPOSAL SYSTEM.

PROPERTY OWNER Robert White

ADDRESS 403 N. Fillmore Street-Arlington, Va. 22201 PHONE 1-708-243-2742

PROSPECTIVE BUYER Unknown

ADDRESS \_\_\_\_\_ PHONE \_\_\_\_\_

PROPERTY LOCATION:

SUBDIVISION Linden Subdivision, Lots 3-5 LOT NO. Existing 3

ROAD AND DESCRIPTION Linden Church Road, Approx. 2200' East of Intersection of  
Twelve Hills Road

TAX MAP 28 PARCEL # 293

SIZE OF LOT 3.04 Acres TYPE BLDG. S.F.D.  
(SINGLE FAMILY DWELLING OR COMMERCIAL)

THE SYSTEM INSTALLED UNDER THIS APPLICATION IS ACCEPTABLE ONLY UNTIL PUBLIC FACILITIES BECOME AVAILABLE. I FULLY UNDERSTAND THE FEE CONNECTED WITH THE FILING OF THIS PERC TEST APPLICATION IS NON-REFUNDABLE UNDER ANY CIRCUMSTANCES. I ALSO AGREE TO COMPLY WITH ALL M.O.S.H.A. REQUIREMENTS IN TESTING THIS LOT.

*Robert White*

(SIGNATURE OF APPLICANT)

APPROVED BY \_\_\_\_\_ FOR \_\_\_\_\_ DATE \_\_\_\_\_

REJECTED BY \_\_\_\_\_ FOR \_\_\_\_\_ DATE \_\_\_\_\_

HOLD PENDING FURTHER TESTS \_\_\_\_\_ DATE \_\_\_\_\_

REASONS FOR REJECTION OR HOLDING REPAIR PERC OR - HOLD FOR PLAT MR

*11/1/90*


# THIS IS NOT A PERMIT

*A 46498*

Lot #3

SOIL PROFILE

0' 0 Rq  
 SANDY  
 CLAY  
 LOAM  
 3-4'  
 orig pink  
 silt  
 loam  
 hi mica  
 5%  
 frags  
 could have  
 gone deeper  
 8'

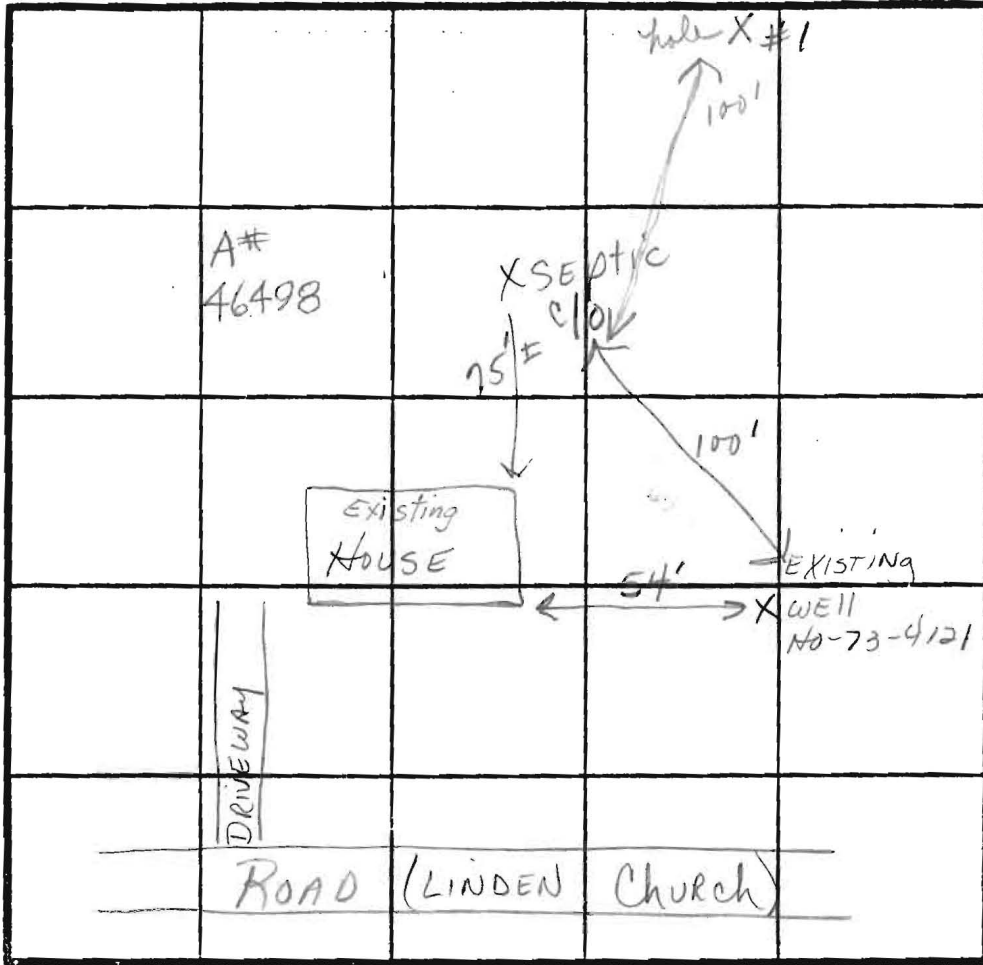

INDICATE NORTH - NAME ADJOINING ROADWAY AS BASE LINE.

DATE	TEST NO.	DEPTH	PRE-WET		TEST - 1" DROP		TIME
			START	STOP	START	STOP	
10-31-90	#1 ✓	8'	SEE	PROFILE			

Repair perc. for existing house for 1/3 of lot (#2) into 3 lots (#3, 4 & 5)

REMARKS \_\_\_\_\_

TYPE OF SOIL \_\_\_\_\_

TESTED BY JBG & MR

ALSO PRESENT Eng'r, owners Backhoe operator