

\*\*\*\*\*  
 WATER WELL ABANDONMENT-SEALING REPORT FORM  
 \*\*\*\*\*

SUBMIT COPIES OF COMPLETED FORM TO:

- \* COUNTY ENVIRONMENTAL AGENCY (contact MDE, WMA if address needed)
- \* WELL OWNER
- \* MDE, WATER MANAGEMENT ADMINISTRATION, WELL PROGRAM

OK  
 4/21/16 SC

DATE WELL ABANDONED: ~~APRIL~~ MARCH 7, 16 (month/day/year)

\* PERMIT NUMBER OF ABANDONED WELL (if any) NOT AG

\* PERMIT NUMBER OF REPLACEMENT WELL: HO - 15 - 0136

\* PERSON ABANDONING WELL: MARK RUTHERFORD WELL DRILLER'S LICENSE NUMBER: 554

CIRCLE: MWD / MSD / MGD


\* OWNER'S NAME: TOM EVANS

\* WELL LOCATION:  
 COUNTY: Howard  
 NEAREST TOWN: Simpsonville  
 TAX MAP 9035 BLOCK 19 PARCEL 0062  
 SUBDIVISION: \_\_\_\_\_  
 SECTION: \_\_\_\_\_ LOT: \_\_\_\_\_  
 STREET ADDRESS: 11915 HALL SHOP RD.

LATITUDE 39 . 18 5440

LONGITUDE 76 . 92 7687

SITE LOCATION MAP

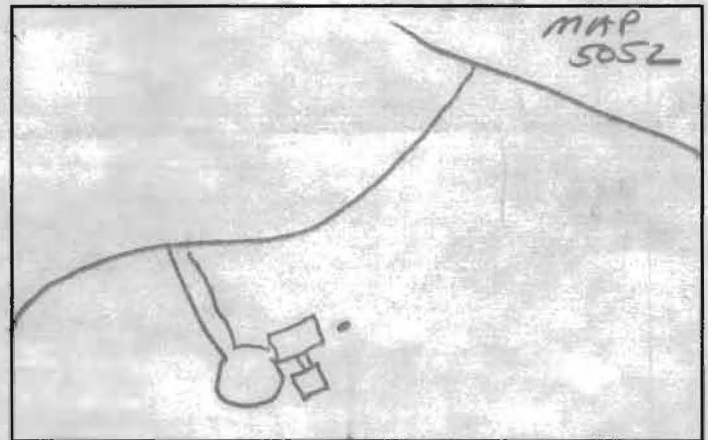

- \* TYPE OF WELL BEING ABANDONED:  
 DRILLED  JETTED  
 BORED  HAND DUG  
 OTHER (specify) \_\_\_\_\_

- \* USE CODE:  
 DOMESTIC  MUNICIPAL/PUBLIC  
 IRRIGATION  INDUSTRIAL  
 TEST/OBSERVATION  GEOTHERMAL

- \* TYPE OF CASING:  
 STEEL  PLASTIC  
 CONCRETE  OTHER (specify) \_\_\_\_\_

SIZE OF CASING: 6 1/4 INCHES IN DIAMETER

DEPTH OF WELL: 83 FEET DEEP

WAS ANY CASING REMOVED?  YES  NO  
 If yes, length removed, in feet: 2

WAS CASING RIPPED OR PERFORATED?  YES  NO

SIGNATURE-MASTER WELL DRILLER OR SUPERVISING SANITARIAN LICENSE#  
David Kelly

MWD / MSD / MGS

CIRCLE ONE

DATE

COUNTY

LOG OF SEALING MATERIAL

MATERIAL	FEET	
	FROM	TO
dirt	0	1
benonite hole plug	1	83
VOLUME OF MATERIAL USED		
<u>16.4 cu. ft. benonite</u>		