

MARYLAND DEPARTMENT OF THE ENVIRONMENT, WATER MANAGEMENT ADMINISTRATION
1800 Washington Blvd., Baltimore, Maryland 21230 (410) 537-3784

WATER WELL ABANDONMENT-SEALING REPORT FORM

SUBMIT COPIES OF COMPLETED FORM TO:

- * COUNTY ENVIRONMENTAL AGENCY (contact MDE, WMA if address needed)
- * WELL OWNER
- * MDE, WATER MANAGEMENT ADMINISTRATION, WELL PROGRAM

DATE WELL ABANDONED: 12/17/15 (month/day/year)

OK
4/21/16 SC

* PERMIT NUMBER OF ABANDONED WELL (if any) _____

* PERMIT NUMBER OF REPLACEMENT WELL: _____

* PERSON ABANDONING WELL: ROBERT COPSEY WELL DRILLER'S LICENSE NUMBER: 161

CIRCLE: MWD / MSD / MGD

* OWNER'S NAME: Glenn Mullinix

* WELL LOCATION:

COUNTY: HOWARD

NEAREST TOWN: ELLICOTT CITY

TAX MAP 0023 BLOCK _____ PARCEL 0012

SUBDIVISION: _____


SECTION: _____ LOT: _____

STREET ADDRESS: 10426 BALTIMORE NATIONAL PIKE

LATITUDE 3 9 . 1 6 5 8 1 4

LONGITUDE 7 6 . 5 2 2 4 6 3

SITE LOCATION MAP

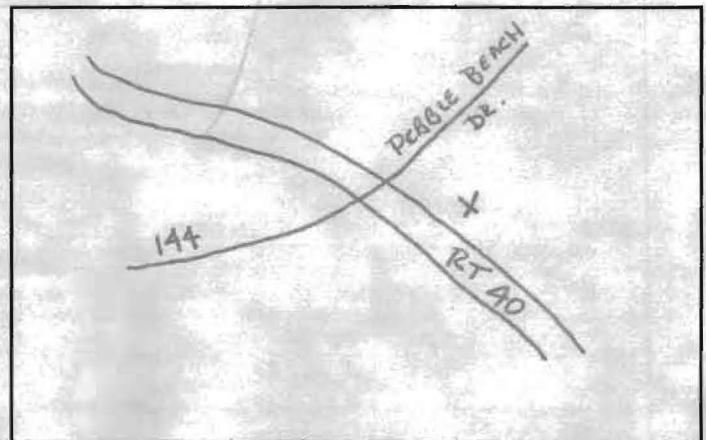

* TYPE OF WELL BEING ABANDONED:

☒ DRILLED ☐ JETTED
☐ BORED ☐ HAND DUG
☐ OTHER (specify) _____

* USE CODE:

☒ DOMESTIC ☐ MUNICIPAL/PUBLIC
☐ IRRIGATION ☐ INDUSTRIAL
☐ TEST/OBSERVATION ☐ GEOTHERMAL

* TYPE OF CASING:

☒ STEEL ☐ PLASTIC
☐ CONCRETE ☐ OTHER (specify) _____

SIZE OF CASING: 6" INCHES IN DIAMETER

DEPTH OF WELL: 90' FEET DEEP

WAS ANY CASING REMOVED? ☒ YES ☐ NO

If yes, length removed, in feet: 5

WAS CASING RIPPED OR PERFORATED? ☐ YES ☒ NO

LOG OF SEALING MATERIAL

MATERIAL	FEET	
	FROM	TO
Bentonite clay	90	5
VOLUME OF MATERIAL USED		
120 #lbs bentonite clay		

SIGNATURE-MASTER WELL DRILLER OR SUPERVISING SANITARIAN Robert R. Copsey LICENSE# 161

MWD / MSD / MGS 12/17/15

CIRCLE ONE

DATE

COUNTY