


SITE INSPECTION SHEET

OWNER: Nolan Miller PHONE #: 443-878-3001 / nolanm2@verizon.net
ADDRESS: 7010 Long View Rd. CONTRACTOR: _____
WELL TAG #: HO-81-0683
SUBDIVISION: Holiday Hills LOT: 7 COUNTY #: Howard
PROPOSAL: Keep well for irrigation after connecting to public water + sewer.

LOCATION DIAGRAM

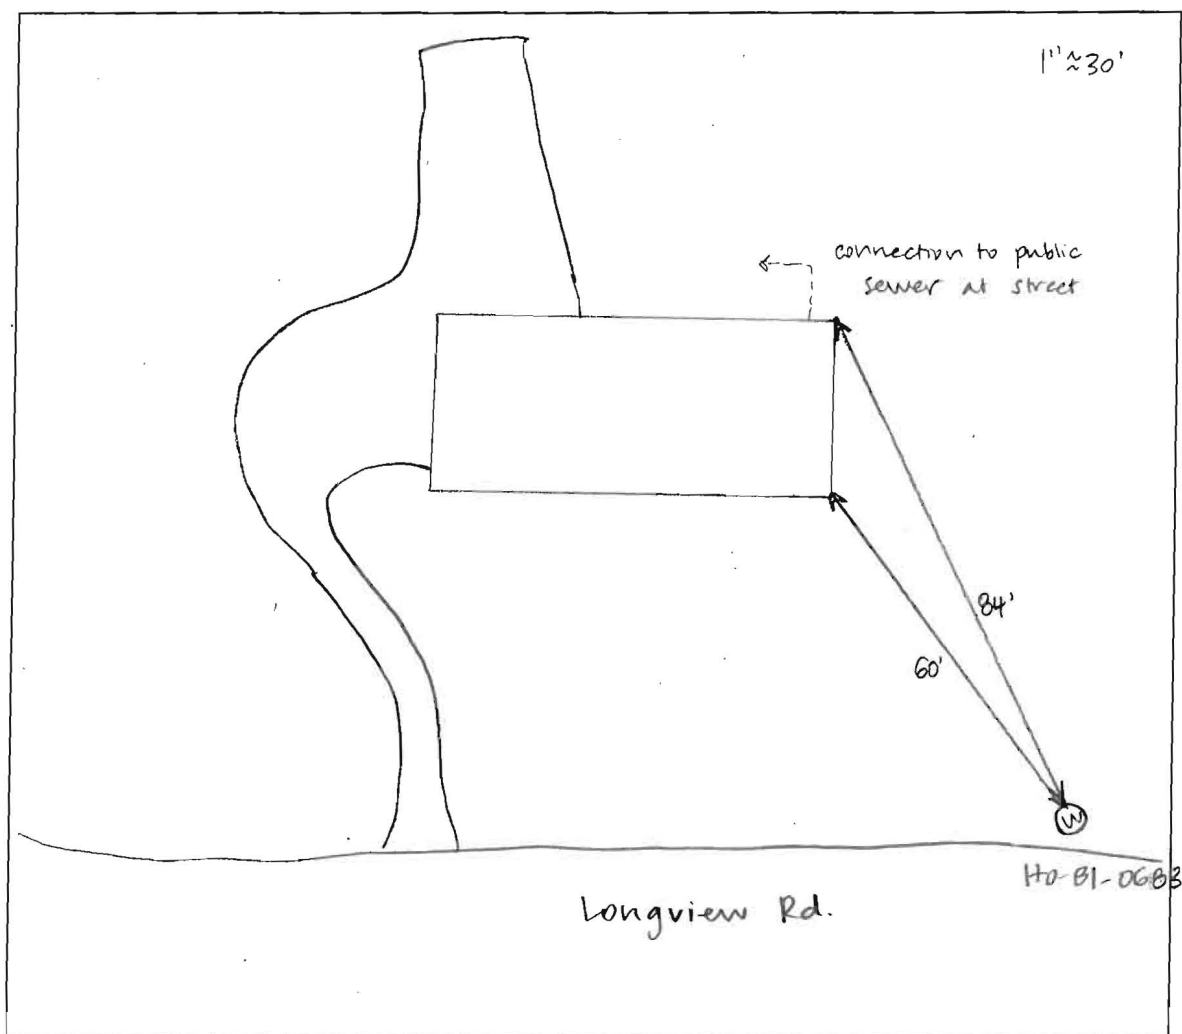

COMMENTS: Site visit to property. Well is 6" drilled, casing intact, cap + conduit secure. Tag HO-81-0683 attached. Contractor on site connecting property to public water + sewer. Mr. Miller will keep pump in well + use outdoor faucet for irrigation. OK to keep well.

DATE: 5/25/16 INSPECTOR: Sarah Collins



Bureau of Environmental Health

8930 Stanford Boulevard, Columbia, MD 21045

Main: 410-313-2640 | Fax: 410-313-2648

TDD 410-313-2323 | Toll Free 1-866-313-6300

www.hchealth.org

Facebook: www.facebook.com/hocohealth

Twitter: HowardCoHealthDep

Maura J. Rossman, M.D., Health Officer

MEMORANDUM

TO: Marian Curry

FROM: Michael J. Davis *mjd*
Assistant Director

RE: Refund, receipt # 57991, refunding \$506.00 for a perc test application at 11405 Butterfruit Way

DATE: May 16, 2016

Please submit the paperwork for a refund of \$506.00 to Jeff and Sheryl Goering, who paid \$506.00 for one perc test application at 11405 Butterfruit Way.

The perc test application fee is being refunded after it was determined that the testing was not required for the proposed property improvement.



HOWARD COUNTY HEALTH DEPARTMENT

57991

DATE 2/5/11

Received From

PHONE #

☐ CASH
☒ CHECK

NO.

For

Dollars

\$

Received By

711 sent Revision needed to Homeowner and applicant parcel post.