

5/2/89 PM }
No inspection

03-6300277

5/02 { HOLD SEE BELOW }

PERMIT

P 44608
A REPAIR

SEWAGE DISPOSAL SYSTEM

MARYLAND STATE DEPARTMENT OF HEALTH DISTRICT _____

HOWARD COUNTY
BUREAU OF ENVIRONMENTAL HEALTH
461-9933

TAX ID 03-300277

DATE 4/8/89

DATE SYSTEM APPROVED 5/26/89

INSPECTOR C Williams

INDEXED

Jack Fyock IS PERMITTED TO INSTALL _____ ALTER X

ADDRESS _____ PHONE 988-9270

SUBDIVISION _____ ROAD 3813 Ivory Road LOT _____

PROPERTY OWNER Staph, Frederick

ADDRESS 3813 Ivory Road
Glenely, Md 21737

IF GARBAGE GRINDER IS USED INCREASE SEPTIC TANK CAPACITY BY 50% AND ABSORPTION AREA BY 22%.

GARBAGE GRINDER? YES _____ NO _____

SEPTIC TANK CAPACITY _____ GALLONS NUMBER OF BEDROOMS _____

REPAIR - CALL FOR INSPECTION WHEN GROUND IS OPENED UP SO SANITARIAN CAN RECOMMEND REPAIR.

5/2/89 TO SEND MR. WILLIAMS A DRAWING ON
THIS AS PER A.M. INSTRUCTION. C.B.D.
(LEFT PERMIT WITH FYOCK'S MEN)

PLANS APPROVED BY C. Williams DATE 5/01/89

COVER NO WORK UNTIL INSPECTED AND APPROVED C.B.D. saw 5/2/89

NEITHER THE HOWARD COUNTY COUNCIL NOR THE HEALTH DEPARTMENT IS RESPONSIBLE FOR THE SUCCESSFUL OPERATION OF ANY SYSTEM

NOTE: CLEANOUT REQUIRED EVERY 70 FEET OF SEWER LINE AND/OR AT 90° SWEEPS IN LINES FROM HOUSE TO DRAIN FIELDS

NOTE: ALL PARTS OF SEPTIC SYSTEMS (I.E. TANK, DISTRIBUTION BOX, TRENCHES) TO BE 100 FEET FROM WELL (UNLESS OTHERWISE SPECIFICALLY AUTHORIZED)

NOTE: IF DEEP TRENCH(IES) ARE USED CALL FOR INSPECTION BEFORE AND AFTER PLACING GRAVEL IN TRENCH(IES)

NOTE: NO DRY WELL SHALL EXCEED 15 FOOT IN DIAMETER NO ABSORPTION TRENCH TO EXCEED 100 FEET IN LENGTH

NOTE: ALL PIPE FROM HOUSE TO SEPTIC TANK MUST BE CAST IRON OR SCHEDULE 40 PVC OR ABS

PERMIT VOID AFTER TWO YEARS

NOTE: INSTALL STAND PIPE ON SEPTIC TANK AND DRY WELL STAND PIPES MUST BE 6 INCHES IN DIAMETER CAST IRON, CONCRETE OR TERRA COTTA OR PVC OR ABS ACCEPTED. IF TOP OF SEPTIC TANK IS DEEPER THAN 3 FEET, MANHOLE TO GRADE REQUIRED

NOTE: DISTRIBUTION BOXES MUST HAVE BAFFLES


BUILDING PERMIT SIGNED AND RETURNED
102504-PORCH 2nd Story
3-03-05 BOD 152501-UP TANK

***INSTALLER IS RESPONSIBLE FOR OBTAINING FINAL APROVAL ON THIS PERMIT**

*CALL 461-9933 FOR INSPECTION OF SEPTIC SYSTEMS.

BLDG. PERMIT SIGNED AND RETURNED 3/4/91
Serial # 36735 - correct

44608

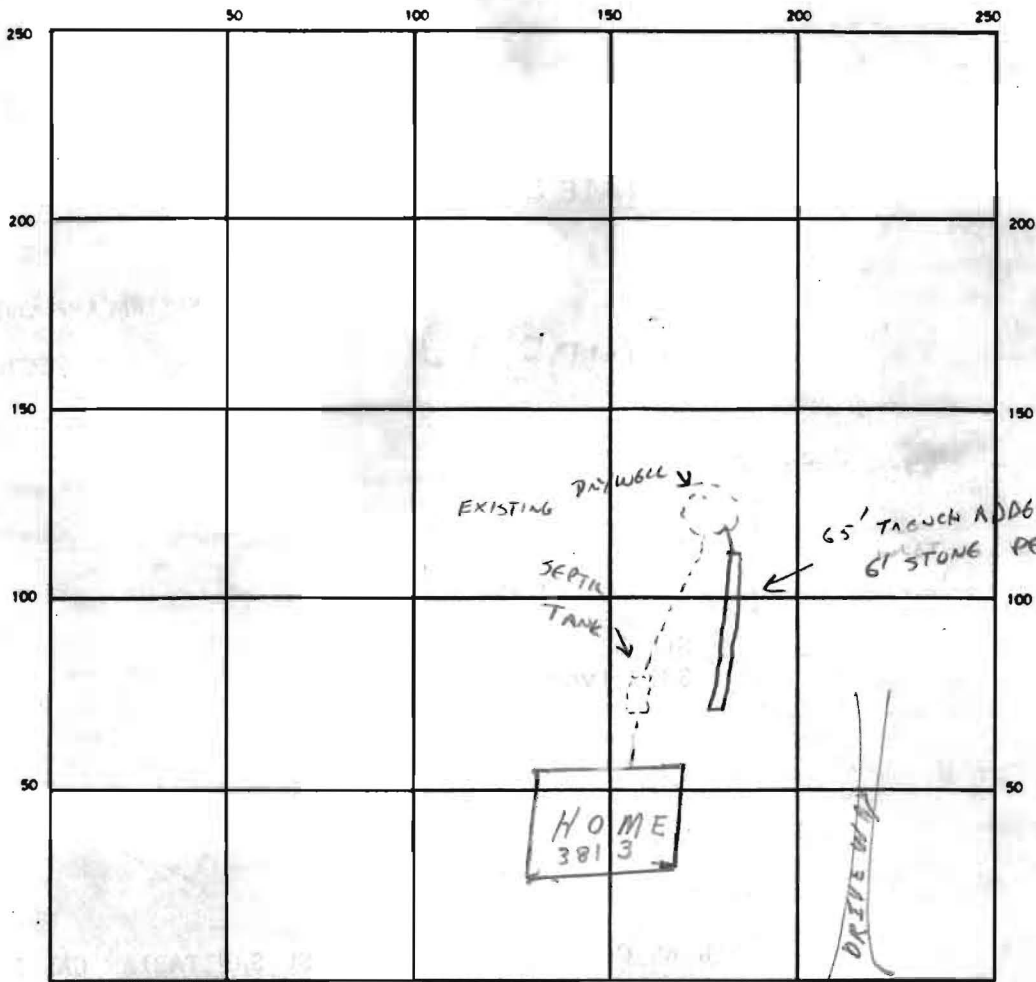

INDICATE NORTH - NAME ADJOINING ROADWAY AS BASE LINE

IVORY ROAD

SEPTIC TANK LEVEL EXIST. CLEANOUTS S.T. N/A

DISTRIBUTION BOX LEVEL N/A

DRAIN FIELD/TILE FIELD. DEPTH 11 FT. TRENCH WIDTH 2 FT. INLET DEPTH 5 FT.

EFFECTIVE GRAVEL DEPTH 6 FT. TOTAL LENGTH 65 FT.

NUMBER OF TRENCHES 1 ONE SIDEWALL/BOTTOM AREA 390 SQ. FT.

DRYWELL INSIDE DIAMETER _____ FT. EFFECTIVE DEPTH BELOW INLET _____ FT.

ABSORBENT AREA 390 + EXISTING SQ. FT.

REMARKS 5/26/89 M. - OK TO CONTINUE; REPAIR IN PROGRESS

HOLD FOR CERTIFIED DRAWING; Left info with
FYOCK'S MEN. C.B.D.

5/26/89 CONTRACTOR'S SKETCH REVIEWED OK - SYSTEM APPROVED C. Wellian

DATE SYSTEM APPROVED 5/26/89 INSPECTOR C. Wellian



HOWARD COUNTY HEALTH DEPARTMENT

P5 23487

DATE
10 / 13 / 2005

Received From

Walter Duester

PHONE # *410-489-6990*

3813 Ivory Road, Glenely MD 217

For *Repair Permit*



CASH



CHECK

3813 Ivory Road

NO.

One hundred sixty-five and 00/100 Dollars

\$

165 | 00

Received By *Mary L Buggs*