

PUB. SEWER STATUS VERIFIED BY _____

ISSUE DATE: 10/13/2005

PERMIT

P 523487

APPROVAL DATE: _____

A ~~REPAIR~~ upgrade

TAX ID# 03-300277

ON-SITE SEWAGE DISPOSAL SYSTEM HOWARD COUNTY HEALTH DEPARTMENT BUREAU OF ENVIRONMENTAL HEALTH

Walter Dustin IS PERMITTED TO INSTALL ALTER

ADDRESS: 3813 Ivory Road PHONE NUMBER: _____

SUBDIVISION: _____ LOT NUMBER: _____

ADDRESS: 3813 Ivory Road PROPERTY OWNER: Walter Dustin

SEPTIC TANK CAPACITY (GALLONS): 1500 2 Comp.

PUMP CHAMBER CAPACITY (GALLONS): _____

NUMBER OF BEDROOMS: _____

SQUARE FEET PER BEDROOM: _____

LINEAR FEET OF TRENCH REQUIRED: _____


TRENCHES:	Trench to be _____ feet wide. Inlet _____ feet below original grade. Bottom maximum depth _____ feet below original grade. Effective area begins at _____ feet below original grade. _____ feet of stone below distribution pipe.
LOCATION:	<u>Tank Depth not to exceed 3' deep</u>
PURPOSE:	Moving septic tank to accommodate building permit for deck. Call for inspection when ground is opened so sanitarian can recommend repair.

PLANS APPROVED: _____ DATE: _____

- NOTE: PERMIT VOID AFTER 2 YEARS
- NOTE: CONTRACTOR RESPONSIBLE FOR SCHEDULING A PRE-CONSTRUCTION INSPECTION FOR ALL INSTALLATIONS
- NOTE: WATERTIGHT SEPTIC TANKS REQUIRED
- NOTE: ALL PARTS OF SEPTIC SYSTEM SHALL BE 100 FEET FROM ANY WATER WELL
- NOTE: MANHOLE RISERS REQUIRED ON ALL SEPTIC TANKS AND PUMP CHAMBERS

NEITHER THE HOWARD COUNTY COUNCIL OR THE HEALTH DEPARTMENT IS RESPONSIBLE FOR THE SUCCESSFUL OPERATION OF ANY SYSTEM PERMITTEE RESPONSIBLE FOR OBTAINING FINAL APPROVAL ON THIS PERMIT CALL 410-313-2640 FOR INSPECTION OF SEPTIC SYSTEM

NOT TO SCALE

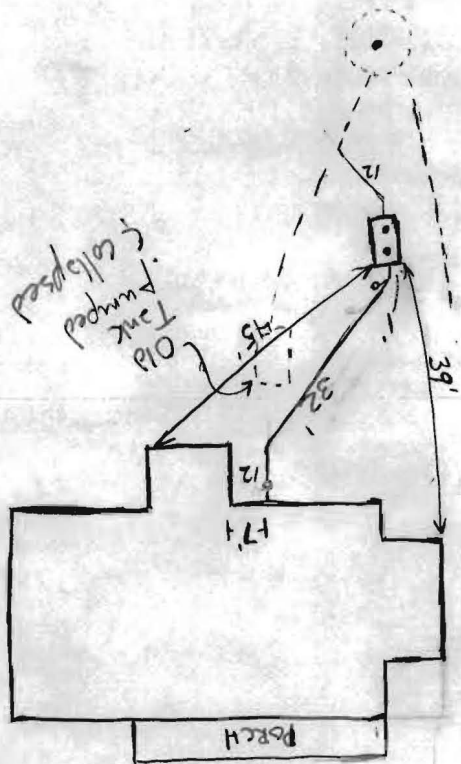

TRENCH/DRAINFIELD DATA		
WIDTH	INLET	BOTTOM
_____	_____	_____
NUMBER OF TRENCHES _____		
TOTAL LENGTH _____		
ABSORPTION AREA _____		
DISTRIBUTION BOX LEVEL _____		
DISTRIBUTION BOX BAFFLE _____		
DISTRIBUTION BOX PORT _____		

SEPTIC TANK DATA		
SEPTIC TANK 1 LEVEL	Yes _____	
CAPACITY	1500	GAL
SEAM LOC	Top	
TANK LID DEPTH	2.5'	
BAFFLES	Yes	
BAFFLE FILTER	N/A	
MANHOLE LOC	_____	
6" PORT LOC	In & Out	
WATERTIGHT TEST	_____	
SEPTIC TANK 2 LEVEL _____		
CAPACITY _____ GAL		
SEAM LOC _____		
TANK LID DEPTH _____		
BAFFLES _____		
BAFFLE FILTER _____		
MANHOLE LOC _____		
6" PORT LOC _____		
WATERTIGHT TEST _____		

IVORY

ROAD

PRE-CONSTRUCTION 5/11/06 New Septic tank installed.
Lines tied in, OK to cover. Old Tank pumped & collapsed

INSTALLATION OK for Deck BP!

FINAL INSPECTOR Rahnel A. Ring DATE OF APPROVAL 5/11/06



LH02-67-103 3813 IVORY RD GLENELG HOW 8/26/02 GOOZ Case#2002197

Fema Panel: 240044 0021B
Flood Zone: C
PARCEL OF LAND
1.869 AC +/-
Book: 5856
Folio: 340
Dist: 3
Co: HOWARD
MD
Scale 1" = 40'

10-25-04
NEED EXACT
MEASUREMENT
FROM PROPOSED
EXTENSION TO
S.T.
Well??

PLANS
to scale

IVORY RD. 50' R/W
N 46° 22' 9"E
194.56 feet

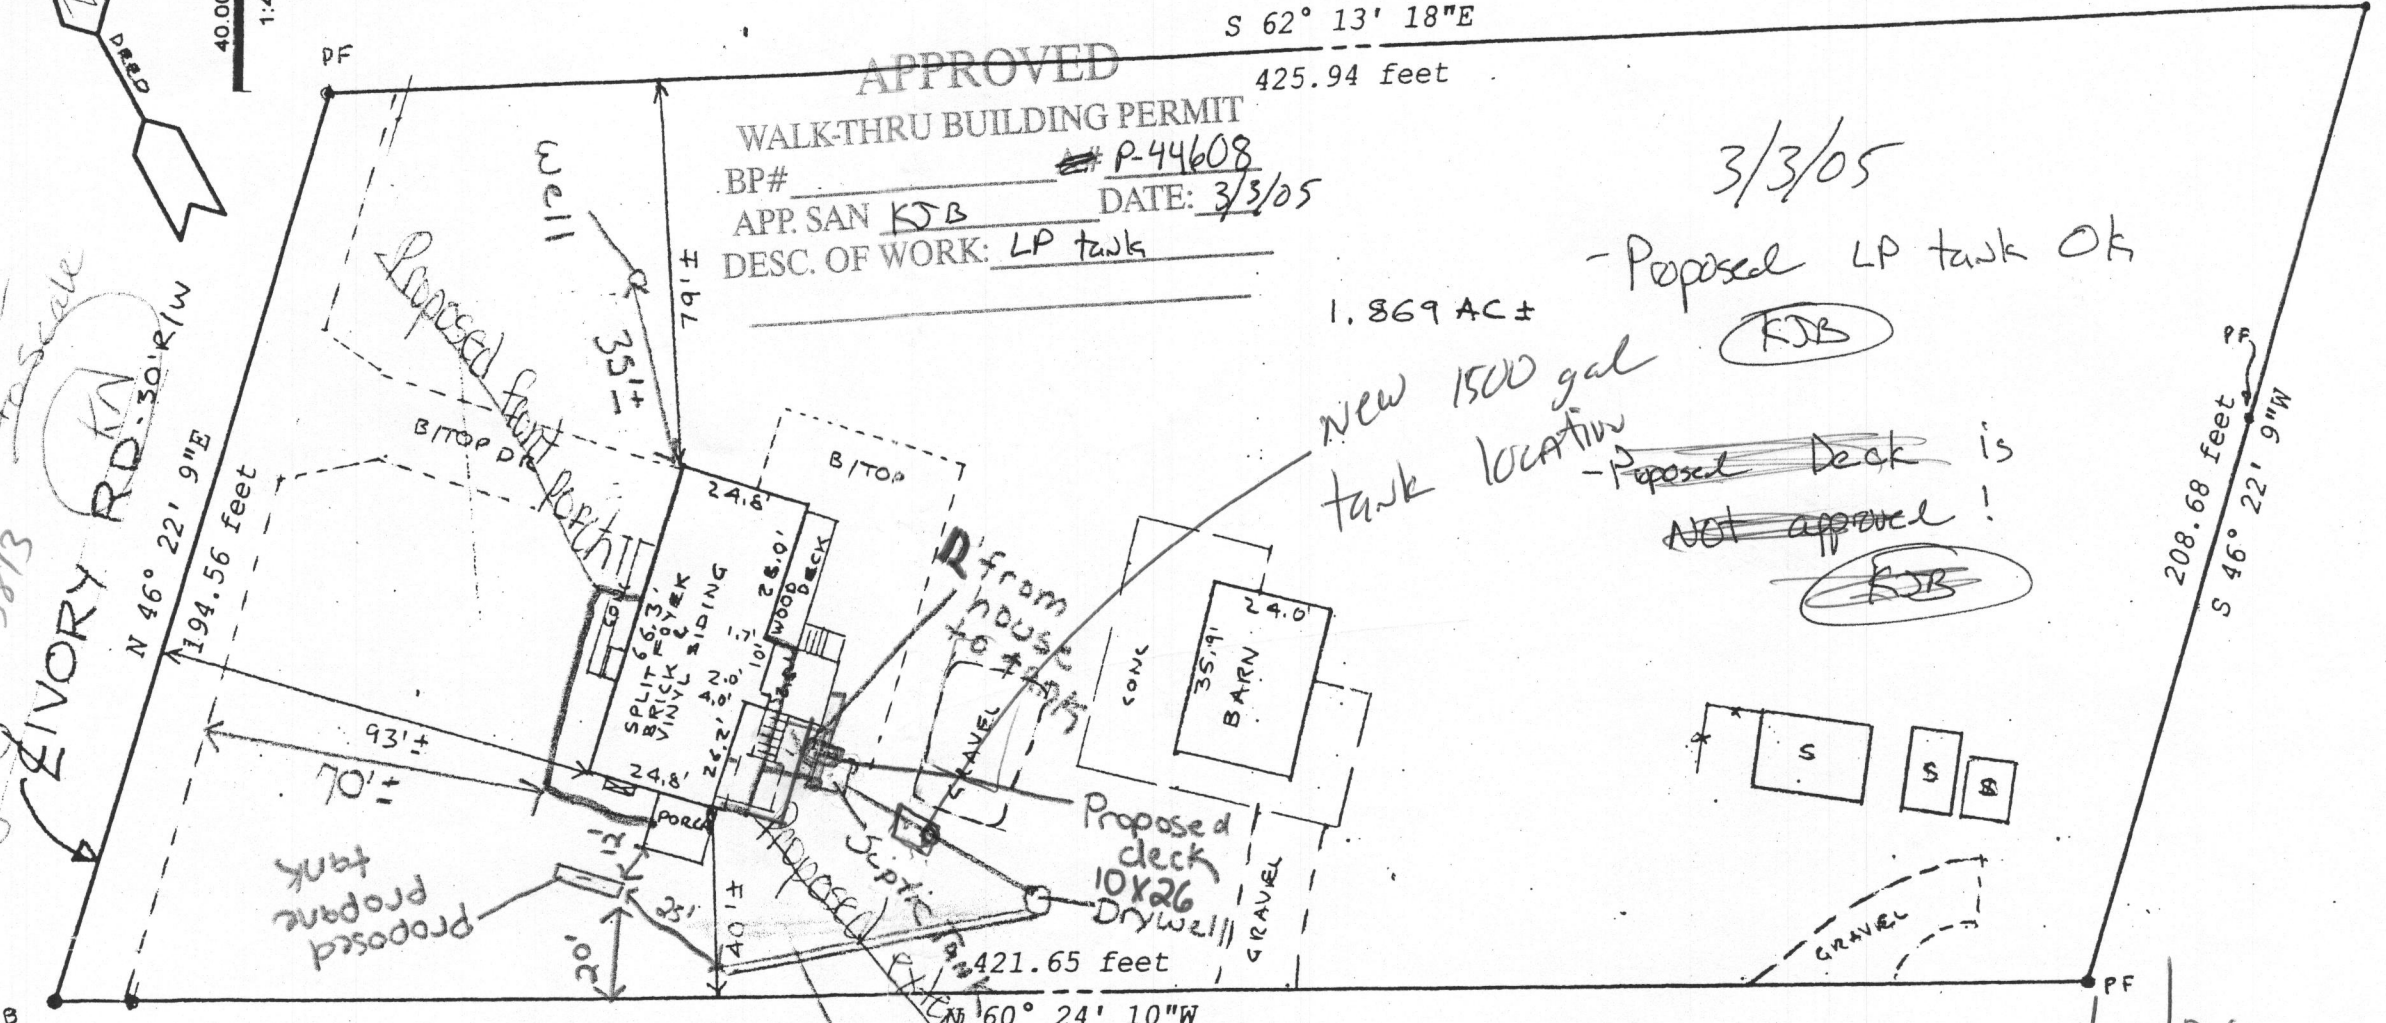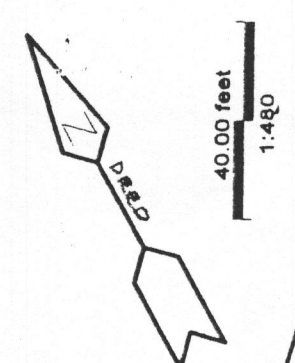

APPROVED
WALK-THRU BUILDING PERMIT
BP# A# P-44608
APP. SAN KJB DATE: 3/3/05
DESC. OF WORK: LP tank

1.869 AC ±
New 1500 gal tank location
- Proposed LP tank OK
KJB
- Proposed Deck is NOT approved!
KJB

10-27-04
Well and septic setbacks met

Drain field 65' long
6' of gravel

APPROVED
WALK-THRU BUILDING PERMIT
BP# 150792 A# P44608
APP. SAN KN DATE: 10-27-04
DESC. OF WORK: porch extensions

5/11/06
Deck proposal OK. Septic tank Moved.
GAC

Large Lots: Boundaries on larger lots may not all be inspected.
Accuracy: Approximate average accuracy (SD of sideline distances) for small suburban lots is two feet, and for large lots and metes and bounds parcels varies from two feet to twenty feet. In case of doubt, we recommend a Boundary Survey.

LEGEND
Shed (unsurveyed) [S]
Gravel Drive == == ==
Blacktop Drive =====
Concrete =====

This is an improvements Location Survey only, and must not be used for Boundary purposes. No Title Report furnished. No statement is made as to ownership of property or right or interest therein. Fences are approximate only and may not be shown. *Not to be used for construction purposes or permits of any kind whatsoever.*



E mail: surveyassociates@erols.com

LOCATION
MORTGAGE
SURVEY

SURVEY ASSOCIATES OF MARYLAND
4905 SUDLEY RD
WEST RIVER MARYLAND 20778
TEL 410 266 7211 FAX 410 266 0918
FAX BALTIMORE 410 841 6150
FAX METRO DC 301 970 2514