

11/19/76
before permit
if possible

PERMIT

P 24774
A _____

SEWAGE DISPOSAL SYSTEM

MARYLAND STATE DEPARTMENT OF HEALTH

HOWARD COUNTY

ELLICOTT CITY

INDEXED

DISTRICT 5

DATE 11/18/76

Jack Fyock IS PERMITTED TO INSTALL ALTER _____

ADDRESS 13775 Triadelphia Road., Glenelg, Maryland 21737 PHONE 988-9270

A SEWAGE DISPOSAL SYSTEM LOCATED AT _____

SUBDIVISION Holiday Hills ~~10802-10826~~ ROAD Hunting Lane LOT 62, Sec. 5

PROPERTY OWNER ~~W. Sykes~~ W. Sykes, Richard

ADDRESS 10826 Hunting Lane, Columbia, Md. Phone: 531-6270

SPECIFICATIONS 4 bedrooms

DRAIN FIELD _____ DEPTH _____ FEET, BOTTOM AREA _____ SQ. FT.

SEEPAGE PITS _____ ABSORBENT SIDE-WALL AREA _____ SQ. FT.

• SEPTIC TANK CAPACITY _____ GALLONS

FOR GARBAGE GRINDER, INCREASE DISPOSAL AREA 22% & TANK CAPACITY 50%.

OTHER REPAIR - Call for inspection when ground is opened up and Sanitarian will recommend repair system.

PLANS APPROVED BY Frank Palmer F. Wine DATE 11/18/76


FILL SEPTIC TANK AND DISTRIBUTION BOX WITH WATER BEFORE CALLING FOR AN INSPECTION. COVER NO WORK UNTIL INSPECTED AND APPROVED.

NEITHER THE HOWARD COUNTY COMMISSIONERS NOR THE HEALTH DEPARTMENT IS RESPONSIBLE FOR THE SUCCESSFUL OPERATION OF ANY SYSTEM.

BDDG. PERMIT SIGNED
AND RETURNED 8-1-89
Serial # 24674
above grant part

OG. PERMIT SIGNED
AND RETURNED 2/3/89
Serial # 23293

24774

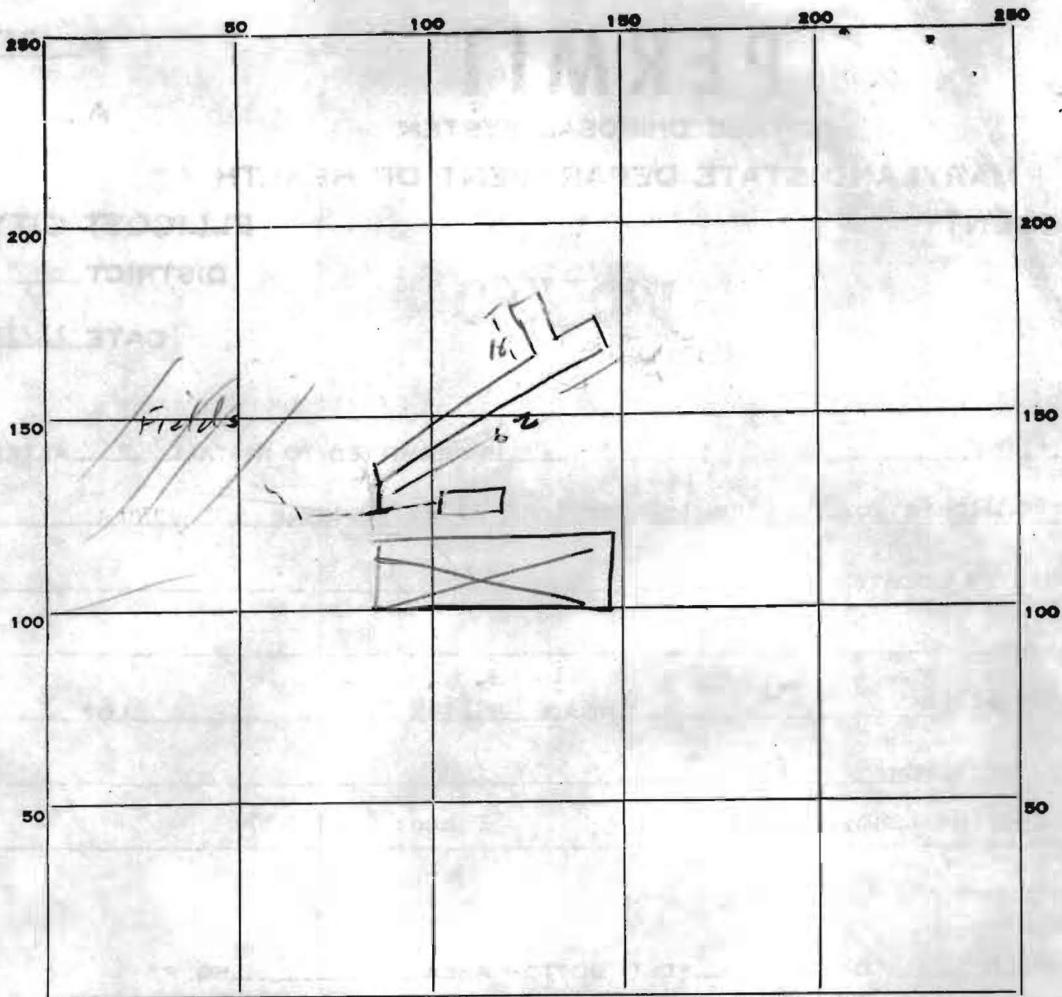

$$\begin{array}{r} 150 \\ 4 \overline{) 624} \\ \underline{20} \end{array}$$

PERMIT CARD 2

~~SEPTIC TANK, LEVEL~~ _____ CLEANOUTS _____

~~DISTRIBUTION BOX, LEVEL~~ _____

TILE FIELD, DEPTH 11 FT. TRENCH WIDTH 2 FT.

GRAVEL DEPTH 8 1/4 FT. TOTAL LENGTH 78 FT.

NUMBER OF TRENCHES 1 TOTAL BOTTOM AREA 624 ^{S. towel}

SEEPAGE PITS, INSIDE DIAMETER _____ FT. DEPTH BELOW INLET _____ FT.

ABSORBENT AREA 624 SQ. FT.

REMARKS _____




DATE SYSTEM APPROVED 11/19/76 INSPECTOR R. M. [Signature]

Rick & Cindy Sykes
 10826 Hunting He.
 Columbia, Md. 21044
 531-3187

Road
 (Holiday Hills)

PROPERTY LINE

PROPERTY LINE

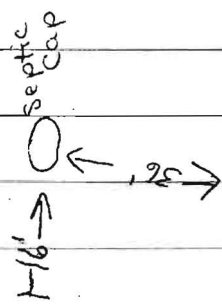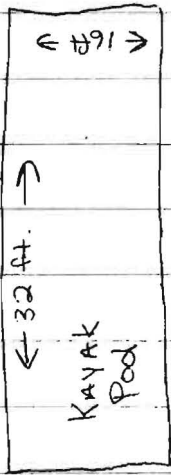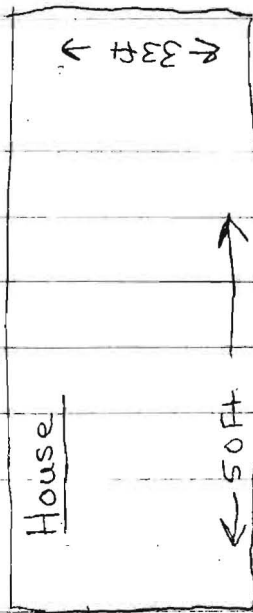

841

841

35

32 ft.

79

54

301

4/21/89
 P.M. Repair Septic + Pool conflict
 (?) on w/o (?)

ACB
 Repair near
 4/21/89
 (?)

(WOOD) PROPERTY LINE