

7/10/64

Approved
7/10/64
RF

PERMIT

P 08673

A 08037

SEWAGE DISPOSAL SYSTEM

MARYLAND STATE DEPARTMENT OF HEALTH

HOWARD COUNTY

ELLICOTT CITY

INDEXED

DISTRICT 5

DATE 6/29/64

Frank W. Robbins IS PERMITTED TO INSTALL ALTER

ADDRESS 112 Hunting Lane, Simpsonville, Md. PHONE AT 6-2534

A SEWAGE DISPOSAL-SYSTEM LOCATED AT _____

SUBDIVISION Holiday Hills ROAD Hunting Lane LOT 62, Sec. 5

PROPERTY OWNER ~~same as above~~ Richard J + Cynthia H. Syker.

ADDRESS _____

SPECIFICATIONS 4 bedrooms

DRAIN FIELD _____ DEPTH _____ FEET, BOTTOM AREA _____ SQ. FT.

SEEPAGE PITS _____ ABSORBENT SIDE-WALL AREA _____ SQ. FT.

SEPTIC TANK CAPACITY 1,000 GALLONS

FOR GARBAGE GRINDER, INCREASE DISPOSAL AREA 22% & TANK CAPACITY 50%.

OTHER Leaching bed - 400 sq. ft. bottom area installed with a depth of 5 ft. at part nearest front lot line. Place leaching bed in area between 120 and 150 ft. from front lot line and between 45 and 110 ft. from left side line as seen when facing lot from Hunting Lane. System must be installed in manner where sewage lift pump will not be used.


PLANS APPROVED BY R. D. Fletcher DATE 2/25/64

FILL SEPTIC TANK AND DISTRIBUTION BOX WITH WATER BEFORE CALLING FOR AN INSPECTION. COVER NO WORK UNTIL INSPECTED AND APPROVED.

NEITHER THE HOWARD COUNTY COMMISSIONERS NOR THE HEALTH DEPARTMENT IS RESPONSIBLE FOR THE SUCCESSFUL OPERATION OF ANY SYSTEM.

BUDG. PERMIT SIGNED
AND RETURNED 5/1/69
Serial #24674-001.

A 08037

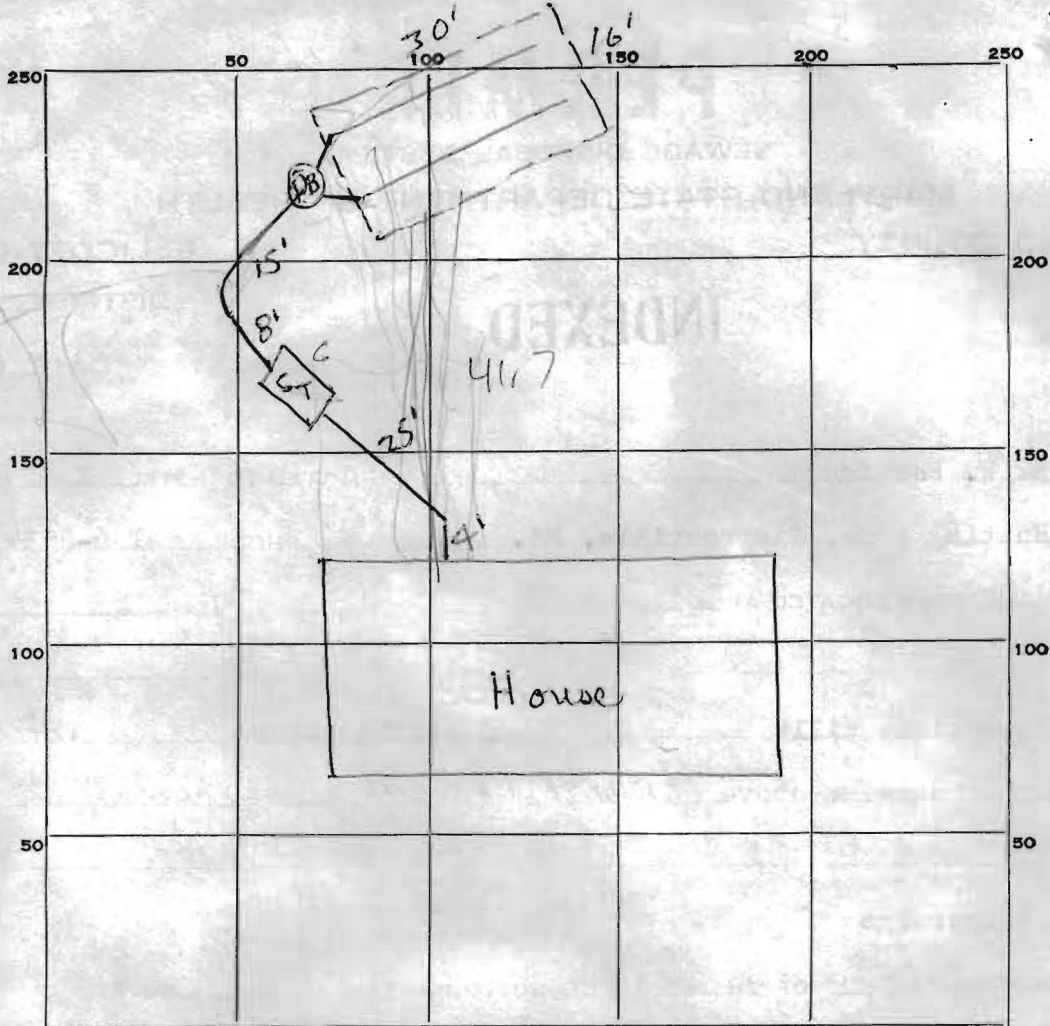

16
30
480

8.4
25

15

1521 3²
225 9 2
1746 =

c 41.7

INDICATE NORTH - NAME ADJOINING ROADWAY AS BASE LINE.

Hunting Lane

PERMIT CARD OK

SEPTIC TANK, LEVEL OK CLEANOUTS OK

DISTRIBUTION BOX, LEVEL OK

LB TILE FIELD, DEPTH 8 FT. TRENCH WIDTH 16 FT.

GRAVEL DEPTH 36 IN. TOTAL LENGTH 30 FT.

NUMBER OF TRENCHES _____ TOTAL BOTTOM AREA 480 sq. ft.

SEEPAGE PITS, INSIDE DIAMETER _____ FT. DEPTH BELOW INLET _____ FT.

ABSORBENT AREA _____ SQ. FT.

REMARKS _____

DATE SYSTEM APPROVED 7/10/64 INSPECTOR R. J. Lett