

APPLICATION

FOR PERCOLATION TESTING AND SITE EVALUATION

TEST DATE(S) _____ TEST TIME _____

APR 23 4 39

AGENCY REVIEW: _____

DATE 10/6/05

DO NOT WRITE ABOVE THIS LINE

03-293788

I HEREBY APPLY FOR THE NECESSARY TESTING/EVALUATION PRIOR TO ISSUANCE OF SEWAGE DISPOSAL SYSTEM PERMIT(S) TO:

- CHECK AS NEEDED:
- CONSTRUCT NEW SEPTIC SYSTEM(S)
 - REPAIR/ADD TO AN EXISTING SEPTIC SYSTEM
 - REPLACE AN EXISTING SEPTIC SYSTEM

- CHECK AS NEEDED:
- NEW STRUCTURE(S)
 - ADDITION TO AN EXISTING STRUCTURE
 - REPLACE AN EXISTING STRUCTURE

- CHECK ONE:
- CREATE NEW LOT(S)
 - BUILD ON AN EXISTING LOT IN A SUBDIVISION
 - BUILD ON AN EXISTING PARCEL OF RECORD

- IS THE PROPERTY WITHIN 2500' OF ANY RESERVOIR?
- YES
 - NO

- THE TYPE OF STRUCTURE IS:
- RESIDENTIAL WITH UNKNOWN PROPOSED BEDROOMS IN THE COMPLETED STRUCTURE (NOTE **UNKNOWN** IF APPROPRIATE)
 - COMMERCIAL (PROVIDE DETAIL OF NUMBERS AND TYPES OF EMPLOYEES/ CUSTOMERS ON ACCOMPANYING PLAN)
 - INSTITUTIONAL/GOVERNMENT (PROVIDE DETAIL OF NUMBERS AND TYPES OF EMPLOYEES/USERS ON ACCOMPANYING PLAN)

PROPERTY OWNER(S) CONSUELO REGAN

DAYTIME PHONE (301) 854-6031 CELL _____ FAX _____

MAILING ADDRESS 3866 IVORY ROAD GLENELG MD 21737
STREET CITY/TOWN STATE ZIP

APPLICANT DEMARIO DESIGN CONSULTANTS, INC. 66 E. MAIN ST. ST. 200 WE

DAYTIME PHONE (410) 386-0560 CELL _____ FAX (410) 386-0564

MAILING ADDRESS 66 E. MAIN ST. SUITE 200, WESTMINSTER MD 21157
STREET CITY/TOWN STATE ZIP

APPLICANT'S ROLE: DEVELOPER BUILDER BUYER RELATIVE/FRIEND REALTOR CONSULTANT

PROPERTY LOCATION REGAN PROPERTY PRESERVATION PARCEL LOT NO. N/A

PROPERTY ADDRESS 3866 IVORY ROAD GLENELG, MD 21737
STREET TOWN/POST OFFICE

AX MAP PAGE(S) 22 GRID 13 PARCEL(S) 24 PROPOSED LOT SIZE 2AC.±

I, APPLICANT, I UNDERSTAND THE FOLLOWING: THE SYSTEM INSTALLED SUBSEQUENT TO THIS APPLICATION IS ACCEPTABLE ONLY UNTIL PUBLIC SEWERAGE IS AVAILABLE. THIS APPLICATION IS COMPLETE WHEN ALL APPLICABLE FEES AND A DETAILED SITE PLAN HAVE BEEN RECEIVED. I ACCEPT THE RESPONSIBILITY FOR COMPLIANCE WITH ALL M.O.S.H.A. AND "SEWER UTILITY" REQUIREMENTS. APPROVAL IS BASED UPON SATISFACTORY REVIEW OF A PERC CERTIFICATION PLAN. TEST RESULTS WILL BE MAILED TO APPLICANT.

SIGNATURE OF APPLICANT

HOWARD COUNTY HEALTH DEPARTMENT, BUREAU OF ENVIRONMENTAL HEALTH, WELL AND SEPTIC PROGRAM
 7178 COLUMBIA GATEWAY DRIVE COLUMBIA, MARYLAND 21046 (410) 313-2640 FAX (410) 313-2648
 TDD (410) 313-2323 TOLL FREE 1-877-4MD-DHMH

DATE	TEST #	DEPTH	START	BREAK 1" DROP	STOP 2" DROP	TIME OF 2ND INCH	P/F/H

REMARKS _____

SANITARIAN _____ BACKHOE _____ OTHERS _____

TEST HOLES USED IN SDA _____ AVG. PERC TIME _____ SQ. FT/BR _____

TRENCH WIDTH _____ INLET DEPTH _____ MAX. BOT DEPTH _____ EFFECTIVE SW _____



HOWARD COUNTY HEALTH DEPARTMENT

23439

DATE
10/6/05

AS

Received From Demario Design Consultants Inc PHONE # 410 386-0560

66 East Main St, Westminster, MD 21157

For Peric. applic. & plan

CASH

CHECK

NO. 6702

3866 Quary Road

Rogan Property Preservation Par B

one thousand five hundred eighty two ¹⁰/₁₀₀ Dollars


\$ 1586 | 00

Received By [Signature]

PCLES

THE UNIVERSITY OF MICHIGAN LIBRARY

f 32205

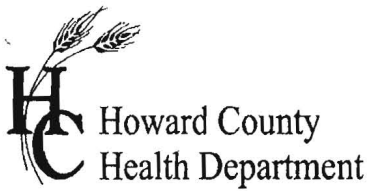

APPLICATION

FOR PERCOLATION TESTING AND SITE EVALUATION

TEST DATE(S) _____ TEST TIME _____

APS 23439

AGENCY REVIEW: _____

DATE 10/6/05

DO NOT WRITE ABOVE THIS LINE

I HEREBY APPLY FOR THE NECESSARY TESTING/EVALUATION PRIOR TO ISSUANCE OF SEWAGE DISPOSAL SYSTEM PERMIT(S) TO:

CHECK AS NEEDED:

- CONSTRUCT NEW SEPTIC SYSTEM(S)
- REPAIR/ADD TO AN EXISTING SEPTIC SYSTEM
- REPLACE AN EXISTING SEPTIC SYSTEM

CHECK AS NEEDED:

- NEW STRUCTURE(S)
- ADDITION TO AN EXISTING STRUCTURE
- REPLACE AN EXISTING STRUCTURE

CHECK ONE:

- CREATE NEW LOT(S)
- BUILD ON AN EXISTING LOT IN A SUBDIVISION
- BUILD ON AN EXISTING PARCEL OF RECORD

IS THE PROPERTY WITHIN 2500' OF ANY RESERVOIR?

- YES
- NO

THE TYPE OF STRUCTURE IS:

- RESIDENTIAL WITH UNKNOWN PROPOSED BEDROOMS IN THE COMPLETED STRUCTURE (NOTE **UNKNOWN** IF APPROPRIATE)
- COMMERCIAL (PROVIDE DETAIL OF NUMBERS AND TYPES OF EMPLOYEES/ CUSTOMERS ON ACCOMPANYING PLAN)
- INSTITUTIONAL/GOVERNMENT (PROVIDE DETAIL OF NUMBERS AND TYPES OF EMPLOYEES/USERS ON ACCOMPANYING PLAN)

PROPERTY OWNER(S) CONSUELO REGAN

DAYTIME PHONE (301) 854-6031 CELL _____ FAX _____

MAILING ADDRESS 3866 IVORY ROAD GLENELG MD 21737
STREET CITY/TOWN STATE ZIP

APPLICANT DEMARIO DESIGN CONSULTANTS, INC. 66 E. MAIN ST. ST. 200 WE

DAYTIME PHONE (410) 386-0560 CELL _____ FAX (410) 386-0564

MAILING ADDRESS 66 E. MAIN ST. SUITE 200, WESTMINSTER MD 21157
STREET CITY/TOWN STATE ZIP

APPLICANT'S ROLE: DEVELOPER BUILDER BUYER RELATIVE/FRIEND REALTOR CONSULTANT


PROPERTY LOCATION
SUBDIVISION/PROPERTY NAME REGAN PROPERTY LOT 2 LOT NO. N/A

PROPERTY ADDRESS 3866 IVORY ROAD GLENELG, MD 21737
STREET TOWN/POST OFFICE


TAX MAP PAGE(S) 22 GRID 13 PARCEL(S) 24 PROPOSED LOT SIZE 1 AC ±

AS APPLICANT, I UNDERSTAND THE FOLLOWING: THE SYSTEM INSTALLED SUBSEQUENT TO THIS APPLICATION IS ACCEPTABLE ONLY UNTIL PUBLIC SEWERAGE IS AVAILABLE. THIS APPLICATION IS COMPLETE WHEN ALL APPLICABLE FEES AND A SUITABLE SITE PLAN HAVE BEEN RECEIVED. I ACCEPT THE RESPONSIBILITY FOR COMPLIANCE WITH ALL M.O.S.H.A. AND "MISS UTILITY" REQUIREMENTS. APPROVAL IS BASED UPON SATISFACTORY REVIEW OF A PERC CERTIFICATION PLAN.

TEST RESULTS WILL BE MAILED TO APPLICANT.


SIGNATURE OF APPLICANT

HOWARD COUNTY HEALTH DEPARTMENT, BUREAU OF ENVIRONMENTAL HEALTH, WELL AND SEPTIC PROGRAM
7178 COLUMBIA GATEWAY DRIVE COLUMBIA, MARYLAND 21046 (410) 313-2640 FAX (410) 313-2648
TDD (410) 313-2323 TOLL FREE 1-877-4MD-DHMH

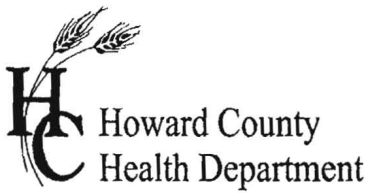

APPLICATION

FOR PERCOLATION TESTING AND SITE EVALUATION

TEST DATE(S) _____ TEST TIME _____

Cap 523459

AGENCY REVIEW: _____

DATE 10/6/05

DO NOT WRITE ABOVE THIS LINE

I HEREBY APPLY FOR THE NECESSARY TESTING/EVALUATION PRIOR TO ISSUANCE OF SEWAGE DISPOSAL SYSTEM PERMIT(S) TO:

CHECK AS NEEDED:

- CONSTRUCT NEW SEPTIC SYSTEM(S)
- REPAIR/ADD TO AN EXISTING SEPTIC SYSTEM
- REPLACE AN EXISTING SEPTIC SYSTEM

CHECK AS NEEDED:

- NEW STRUCTURE(S)
- ADDITION TO AN EXISTING STRUCTURE
- REPLACE AN EXISTING STRUCTURE

CHECK ONE:

- CREATE NEW LOT(S)
- BUILD ON AN EXISTING LOT IN A SUBDIVISION
- BUILD ON AN EXISTING PARCEL OF RECORD

IS THE PROPERTY WITHIN 2500' OF ANY RESERVOIR?

- YES
- NO

THE TYPE OF STRUCTURE IS:

- RESIDENTIAL WITH UNKNOWN PROPOSED BEDROOMS IN THE COMPLETED STRUCTURE (NOTE UNKNOWN IF APPROPRIATE)
- COMMERCIAL (PROVIDE DETAIL OF NUMBERS AND TYPES OF EMPLOYEES/ CUSTOMERS ON ACCOMPANYING PLAN)
- INSTITUTIONAL/GOVERNMENT (PROVIDE DETAIL OF NUMBERS AND TYPES OF EMPLOYEES/USERS ON ACCOMPANYING PLAN)

PROPERTY OWNER(S) CONSUELO REGAN Amie

DAYTIME PHONE (301) 854-6031 CELL _____ FAX 410-313-8178

MAILING ADDRESS 3866 IVORY ROAD GLENELG MD 21737
STREET CITY/TOWN STATE ZIP

APPLICANT DEMARIO DESIGN CONSULTANTS, INC. 66 E. MAIN ST. ST. 200 WE

DAYTIME PHONE (410) 386-0560 CELL _____ FAX (410) 386-0564

MAILING ADDRESS 66 E. MAIN ST. SUITE 200, WESTMINSTER MD 21157
STREET CITY/TOWN STATE ZIP

APPLICANT'S ROLE: DEVELOPER BUILDER BUYER RELATIVE/FRIEND REALTOR CONSULTANT

PROPERTY LOCATION
SUBDIVISION/PROPERTY NAME REGAN PROPERTY LOT 1 LOT NO. N/A

PROPERTY ADDRESS 3866 IVORY ROAD GLENELG, MD 21737
STREET TOWN/POST OFFICE

TAX MAP PAGE(S) 22 GRID 13 PARCEL(S) 24 PROPOSED LOT SIZE 1 AC ±

AS APPLICANT, I UNDERSTAND THE FOLLOWING: THE SYSTEM INSTALLED SUBSEQUENT TO THIS APPLICATION IS ACCEPTABLE ONLY UNTIL PUBLIC SEWERAGE IS AVAILABLE. THIS APPLICATION IS COMPLETE WHEN ALL APPLICABLE FEES AND A SUITABLE SITE PLAN HAVE BEEN RECEIVED. I ACCEPT THE RESPONSIBILITY FOR COMPLIANCE WITH ALL M.O.S.H.A. AND "MISS UTILITY" REQUIREMENTS. APPROVAL IS BASED UPON SATISFACTORY REVIEW OF A PERC CERTIFICATION PLAN.

TEST RESULTS WILL BE MAILED TO APPLICANT.

[Signature]
SIGNATURE OF APPLICANT



HOWARD COUNTY HEALTH DEPARTMENT, BUREAU OF ENVIRONMENTAL HEALTH, WELL AND SEPTIC PROGRAM
7178 COLUMBIA GATEWAY DRIVE COLUMBIA, MARYLAND 21046 (410) 313-2640 FAX (410) 313-2648
TDD (410) 313-2323 TOLL FREE 1-877-4MD-DHMH

DRAWING LEGEND

- 682 --- EXISTING MINOR CONTOUR (2' INTERVAL)
- 680 --- EXISTING MAJOR CONTOUR (10' INTERVAL)
- ADJACENT PROPERTY LINE
- ==== N 06°45'45"W 120.0' EXISTING PROPERTY BOUNDARY
- ==== EX. ROAD / EDGE OF PAVING
- [H] EX. BUILDING
- [H] PROPOSED BUILDING
- [+/-] PROPOSED/PASSED/FAILED SAND MOUND PERC TEST
- [Hatched Box] EX. SEPTIC SYSTEM/AREA
- [Circle] PROPOSED SAND MOUND
- [W] EX. WELL/100' RADIUS

SAND MOUND CHART - FINAL DIMENSIONS

LOT NO.	INITIAL SYSTEM	1ST REPLACEMENT AREA	2ND REPLACEMENT AREA
1 (4BR)	34'x90'	34'x90'	34'x90'
2 (4BR)	34'x90'	34'x90'	34'x90'
PRESERVATION PARCEL	39'x102'	34'x90'	34'x90'

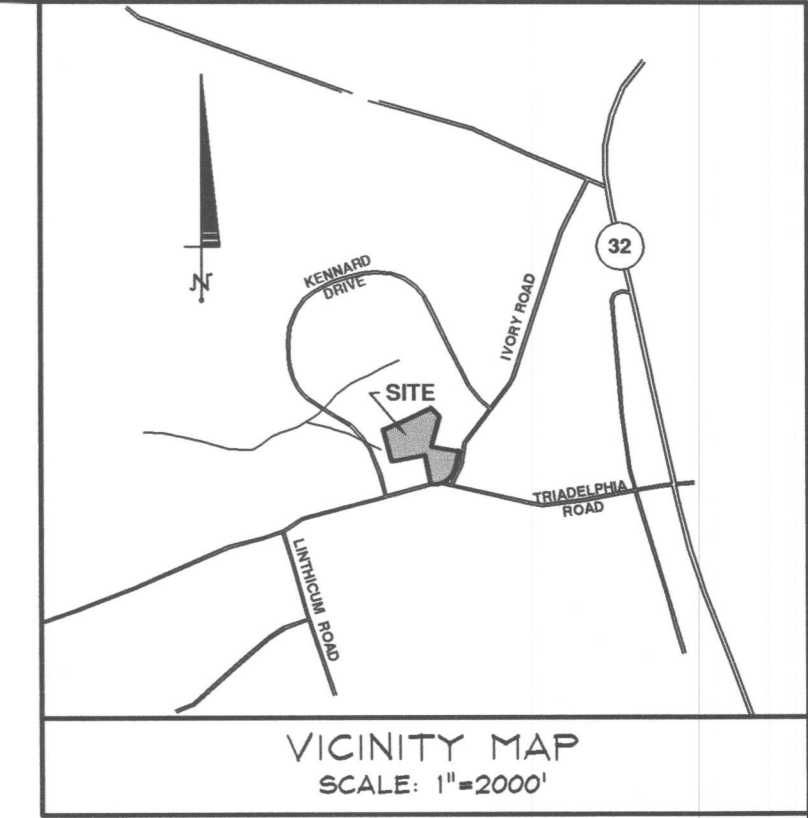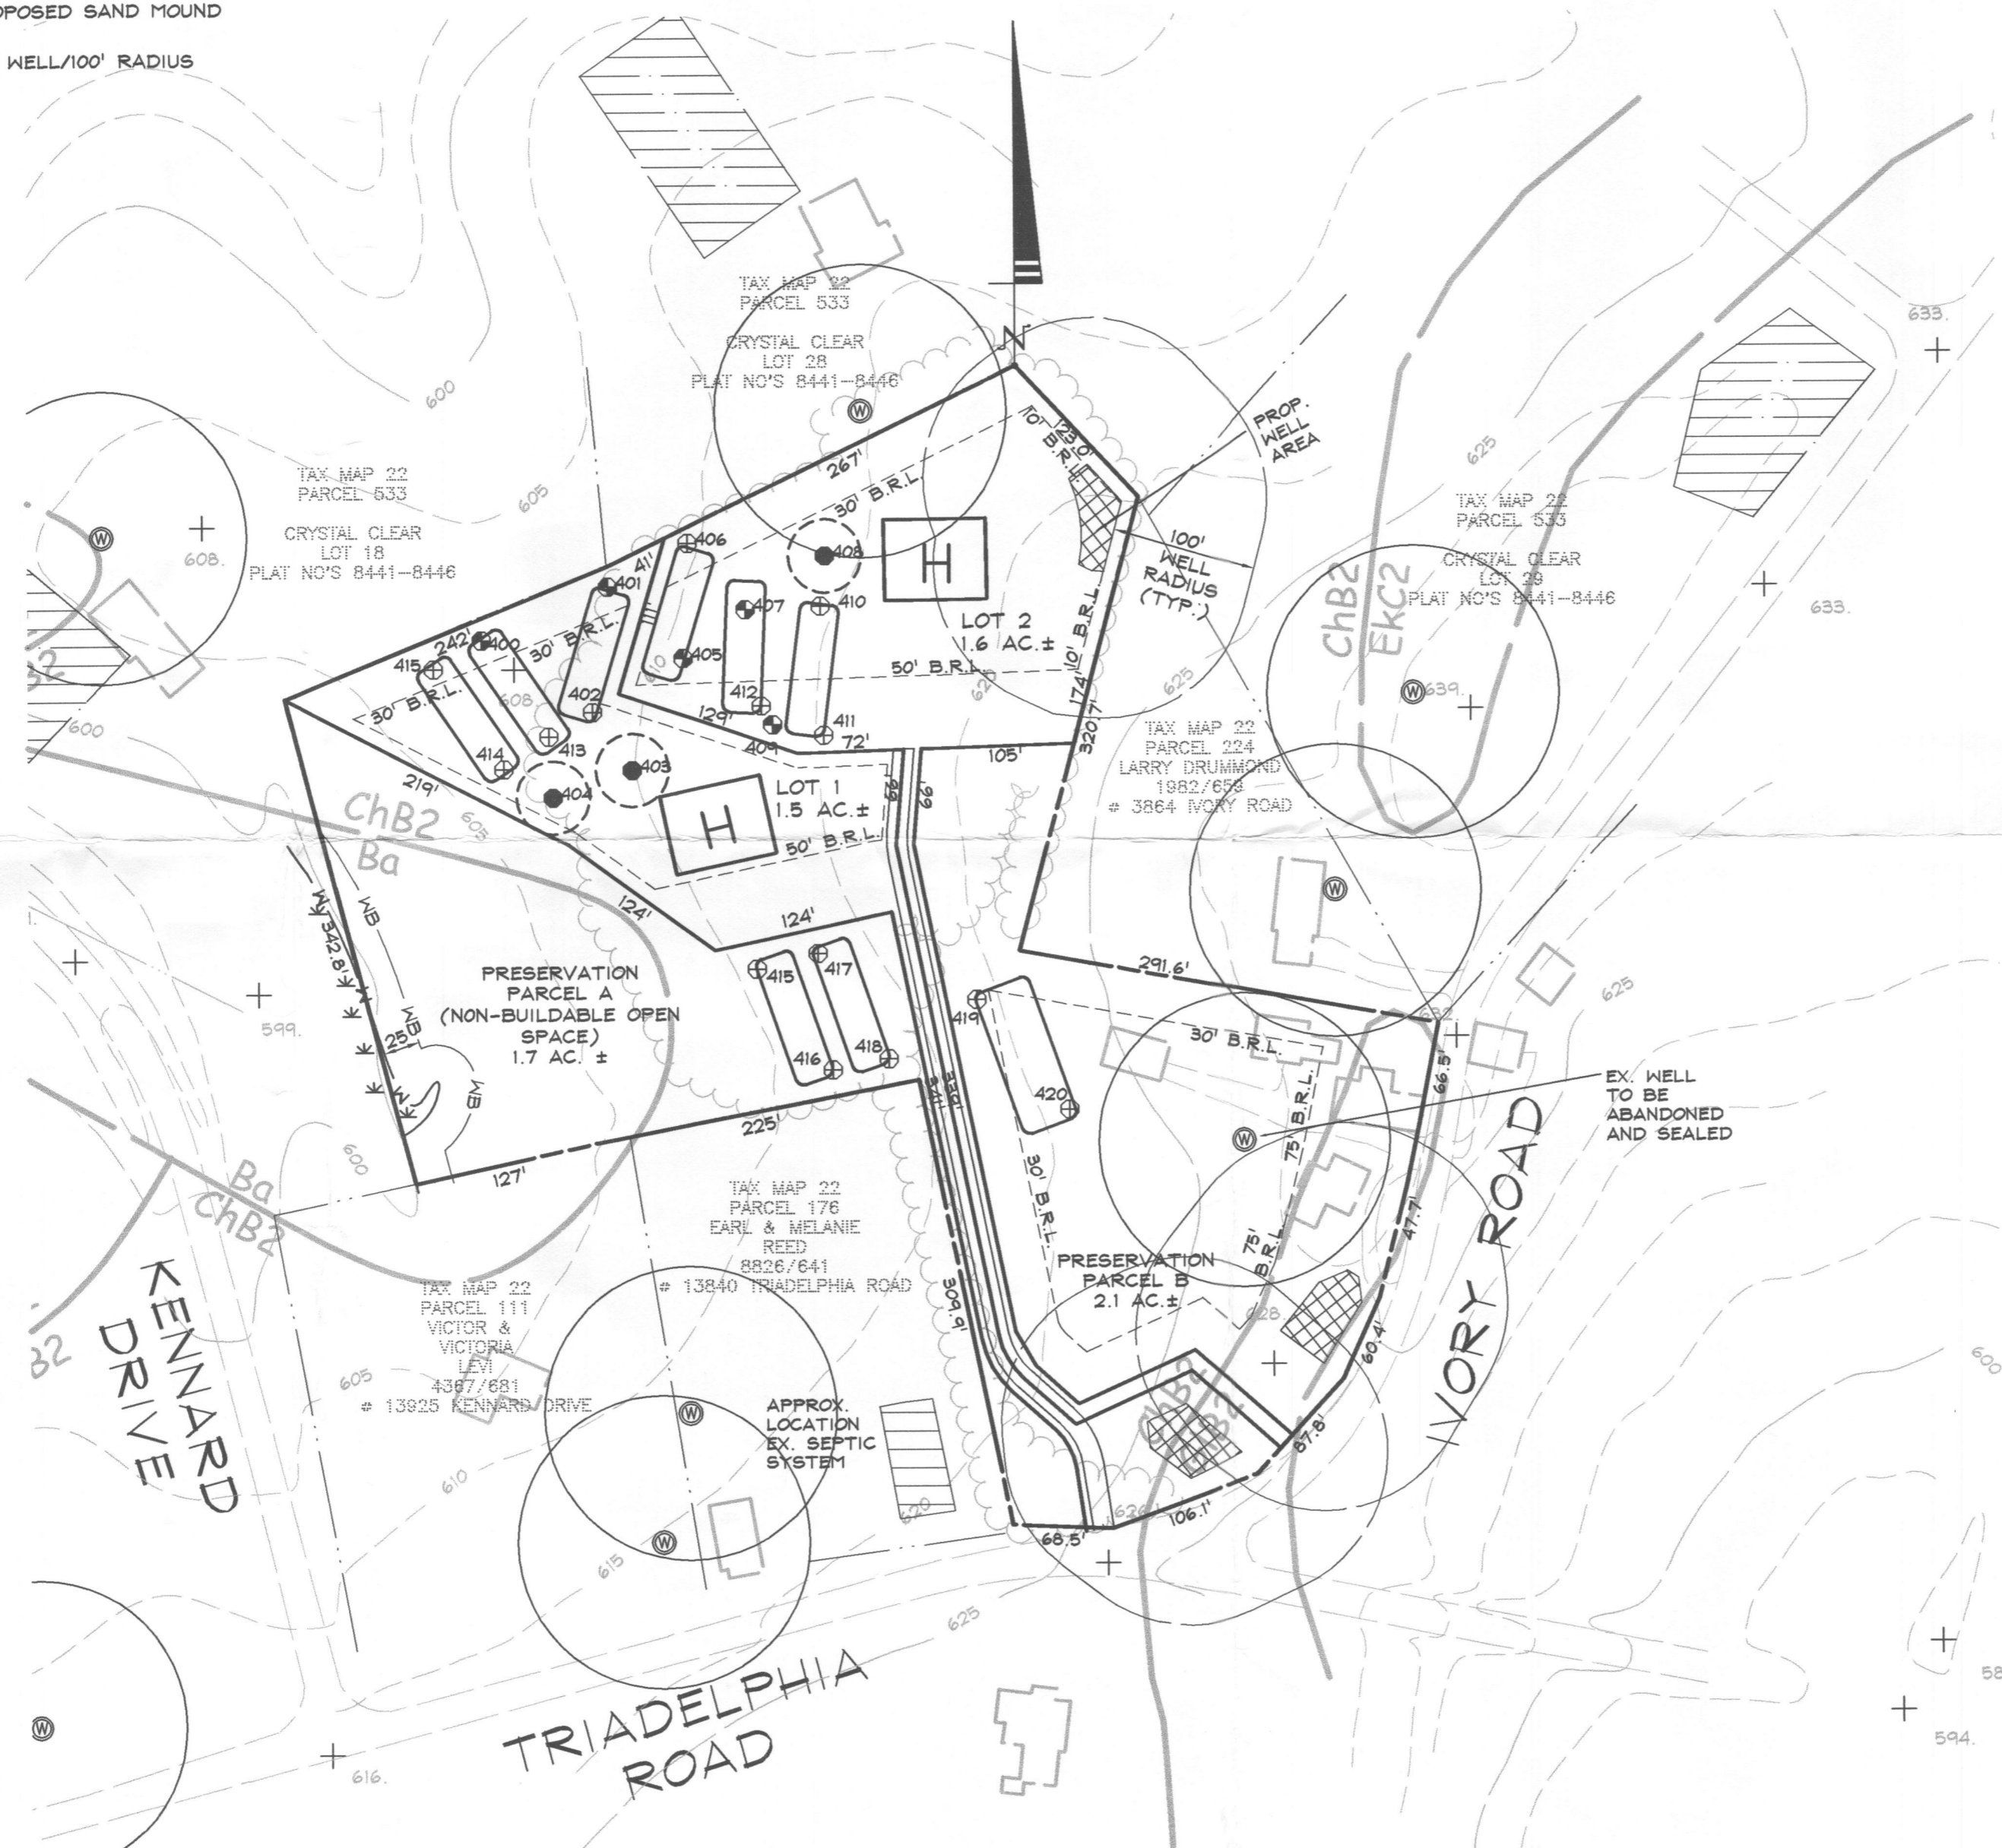

- NOTES:**
- EXISTING TOPOGRAPHY SHOWN HEREON IS TAKEN FROM HOWARD COUNTY AERIAL PHOTOGRAMMETRY.
 - EXISTING SEPTIC AREAS AND WELLS SHOWN ARE FROM AVAILABLE PLANS OF RECORD AND FIELD OBSERVATION.
 - THERE ARE NO SLOPES > 25% ON SITE.

DeMario Design Consultants, Inc.
 The Old Firehouse
 66 East Main Street, Suite 200
 Westminster, MD 21157
 Phone: (410) 386-0560
 Fax: (410) 386-0564
 eMail: ddc@demariodesign.us

OWNER: CONSUELO REGAN
 3866 IVORY ROAD
 GLENELG, MD 21737

DEVELOPER:

SITE ADDRESS:
 3866 IVORY ROAD
 GLENELG, MD 21737

REGAN PROPERTY
PERC TEST PLAN

3RD ELECTION DISTRICT HOWARD COUNTY, MD

REVISIONS				
NO.	DESCRIPTION OF CHANGES	DRN.	REV.	DATE
4	REVISE LOT & SEPTIC CONFIGURATION FOR SAND MOUND TESTING	JAI	JAI	01/30/06
3	REVISE WELL & LOT CONFIGURATION LOT 1 & PRES. PARCEL	JAI	JAI	12/23/05
2	REVISE WELLS & SEPTICS & LOT CONFIGURATION	JAI	JAI	12/09/05
1	ADD WELL LOCATIONS - REVISE LOT CONFIGURATION	JAI	JAI	11/07/05

CO. FILE # N/A	DES. BY: JAI
TAX ACC. # 03-293785	DRN. BY: JAI
TAX MAP: 22	CHK. BY: JLM
BLOCK / GRID: 13	DATE: 11/07/05
PARCEL # 24	DDC JOB# 05028.1
ZONE / USE: RR-DEO	SHEET NUMBER:
DWG. SCALE: 1"=100'	1 of 1



Existing Zoning : RRDEO
 Soils Map Number: 13
 Number of building sites: 2
 Total Area of Site = 7.1± AC.

DRAWING LEGEND

- 682 --- EXISTING MINOR CONTOUR (2' INTERVAL)
- 680 --- EXISTING MAJOR CONTOUR (10' INTERVAL)
- ADJACENT PROPERTY LINE
- ==== N 06°45'45"N 120.0' EXISTING PROPERTY BOUNDARY
- ==== EX. ROAD / EDGE OF PAVING
- ▭ EX. BUILDING
- ▭ PROPOSED BUILDING
- ⊕ ⊖ ⊗ PROPOSED/PASSED/FAILED SAND MOUND PERC TEST
- ▨ EX. SEPTIC SYSTEM/AREA
- PROPOSED SAND MOUND
- ⊙ EX. WELL/100' RADIUS
- PASSED TILE FIELD PERC TEST

SAND MOUND CHART - FINAL DIMENSIONS

LOT NO.	INITIAL SYSTEM	1ST REPLACEMENT AREA	2ND REPLACEMENT AREA
1 (4BR)	34'x90'	34'x90'	34'x90'
2 (4BR)	34'x90'	34'x90'	34'x90'
PRESERVATION PARCEL	39'x102'	34'x90'	34'x90'

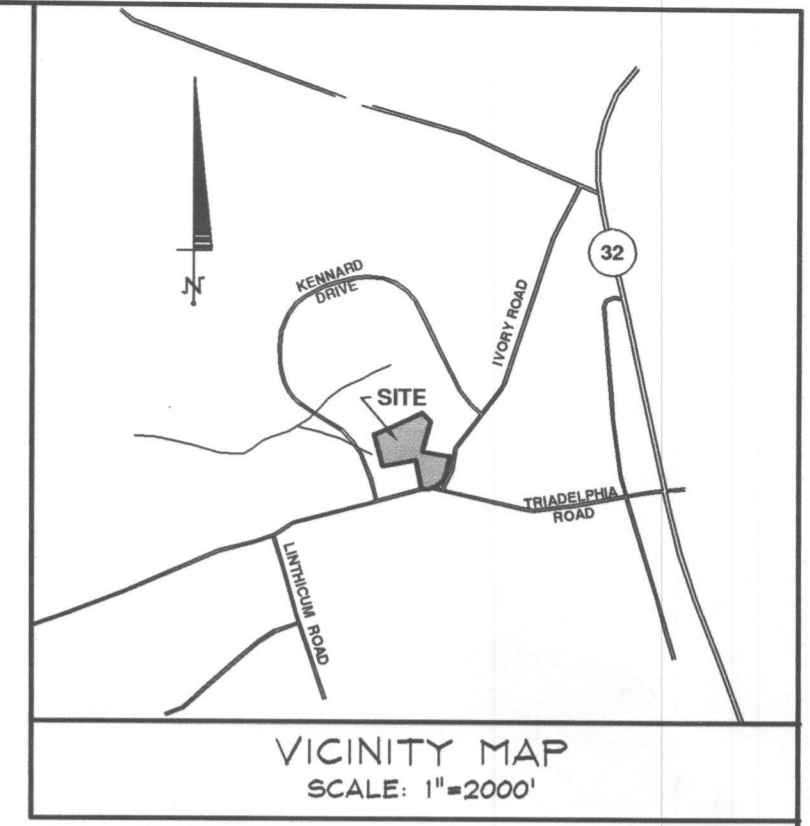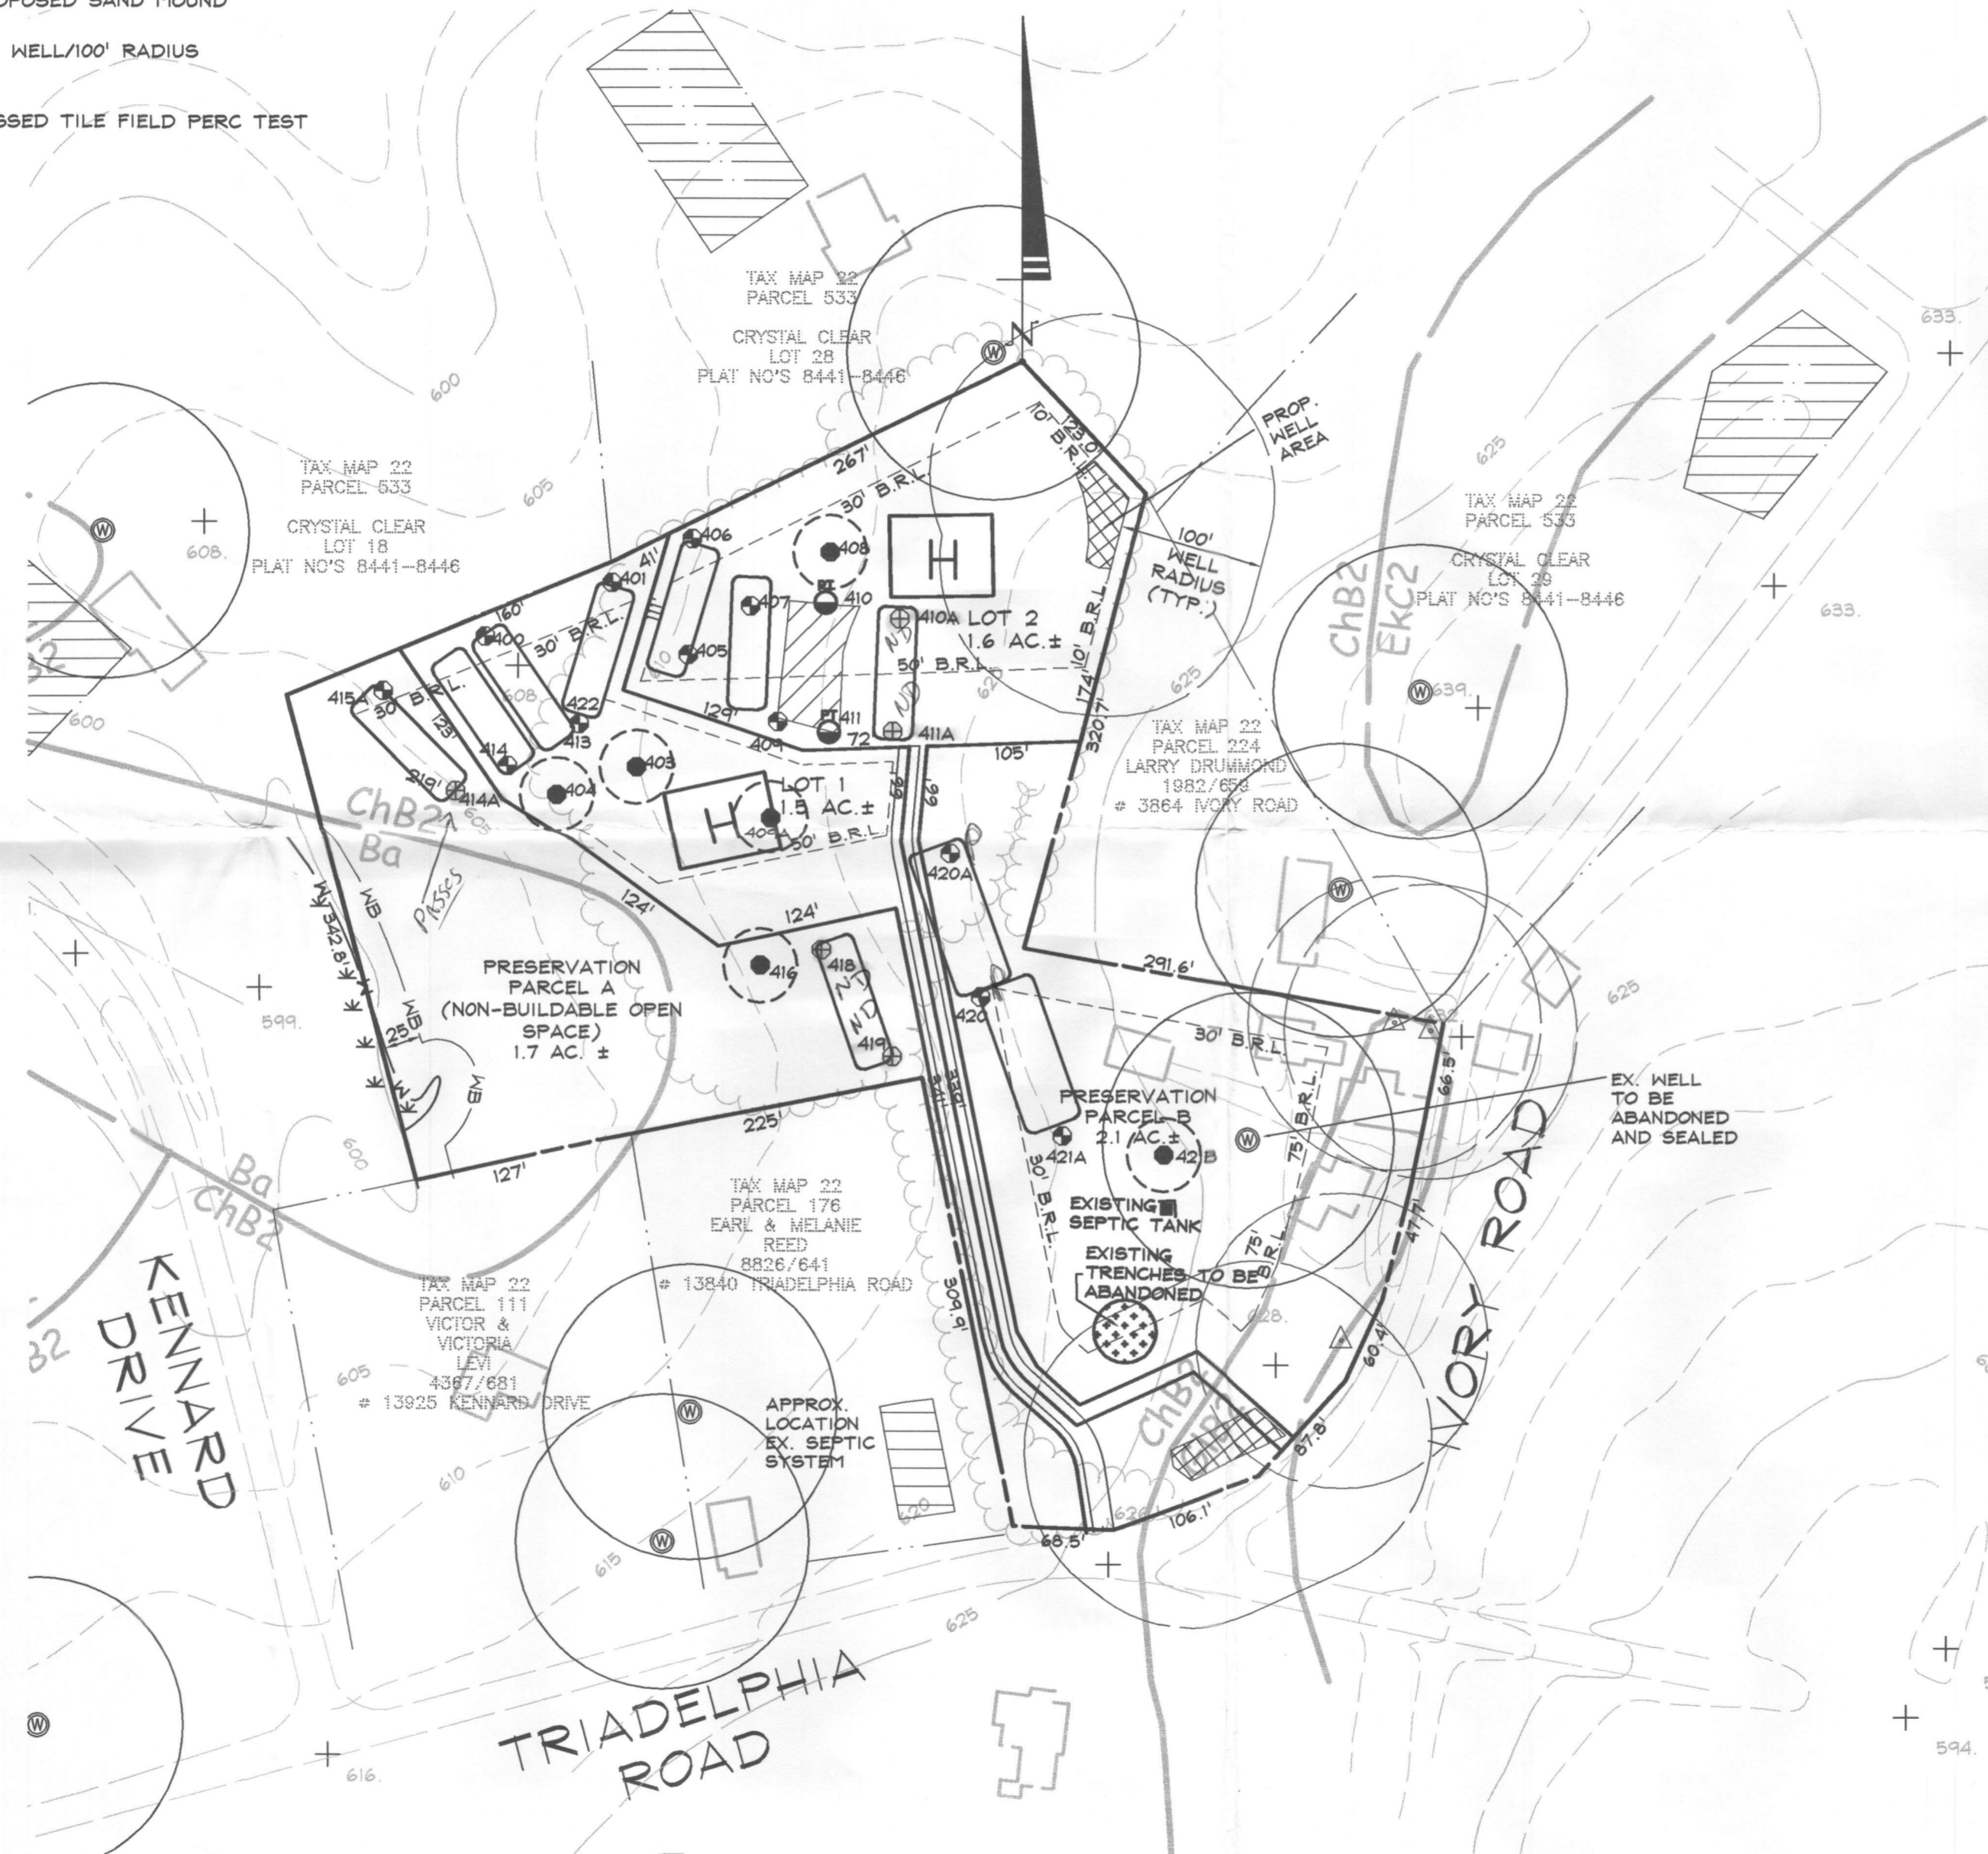

- NOTES:**
- EXISTING TOPOGRAPHY SHOWN HEREON IS TAKEN FROM HOWARD COUNTY AERIAL PHOTOGRAMMETRY.
 - EXISTING SEPTIC AREAS AND WELLS SHOWN ARE FROM AVAILABLE PLANS OF RECORD AND FIELD OBSERVATION.
 - THERE ARE NO SLOPES > 25% ON SITE.

DeMario Design Consultants, Inc.
 The Old Firehouse
 66 East Main Street, Suite 200
 Westminster, MD 21157
 Phone: (410) 386-0560
 Fax: (410) 386-0564
 eMail: ddc@demariodesign.us

OWNER: CONSUELO REGAN
 3866 IVORY ROAD
 GLENELG, MD 21737

DEVELOPER:

SITE ADDRESS:
 3866 IVORY ROAD
 GLENELG, MD 21737

REGAN PROPERTY
PERC TEST PLAN

3RD ELECTION DISTRICT HOWARD COUNTY, MD

REVISIONS				
NO.	DESCRIPTION OF CHANGES	DRN.	REV.	DATE
4	REVISE LOT & SEPTIC CONFIGURATION FOR SAND MOUND TESTING	JAI	JAI	01/30/05
3	REVISE WELL & LOT CONFIGURATION LOT 1 & PRES. PARCEL	JAI	JAI	12/23/05
2	REVISE WELLS & SEPTICS & LOT CONFIGURATION	JAI	JAI	12/09/05
1	ADD WELL LOCATIONS - REVISE LOT CONFIGURATION	JAI	JAI	11/07/05

CO. FILE # N/A	DES. BY: JAI
TAX ACC. # 03-293785	DRN. BY: JAI
TAX MAP: 22	CHK. BY: JLM
BLOCK / GRID: 13	DATE: 11/07/05
PARCEL # 24	DDC JOB# 05028.1
ZONE / USE: RR-DEO	SHEET NUMBER:
DWG. SCALE: 1"=100'	1 of 1

REVISIONS CONTINUED

NO.	DESCRIPTION OF CHANGES	DRN.	REV.	DATE
5	REVISE LOT & SEPTIC CONFIGURATION FOR SAND MOUND TESTING	JAI	JAI	03/28/06

Existing Zoning : RRDEO
 Soils Map Number: 13
 Number of building sites: 2
 Total Area of Site = 7.1± AC.