

PUB. SEWER STATUS VERIFIED BY _____

ISSUE DATE: 8-6-10

P 533309

APPROVAL DATE: 8/13/2010

A REPAIR

PERMIT

Septic Repair

Tax ID#: 04-308891

**ON-SITE SEWAGE DISPOSAL SYSTEM
HOWARD COUNTY HEALTH DEPARTMENT
BUREAU OF ENVIRONMENTAL HEALTH**

Feaga and Son Excavating IS PERMITTED TO INSTALL ALTER

ADDRESS: 1625 Henryton Road Marriottsville MD 21104 PHONE NUMBER: 410-442-5623

SUBDIVISION: Robe Johnsen Sub LOT NUMBER: 4

ADDRESS: 3245 Jennings Chapel Road PROPERTY OWNER: Charles and Diane Lange

SEPTIC TANK CAPACITY (GALLONS): 1200 *3' Wide*

PUMP CHAMBER CAPACITY (GALLONS): _____ *Inlet 5'*

NUMBER OF BEDROOMS: 6 *Bottom 9'*

SQUARE FEET OF HOUSE: ~3600

LINEAR FEET OF TRENCH REQUIRED: 240

TRENCHES:	Set distribution box at middle trench 1' lower than septic tank out. Install 3 x 80' trenches per layout, pipe invert at -5'. Install observation pipes at trench ends. <i>Trenches 3' wide. RB.</i>
LOCATION:	
PURPOSE:	Call for layout inspection. Gravel must be washed and free of fines and clay. Must be approved by Howard County Health Dept Environmental Sanitarian. 2 dry wells must be pumped, collapsed and filled for final approval.

PLANS APPROVED: _____ DATE: _____

- NOTE: PERMIT VOID AFTER 2 YEARS
- NOTE: CONTRACTOR RESPONSIBLE FOR SCHEDULING A PRE-CONSTRUCTION INSPECTION FOR ALL INSTALLATIONS
- NOTE: WATERTIGHT SEPTIC TANKS REQUIRED
- NOTE: ALL PARTS OF SEPTIC SYSTEM SHALL BE 100 FEET FROM ANY WATER WELL
- NOTE: MANHOLE RISERS REQUIRED ON ALL SEPTIC TANKS AND PUMP CHAMBERS

NEITHER THE HOWARD COUNTY COUNCIL OR THE HEALTH DEPARTMENT IS RESPONSIBLE FOR THE SUCCESSFUL OPERATION OF ANY SYSTEM PERMITTEE RESPONSIBLE FOR OBTAINING FINAL APPROVAL ON THIS PERMIT CALL 410-313-1771 FOR INSPECTION OF SEPTIC SYSTEM.

NOT TO SCALE


Well - Mostly Buried

TRENCH/DRAINFIELD DATA

WIDTH	INLET	BOTTOM
3'	5'	9'
NUMBER OF TRENCHES		3'
TOTAL LENGTH		242'
ABSORPTION AREA		726 + Sidewall
DISTRIBUTION BOX LEVEL		Levelers
DISTRIBUTION BOX BAFFLE		Yes
DISTRIBUTION BOX PORT		Yes

SEPTIC TANK DATA

SEPTIC TANK 1 LEVEL	Yes
MANUFACTURER	Babylon?
CAPACITY	? GAL
SEAM LOC	Midseam
TANK LID DEPTH	1.5'
BAFFLES	Rear
BAFFLE FILTER	No
MANHOLE LOC	Rear
6" PORT LOC	None
WATERTIGHT TEST	No
SLOTTED	No
PUMP/SEPTIC TANK LEVEL	N/A
MANUFACTURER	
CAPACITY	GAL
SEAM LOC	
TANK LID DEPTH	
BAFFLES	
BAFFLE FILTER	
MANHOLE LOC	
6" PORT LOC	
WATERTIGHT TEST	
SLOTTED	

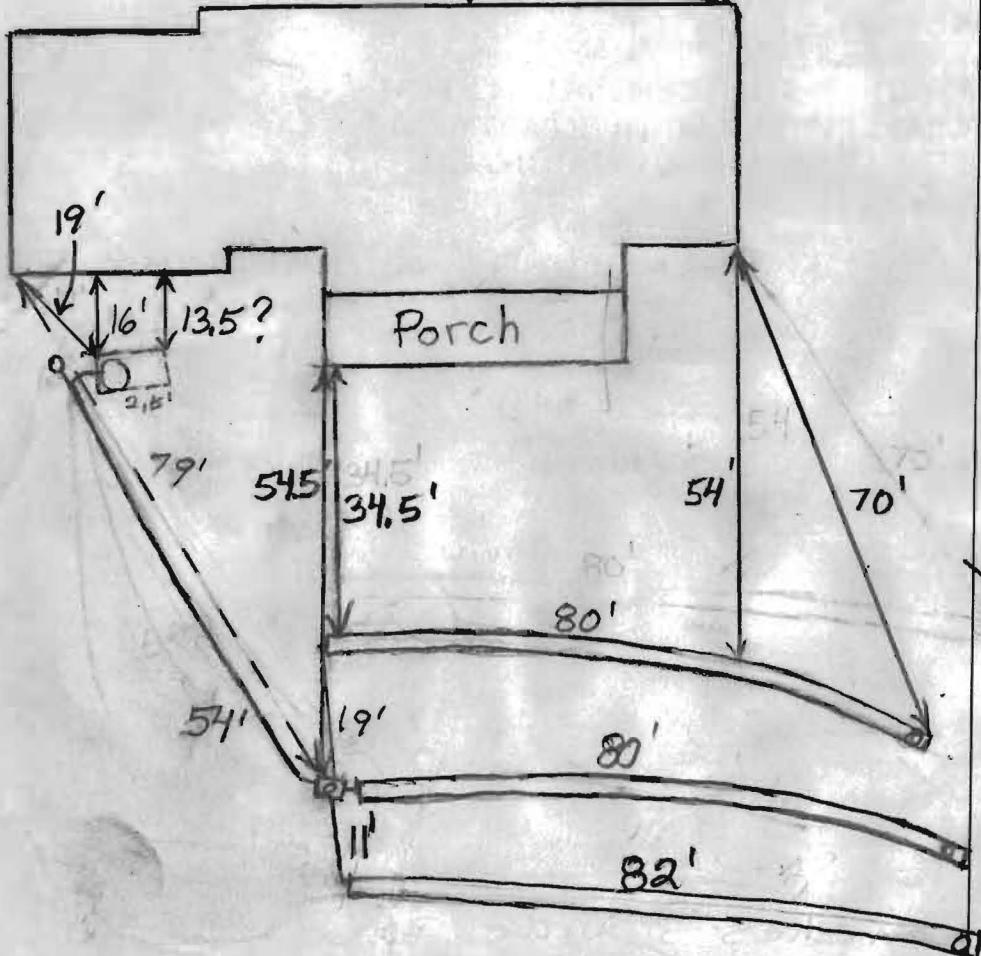

Jennings Chapel Road

PRE-CONSTRUCTION
 8/11/2010 Trench locations marked in field. To install similar to Robert's plan but closer to the house (BB)

INSTALLATION: 8/12/2010 Top trench done (BB) 8/13/2010 System finished. O.K. to backfill (BB)

FINAL INSPECTOR B. Baker DATE OF APPROVAL 8/13/2010

NOT TO SCALE

