

John Haynes 301-461-3954

LAYOUT 9/15/03 INSP 4 _____
INSP 2 _____ INSP 5 _____
INSP 3 _____ INSP 6 _____

ISSUE DATE: 9/11/03
APPROVAL DATE: 9/15/03

PERMIT INDEXED

P 519568
A 515279

ON-SITE SEWAGE DISPOSAL SYSTEM HOWARD COUNTY HEALTH DEPARTMENT BUREAU OF ENVIRONMENTAL HEALTH

04-332717

Covey Construction Co, Inc. IS PERMITTED TO INSTALL ALTER
ADDRESS: P. O. Box 254, Woodstock MD PHONE NUMBER: 410-750-0398
SUBDIVISION: Asbury Property LOT NUMBER: 1
ADDRESS: 2722 Jennings Chapel Road PROPERTY OWNER: Carole Asbury

SEPTIC TANK CAPACITY (GALLONS): 1500 OUTLET BAFFLE FILTER REQUIRED
PUMP CHAMBER CAPACITY (GALLONS): N/A COMPARTMENTED TANK REQUIRED
NUMBER OF BEDROOMS: 4
SQUARE FEET PER BEDROOM: 180
LINEAR FEET OF TRENCH REQUIRED: 200 HOUSE SERVED BY PUBLIC WATER

TRENCHES:	Trench to be 3.0 feet wide. Inlet 3.0 feet below original grade. Bottom maximum depth 5.0 feet below original grade. Effective area begins at 4.0 feet below original grade. 2.0 feet of stone below distribution pipe.
LOCATION:	Place the distribution box as shown on the approved building permit plan. <u>50' trench, 70' & 80' ±</u>
NOTES:	Basement will not sewer by gravity.

PLANS APPROVED: Steven R. Krieg OK SRK 9/11/03 DATE: 10/16/02

NOTES: PERMIT VOID AFTER 2 YEARS
CONTRACTOR IS RESPONSIBLE FOR SCHEDULING A PRE-CONSTRUCTION INSPECTION FOR ALL INSTALLATIONS
WATERTIGHT SEPTIC TANKS REQUIRED
ALL PARTS OF SEPTIC SYSTEM SHALL BE 100 FEET FROM ANY WATER WELL UNLESS SPECIFICALLY AUTHORIZED
MANHOLE RISERS REQUIRED ON ALL SEPTIC TANKS AND PUMP CHAMBERS UNLESS SPECIFICALLY AUTHORIZED
CONTRACTOR RESPONSIBLE FOR COMPLIANCE WITH APPLICABLE REGULATIONS, GUIDELINES AND THE TERMS OF THIS PERMIT


NEITHER THE HOWARD COUNTY COUNCIL NOR THE HEALTH DEPARTMENT IS RESPONSIBLE FOR THE SUCCESSFUL OPERATION OF ANY SYSTEM PERMITTED RESPONSIBLE FOR OBTAINING FINAL APPROVAL ON THIS PERMIT
BUILDING PERMIT SIGNED AND RETURNED
ALL 410-313-2640 FOR INSPECTION OF SEPTIC SYSTEM

1103 B00143749-UG PROPANE TANK

AS15279

NOT TO SCALE

HO-94-3508

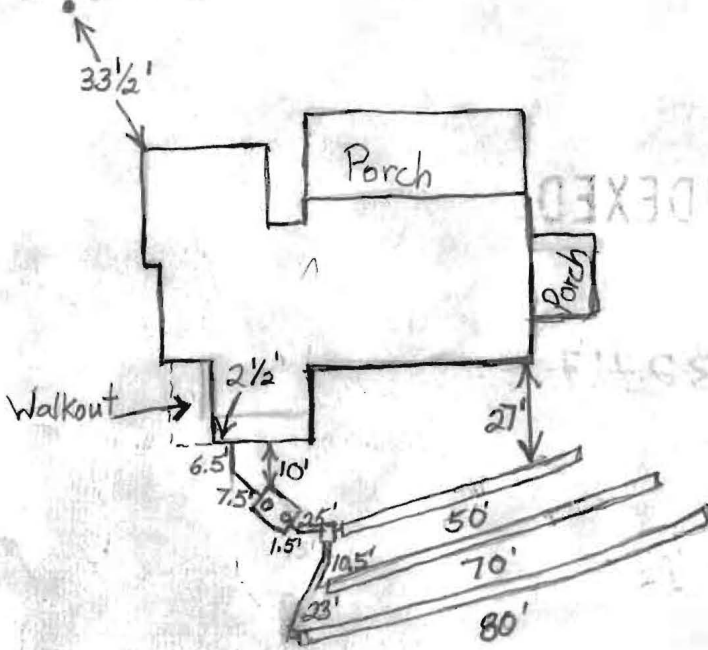

TRENCH/DRAINFIELD DATA		
WIDTH	INLET	BOTTOM
3	3'	5'
NUMBER OF TRENCHES		3
TOTAL LENGTH		200
ABSORPTION AREA		600 sq ft.
DISTRIBUTION BOX LEVEL		✓
DISTRIBUTION BOX BAFFLE		✓
DISTRIBUTION BOX PORT		No

SEPTIC TANK DATA	
SEPTIC TANK 1 LEVEL	✓
CAPACITY	1500 GAL
SEAM LOC	Top
TANK LID DEPTH	~1'
BAFFLES	✓
BAFFLE FILTER	No
MANHOLE LOC	None
6" PORT LOC	Front + Back
WATERTIGHT TEST	No
SEPTIC TANK 2 LEVEL	
CAPACITY	_____ GAL
SEAM LOC	_____
TANK LID DEPTH	_____
BAFFLES	_____
BAFFLE FILTER	_____
MANHOLE LOC	_____
6" PORT LOC	_____
WATERTIGHT TEST	_____

PRE-CONSTRUCTION 9/15/03 Install as per plan. (BB)

INSTALLATION 9/15/03 Everything looks good. O.K. to cover. (BB)

BUILDING PERMIT SIGNED AND RETURNED

FINAL INSPECTOR B. Baker DATE OF APPROVAL 9/15/03

GENERAL NOTES:

- 1) THIS LOCATION DRAWING IS PREPARED FOR THE BENEFIT OF THE CLIENT SIGNING THE HOUSE LOCATION SURVEY APPROVAL FORM INsofar AS IT IS REQUIRED BY A LENDER OR TITLE INSURANCE COMPANY OR ITS AGENTS IN CONNECTION WITH THE COMTEMPLATED TRANSFER, FINANCING OR REFINANCING OF THE PROPERTY SHOWN HEREON. UNLESS INDICATED AS BEING A BOUNDARY SURVEY, THIS LOCATION DRAWING IS NOT INTENDED FOR USE IN THE ESTABLISHMENT OF PROPERTY LINES AND IS NOT TO BE RELIED UPON FOR THE ESTABLISHMENT OR LOCATIONS OF FENCES, GARAGES, BUILDINGS OR OTHER EXISTING OR FUTURE IMPROVEMENTS. AS A RESULT, THIS LOCATION DRAWING DOES NOT PROVIDE FOR ACCURATE IDENTIFICATION OF PROPERTY LINES, BUT SUCH IDENTIFICATION MAY NOT BE REQUIRED FOR THE TRANSFER OF TITLE OR SECURING FINANCING FOR RE-FINANCING.
- 2) SUBJECT PROPERTY IS SHOWN IN ZONE C ON THE NATIONAL FLOOD INSURANCE PROGRAM FLOOD INSURANCE RATE MAP OF HOWARD COUNTY, MARYLAND, COMMUNITY PANEL No. 2400440013 B EFFECTIVE DEC. 4, 1986.
- 3) THE OFFSETS FROM BUILDING LINE TO PROPERTY LINE AS SHOWN ON THE PLAT HEREON ARE TO AN ACCURACY OF PLUS OR MINUS 1' (+)
- 4) NO TITLE REPORT FURNISHED. SUBJECT TO ALL EASEMENTS, RIGHTS OF WAY AND CONDITIONS OF RECORD.



PROPERTY OF
GEORGE M. BOYER
LIBER 4764, FOLIO 314

PROPERTY OF
JOHN S. BRITTON
LIBER 4188, FOLIO 507


LOT 8
"WARFIELD PROPERTY"
PLAT #5171

PROPERTY OF
RONALD S. AND CAROLE
S. ASBURY
LIBER 1386, FOLIO 355


HOWARD COUNTY
AGRICULTURAL
LAND PRESERVATION
EASEMENT
HO-90-12E

PROPERTY OF
ARTHUR P. SAVAGE
PRISCILLA P. SAVAGE
LIBER 422, FOLIO 409

PARCEL 43
PROPERTY OF
MATTHEW A. SAVAGE
LIBER 4001, FOLIO 449

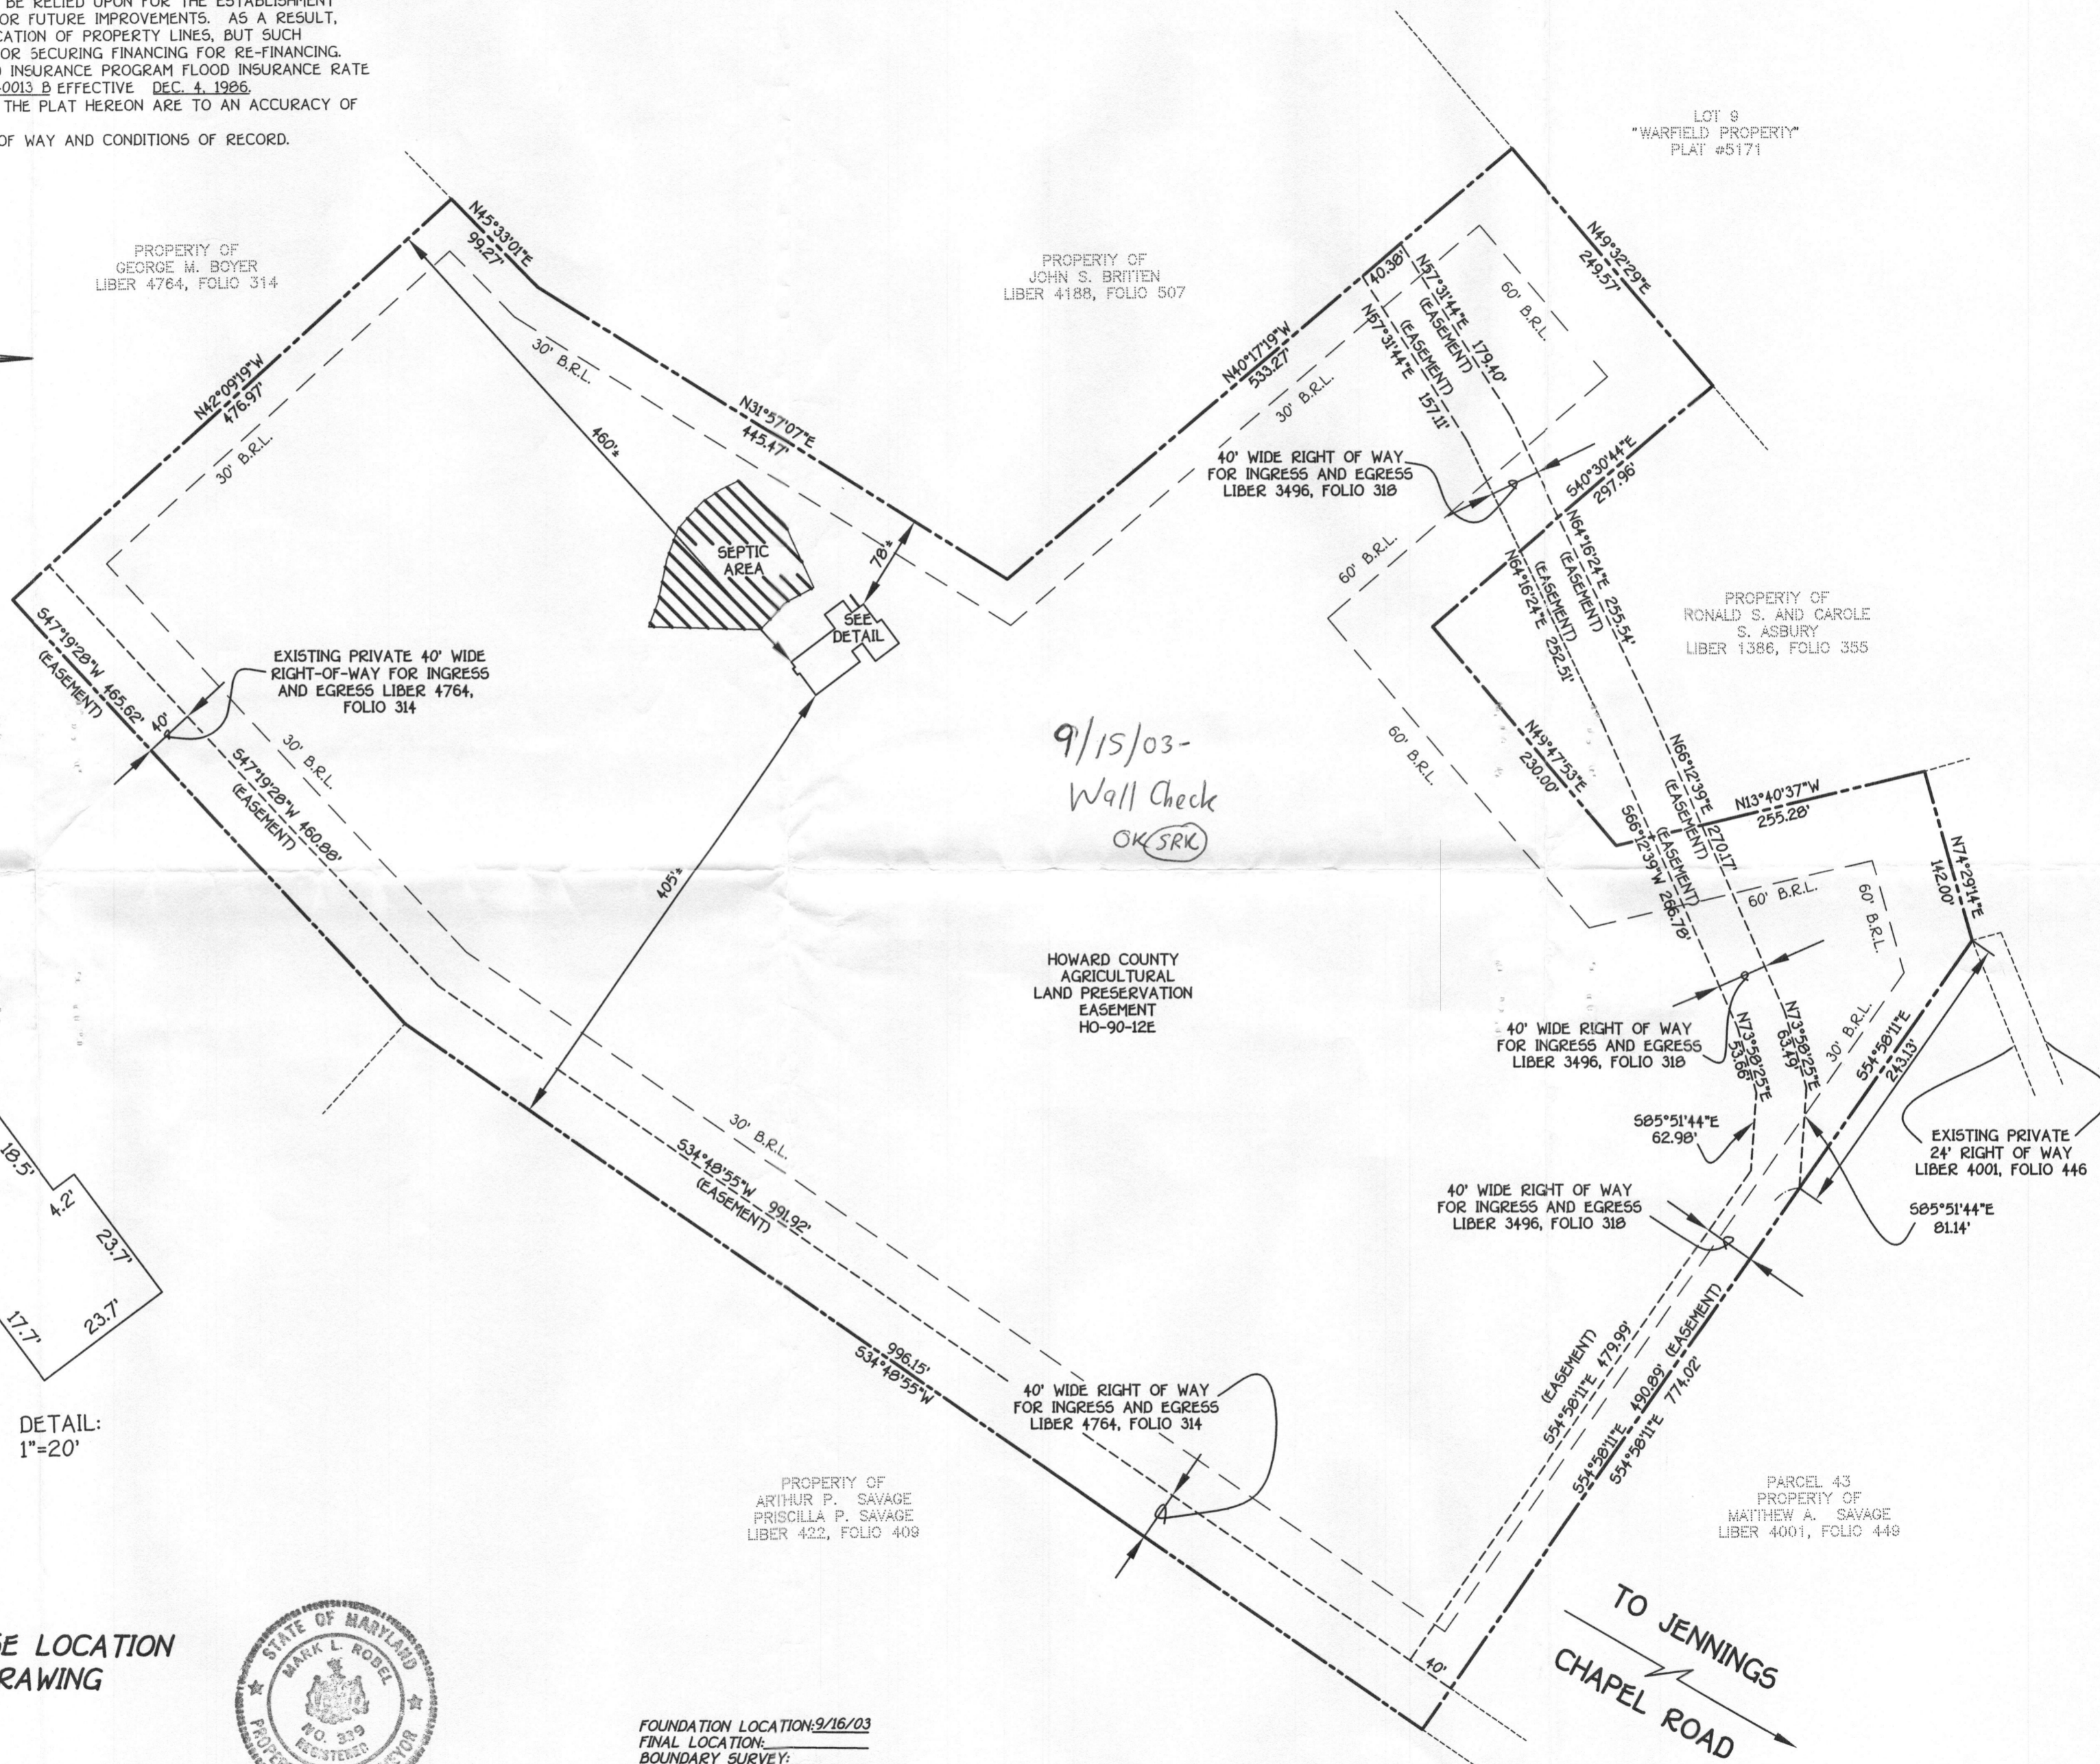

9/15/03-
Wall Check
OK (SRK)

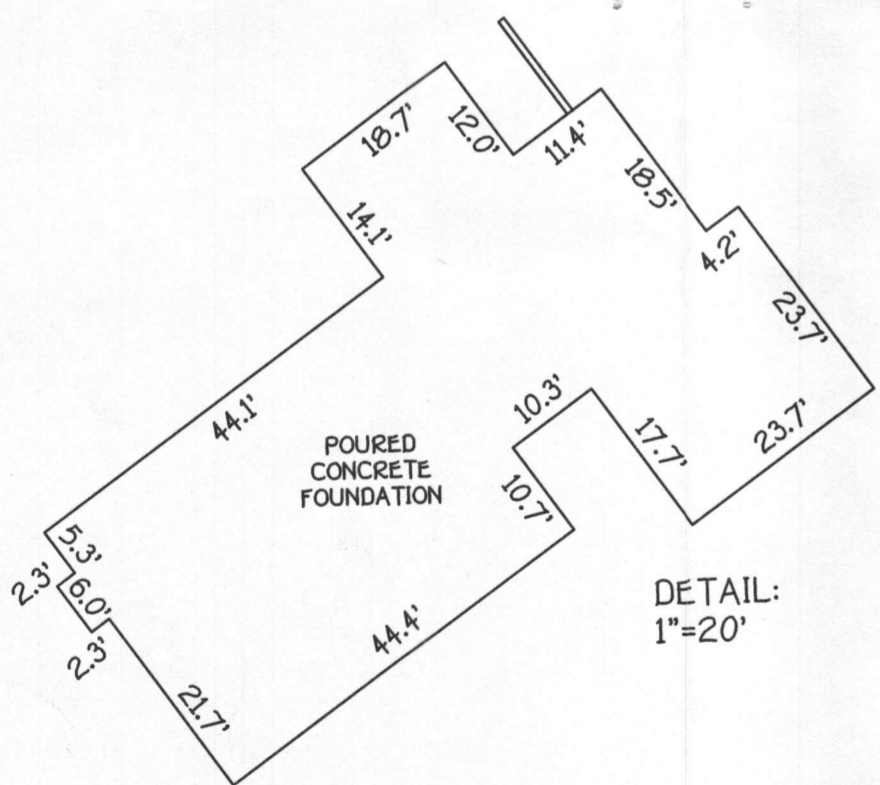

HOUSE LOCATION
DRAWING



Mark L. Rodel 9/23/03
PROFESSIONAL LAND SURVEYOR DATE
REG. *

ASBURY PROPERTY
FOURTH ELECTION DISTRICT
HOWARD COUNTY, MARYLAND
DEED REF. LIBER-4221 FOLIO-0254

FOUNDATION LOCATION: 9/16/03
FINAL LOCATION:
BOUNDARY SURVEY:

SCALE: 1"=100'
DATE: 9/19/03
DRAWN BY: K.L.E.
CHECKED BY: S.R.P.
PROJECT No.: 30735

B.R.L. = BUILDING RESTRICTION LINE
TOP OF FOUNDATION ELEV. 564.2'