

HOWARD COUNTY PERMIT APPLICATION

PERMIT NUMBER

B06006512

Building Address <u>3325 Jennings Chapel Road</u> <u>Woodbine, Maryland 21797-7511</u> Suite/Apt. #: _____ SDP/WP/Petition #: _____ Census Tract _____ Subdivision _____ Section _____ Area _____ Lot _____ Tax Map <u>13</u> Parcel <u>135</u> Grid <u>23</u> Zoning <u>RC-DEO</u> Map Coordinates _____ Lot size <u>7.99+ AC.</u>	Property Owner's Name <u>Regie Dvorak</u> Address <u>3325 Jennings Chapel Road</u> City <u>Woodbine</u> State <u>MD</u> Zip Code <u>21797</u> Home Phone <u>cell 240-508-2502</u> Work Phone _____ Applicant's Name & Mailing Address, (if other than stated hereon): _____ Phone _____ Fax _____
Existing Use _____ Proposed Use <u>Garage - detached</u> Estimated Construction Cost \$ <u>30,000</u> Description of Work <u>New two-story garage at existing adjacent residence (upper story/loft-attached).</u>	Contractor Company <u>HOMEOWNER TO COMPLETE WORK.</u> Contact Person _____ Address _____ City _____ State _____ Zip Code _____ License No. _____ Phone _____ Fax _____
Occupant or Tenant <u>Owner</u> Contact Name _____ Address _____ City _____ State _____ Zip Code _____ Phone _____ Fax _____	Engineer or Architect Company <u>Ernest F. Sharff</u> Contact Person <u>Same</u> Address <u>4187 Wine Road</u> City <u>Westminster</u> State <u>MD</u> Zip Code <u>21158</u> Phone <u>410-876-6523</u> Fax <u>N/A</u>

BUILDING DESCRIPTION - COMMERCIAL

BUILDING DESCRIPTION - RESIDENTIAL

Building Characteristics	Utilities	Building Characteristics	Utilities
Height: _____	Water Supply: <input type="checkbox"/> Public <input type="checkbox"/> Private	SF Dwelling <input type="checkbox"/> SF Townhouse <input type="checkbox"/> Depth _____ Width _____	Water Supply: <input type="checkbox"/> Public <input checked="" type="checkbox"/> Private
No. of stories: _____	Sewage Disposal: <input type="checkbox"/> Public <input type="checkbox"/> Private	1st floor: _____ 2nd floor: _____ Basement: _____	Sewage Disposal: <input type="checkbox"/> Public <input checked="" type="checkbox"/> Private
Gross area, sq. ft. per floor: _____	Electric Yes <input type="checkbox"/> No <input type="checkbox"/> Gas Yes <input type="checkbox"/> No <input type="checkbox"/>	Finished Basement <input type="checkbox"/> Unfinished Basement <input type="checkbox"/> Crawli space <input type="checkbox"/> Slab on Grade <input checked="" type="checkbox"/>	Electric Yes <input type="checkbox"/> No <input type="checkbox"/> Gas Yes <input type="checkbox"/> No <input type="checkbox"/>
Use group: _____	Heating System: <input type="checkbox"/> Electric <input type="checkbox"/> Oil <input type="checkbox"/> <input type="checkbox"/> Natural Gas <input type="checkbox"/> <input type="checkbox"/> Propane Gas <input type="checkbox"/>	No. of Bedrooms _____ Height: _____ Multi-family dwellings: No. of efficiency units: _____ No. of 1 BR units: _____ No. of 2 BR units: _____ No. of 3 BR units: _____	Heating System: <input type="checkbox"/> Electric <input type="checkbox"/> Oil <input type="checkbox"/> <input type="checkbox"/> Natural Gas <input type="checkbox"/> <input type="checkbox"/> Propane Gas <input type="checkbox"/>
Construction type: <input type="checkbox"/> Reinforced Concrete <input type="checkbox"/> Structural Steel <input type="checkbox"/> Masonry <input type="checkbox"/> Wood Frame <input type="checkbox"/> State Certified Modular	Sprinkler system: <u>N/A</u> <input type="checkbox"/> <input type="checkbox"/> Full <input type="checkbox"/> Partial <input type="checkbox"/> Other Suppression <input type="checkbox"/> # of Heads _____	Other Structure: <u>Detached garage</u> Dimensions: <u>40' x 29'</u> Footings: <u>conc.</u> Roof Height: <u>asph. shingle</u> <input type="checkbox"/> State Certified Modular <input type="checkbox"/> Manufactured Home	Sprinkler system: <u>N/A</u> <input type="checkbox"/> <input type="checkbox"/> NFPA #13D <input type="checkbox"/> NFPA #13R <input type="checkbox"/> Other: _____

THE UNDERSIGNED HEREBY CERTIFIES AND AGREES AS FOLLOWS: (1) THAT HE/SHE IS AUTHORIZED TO MAKE THIS APPLICATION; (2) THAT THE INFORMATION IS CORRECT; (3) THAT HE/SHE WILL COMPLY WITH ALL REGULATIONS OF HOWARD COUNTY WHICH ARE APPLICABLE THERETO; (4) THAT HE/SHE WILL PERFORM NO WORK ON THE ABOVE REFERENCED PROPERTY NOT SPECIFICALLY DESCRIBED IN THIS APPLICATION; (5) THAT HE/SHE GRANTS COUNTY OFFICIALS THE RIGHT TO ENTER ONTO THIS PROPERTY FOR THE PURPOSE OF INSPECTING THE WORK PERMITTED AND POSTING NOTICES.

Applicant's Signature *Ernest F. Sharff* Print Name ERNEST F. SHARFF II
 Title/Company _____ Date OCT. 24, '06

Checks payable to: **DIRECTOR OF FINANCE OF HOWARD COUNTY**
 ** PLEASE WRITE NEATLY AND LEGIBLY. **
 - FOR OFFICE USE ONLY -

AGENCY	DATE	SIGNATURE APPROVAL	DPZ SETBACK INFORMATION	PROPERTY ID#
✓ Land Development, DPZ			Front: _____	Filing fee \$ _____
✓ State Highways			Rear: _____	Permit fee \$ _____
✓ Building Official			Side: _____	Excise tax \$ _____
✓ Dev. Engineering, DPZ			Side St.: _____	Add'l per. fee \$ _____
Health	<u>11/13/06</u>	<u><i>Sharff</i></u>	All minimum setbacks met?	TOTAL FEES \$ _____
Fire Protection			YES <input type="checkbox"/> NO <input type="checkbox"/>	Sub-total paid \$ _____
Is Sediment Control approval required prior to issuance?			Is Entrance Permit required?	Balance due \$ _____
YES <input type="checkbox"/> NO <input type="checkbox"/>			YES <input type="checkbox"/> NO <input type="checkbox"/>	Check # <u>4743</u>
CONTINGENCY CONSTRUCTION START: <input type="checkbox"/>			Historic District?	Validation # _____
ONE STOP SHOP: <input type="checkbox"/>			YES <input type="checkbox"/> NO <input type="checkbox"/>	
Distribution of Copies: _____	White: Building Official	Green: LDD, DPZ	Lot Coverage for NewTown Zone _____	Accepted by <u><i>JD</i></u>
T:\forms\PERMIT.FRM			SDP/Red-line approval date _____	
			Yellow: DED, DPZ	
			Pink: Health	
			Gold: SHA	




N 75° 55' 00" E 318.18'

60' BRL

S 19° 57' 54" E 315.00'

30' BRL

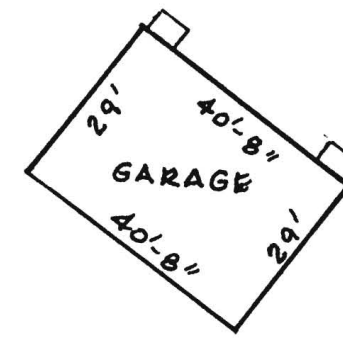

DETAIL PLAN
1" = 30'

PARCEL 135
7.99 AC. ±

N 02° 05' 14" E 874.17'

30' BRL

504° 20' 00" E
161.08'

30' BRL

*Garage location at
Bobco 6512
11/13/06
OR*

BARN

SHEDS

SEPTIC AREA

SEPTIC C.O.

242' ±

EXIST. WELL

EXIST. HOUSE

EXIST. POOL

PROPOSED GARAGE
(DETACHED)
(SEE DET. PLAN ABOVE)

PLOT PLAN
1" = 100'

S 26° 47' 00" W
526.47'

75' BRL

EXIST. DRIVEWAY

APPROX. 1,000' TO
JENNINGS CHAPEL ROAD

N 73° 41' 00" E
234.00'

S 73° 41' 00" W 468.56'

10-24-06

NEW GARAGE (DETACHED)
3325 JENNINGS CHAPEL RD.
WOODBINE, MD 21796