

3/5/02
0:00

APPLICATION

PERCOLATION TESTING

A _____

P 516530

HOWARD COUNTY HEALTH DEPARTMENT
BUREAU OF ENVIRONMENTAL HEALTH
3525-H ELLICOTT MILLS DRIVE/ELLICOTT CITY, MARYLAND 21043
TELEPHONE: 313-2640

*PERC to
replace entire
system to
support addition
OK MR 2/22/02*

DISTRICT _____

DATE 2/22/02

TO: THE COUNTY HEALTH OFFICER
ELLICOTT CITY, MARYLAND

I HEREBY APPLY FOR THE NECESSARY TEST PRIOR TO APPLICATION FOR PERMIT TO CONSTRUCT (OR RECONSTRUCT) A SEWAGE DISPOSAL SYSTEM.

PROPERTY OWNER Steven & Maria Kropp

ADDRESS 318 Violet Ct. Mt. Airy MD PHONE 301-748-0616

AGENT OR PROSPECTIVE BUYER _____

ADDRESS _____ PHONE _____

PROPERTY LOCATION:

SUBDIVISION 2972 Jennings Chapel Rd Woodbine LOT NO. _____

ROAD AND DESCRIPTION _____

TAX MAP 13 PARCEL # 296

SIZE OF LOT 96 TYPE BLDG. existing sfd w addition
(SINGLE FAMILY DWELLING OR COMMERCIAL)

THE SYSTEM INSTALLED UNDER THIS APPLICATION IS ACCEPTABLE ONLY UNTIL PUBLIC FACILITIES BECOME AVAILABLE. I FULLY UNDERSTAND THE FEE CONNECTED WITH THE FILING OF THIS PERC TEST APPLICATION IS NON-REFUNDABLE UNDER ANY CIRCUMSTANCES. I ALSO AGREE TO COMPLY WITH ALL M.O.S.H.A. REQUIREMENTS IN TESTING THIS LOT.

Maria Kropp
(SIGNATURE OF APPLICANT)

APPROVED BY _____ FOR _____ DATE _____

DISAPPROVED BY _____ FOR _____ DATE _____

HOLD PENDING FURTHER TESTS _____

REASONS FOR REJECTION OR HOLDING _____

PERCOLATION TEST PLAT/PRELIMINARY PLAT - TITLE OR I.D. # _____ DATE _____

SITE DEVELOPMENT PLAN/FINAL PLAT - TITLE OR I.D. # _____ DATE _____

THIS IS NOT A PERMIT

Jennings Chapel Road

COUNTY # _____

SOIL PROFILE

0' **①**

Red Br
Cl Loam 18"


Red Or
Br Si Loam 3.5'

Light Red
Tan Sa
Loam 11.5'

5-10%
Rock

SOIL PROFILE

0'

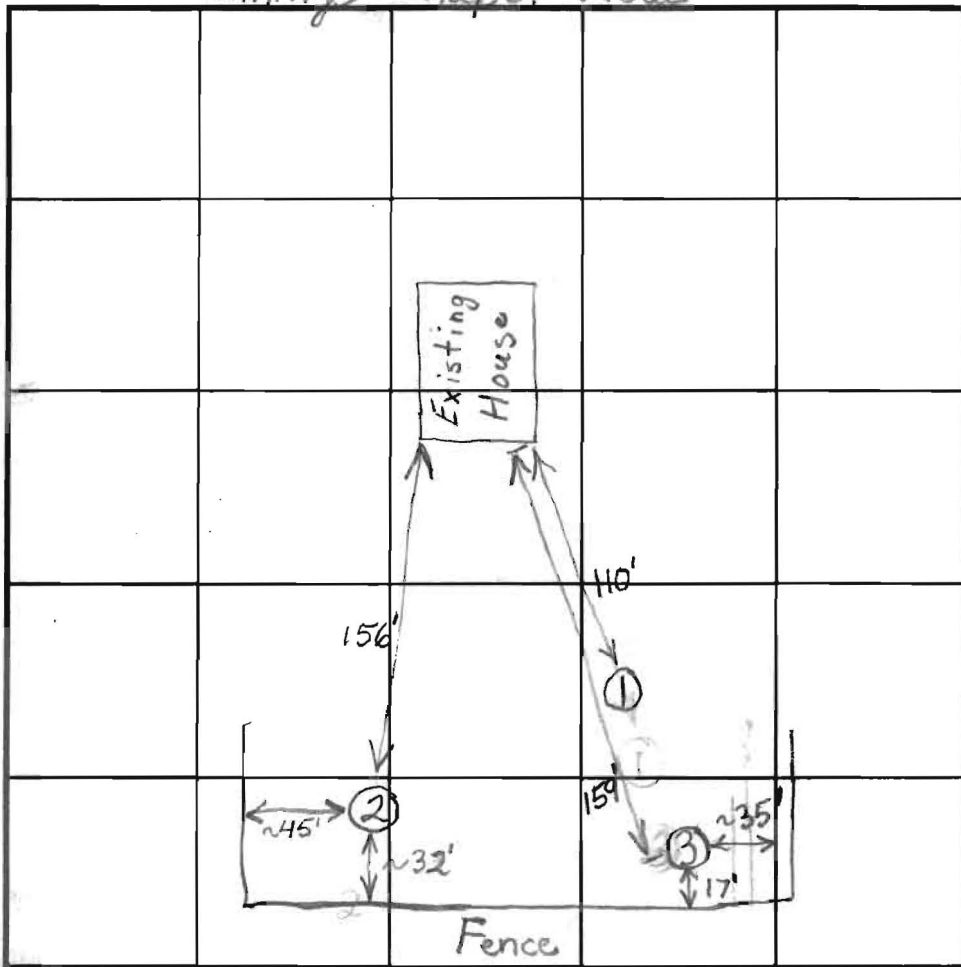

INDICATE NORTH - NAME ADJOINING ROADWAY AS BASE LINE.

②

Red Br
Cl Loam 3'

Tan Si
Loam 4.5'-5.0'

Tan Sa
Loam 8'

2x3' pocket
of ~50%
rock 10'

~20-25%
Rock Overall 11.5'

DATE	TEST NO.	DEPTH	PRE-WET		TEST - 1" DROP		TIME
			START	STOP	START	STOP	
3/4/02	1	4.5'/11.5'	10:36:30	10:40:30	10:40:30	10:45:30	5
	2	4.5'/11.5'	10:57	11:00	11:00	11:07	7
		3.5'	11:20	11:25:30	11:25:30	11:36	10 1/2
	3	3.5'/11.5'	11:43	11:48	11:48	11:58	10

③

Red Br
Cl Loam 3'

Light Red
si Loam 6'-6.5'

Light
Or Red
Sa Loam 11.5'

5-10%
Rock

REMARKS _____

TYPE OF SOIL _____

TESTED BY _____ ALSO PRESENT _____

TRENCH DESIGN DATA: AVERAGE PERCOLATION TIME _____ TRENCH WIDTH _____

INLET DEPTH _____ MAXIMUM BOTTOM DEPTH _____ SQ. FT./BEDROOM _____

