

B 1 3494

SEQUENCE NO. (MDE USE ONLY)

STATE OF MARYLAND APPLICATION FOR PERMIT TO DRILL WELL please type

STATE PERMIT NUMBER 40-95-2007 fill in this form completely

OWNER INFORMATION Date Received (APA) 9/17/2010 Last Name Kerec Owner Terry First Name 2972 Jennings Chapel Rd Woodbine Md 21797

LOCATION OF WELL Howard 8 COUNTY 21 23 SUBDIVISION 42 SECTION 44 46 LOT 48 50 Woodbine 52 NEAREST TOWN 71 MILES FROM TOWN (enter 0 if in town) 6 M I 73 76 77 78

DRILLER INFORMATION Driller's Name Joseph L Mayne MS D024 License No. 81 Firm Name Joseph L Mayne Well Drilling Address 5512 Ridge Rd Mt. Airy Md 21771 Signature Joseph L Mayne Date 9-17-2010

2972 Jennings Chapel Rd 11 NEAR WHAT ROAD 30 ON WHICH SIDE OF ROAD (CIRCLE APPROPRIATE BOX) NORTH 175 SOUTH 34 37 DISTANCE FROM ROAD FT ENTER FT OR MI 38 39 TAX MAP: 13 BLK: 21 PARCEL: 296

WELL INFORMATION APPROX. PUMPING RATE (GAL. PER MIN.) 4 8 12 AVERAGE DAILY QUANTITY NEEDED (GAL. PER DAY) 500 14 20

USE FOR WATER (CIRCLE APPROPRIATE BOX) D DOMESTIC POTABLE SUPPLY & RESIDENTIAL IRRIGATION F FARMING (LIVESTOCK WATERING & AGRICULTURAL IRRIGATION) I INDUSTRIAL, COMMERCIAL, DEWATERING P PUBLIC WATER SUPPLY WELL T TEST, OBSERVATION, MONITORING G GEO-THERMAL

NOT TO BE FILLED IN BY DRILLER HEALTH DEPARTMENT APPROVAL Howard (13) P5165303 COUNTY NAME COUNTY NO. STATE SIGNATURE INSERT S DATE ISSUED 9/17/2010 Brian Baker 9/17/2011 CO SIGNATURE EXP. DATE NORTH GRID 530000 EAST GRID 772 000

APPROXIMATE DEPTH OF WELL 400 24 28 FEET


APPROXIMATE DIAMETER OF WELL 6 NEAREST INCH

METHOD OF DRILLING (circle one) BORED (or Augered) JETTED Jetted & DRIVEN AIR-ROTARY AIR-PERCussion ROTARY (Hydraulic Rotary) CABLE REVERSE-ROTARY DRIVE-POINT other

REPLACEMENT OR DEEPEMED WELLS (CIRCLE APPROPRIATE BOX) N THIS WELL WILL NOT REPLACE AN EXISTING WELL Y THIS WELL WILL REPLACE A WELL THAT WILL BE ABANDONED AND SEALED S THIS WELL WILL REPLACE A WELL THAT WILL BE USED AS A STANDBY-CONTACT LOCAL APPROVING AUTHORITY FOR POLICY ON STANDBY WELLS D THIS WELL WILL DEEPEM AN EXISTING WELL PERMIT NUMBER OF WELL TO BE REPLACED OR DEEPEMED (IF AVAILABLE) 41 52

Not to be filled in by driller (MDE OR COUNTY USE ONLY) APPROP. PERMIT NUMBER G PERMIT No. 40-95-2007

SHOW MAJOR FEATURES OF BOX & LOCATE WELL WITH AN X SOURCES OF DRILLING WATER 1. well 2. 3. WRITE THE BOX NUMBER FROM THE MAP HERE E 7702 N 530

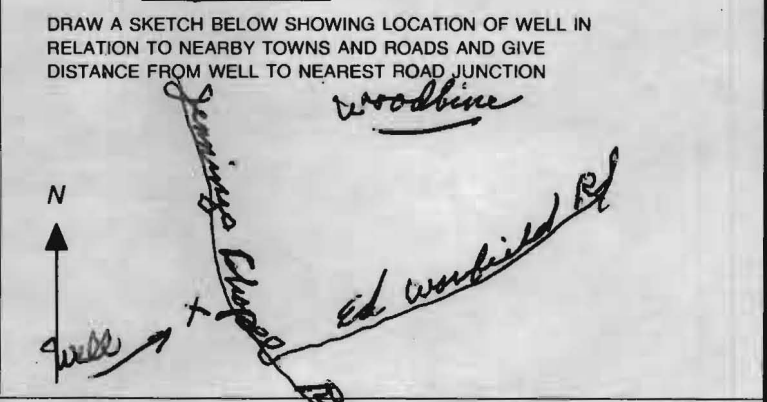

SPECIAL CONDITIONS NOTE - APPROVING AUTHORITIES SHOULD USE SEPARATE SHEET IF NEEDED

B 1 3494

SEQUENCE NO. (MDE USE ONLY)

STATE OF MARYLAND APPLICATION FOR PERMIT TO DRILL WELL

please type

STATE PERMIT NUMBER

HO-95-2007

fill in this form completely

Date Received (APA)

OWNER INFORMATION

8 MM DD YY 13
Last Name: Level
Owner: Level
First Name: Cheryl
Street or RFD: 2972 Jennings Chapel Rd
Town: Woodbine Md 21797


LOCATION OF WELL

3 Howard
8 COUNTY 21
23 SUBDIVISION 42
SECTION 44 46 LOT 48 50
52 NEAREST TOWN Woodbine 71
MILES FROM TOWN (enter 0 if in town) 6 MI

DRILLER INFORMATION

Driller's Name: Joseph L Mayne M SD 024
Firm Name: Joseph L Mayne Well Drillers
Address: 5512 Ridge Rd Mt. Airy Md 21771
Signature: Joseph L Mayne
Date: 9-17-2010

DIRECTION OF WELL FROM TOWN (CIRCLE BOX)

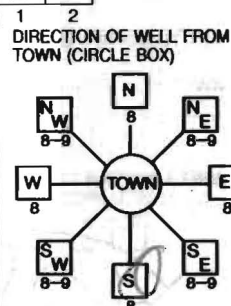

2972 Jennings Chapel Rd
NEAR WHAT ROAD: 11 30
ON WHICH SIDE OF ROAD (CIRCLE APPROPRIATE BOX): NORTH, WEST, SOUTH, EAST. Box 'S' is circled.
DISTANCE FROM ROAD: 175 FT
ENTER FT OR MI: FT
TAX MAP: 13 BLK: 21 PARCEL: 296

WELL INFORMATION
APPROX. PUMPING RATE (GAL. PER MIN.): 4
AVERAGE DAILY QUANTITY NEEDED (GAL. PER DAY): 500

USE FOR WATER (CIRCLE APPROPRIATE BOX)

- Domestic Potable Supply & Residential Irrigation (circled)
Farming (Livestock Watering & Agricultural Irrigation)
Industrial, Commercial, Dewatering
Public Water Supply Well
Test, Observation, Monitoring
Geo-Thermal

NOT TO BE FILLED IN BY DRILLER HEALTH DEPARTMENT APPROVAL

Howard (13) P516530?
COUNTY NAME: Howard COUNTY NO.
STATE SIGNATURE: Brian Baker
DATE ISSUED: 9/17/2010
CO SIGNATURE: Brian Baker
EXP. DATE: 9/17/2011
NORTH GRID: 530 000 EAST GRID: 772 000

APPROXIMATE DEPTH OF WELL: 400 FEET
APPROXIMATE DIAMETER OF WELL: 6 INCH NEAREST INCH


METHOD OF DRILLING (circle one)

- Bored (or Augered)
JETTED
Jetted & DRIVEN
AIR-ROTary
AIR-PERCussion
ROTARY (Hydraulic Rotary)
CABLE
REVerse-ROTary
DRive-POINT
other

REPLACEMENT OR DEEPEMED WELLS (CIRCLE APPROPRIATE BOX)

- N THIS WELL WILL NOT REPLACE AN EXISTING WELL
Y THIS WELL WILL REPLACE A WELL THAT WILL BE ABANDONED AND SEALED
S THIS WELL WILL REPLACE A WELL THAT WILL BE USED AS A STANDBY-CONTACT LOCAL APPROVING AUTHORITY FOR POLICY ON STANDBY WELLS
D THIS WELL WILL DEEPEM AN EXISTING WELL
PERMIT NUMBER OF WELL TO BE REPLACED OR DEEPEMED (IF AVAILABLE) 41 52

SHOW MAJOR FEATURES OF BOX & LOCATE WELL WITH AN X
SOURCES OF DRILLING WATER: 1. well
WRITE THE BOX NUMBER FROM THE MAP HERE: E 772, N 530

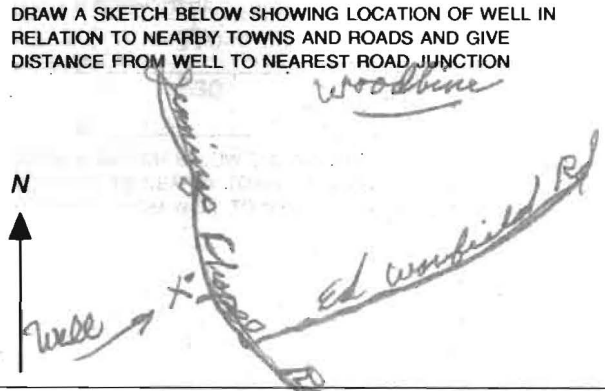

Not to be filled in by driller (MDE OR COUNTY USE ONLY)

APPROX. PERMIT NUMBER: G
PERMIT No. HO-95-2007


SPECIAL CONDITIONS
NOTE - APPROVING AUTHORITIES SHOULD USE SEPARATE SHEET IF NEEDED



SITE INSPECTION SHEET

OWNER: \_\_\_\_\_ PHONE #: \_\_\_\_\_  
ADDRESS: 2972 Jennings Chapel Rd. CONTRACTOR: J. Mayne  
WELL TAG #: HO-95-2007  
SUBDIVISION: \_\_\_\_\_ LOT: \_\_\_\_\_ COUNTY #: \_\_\_\_\_  
PROPOSAL: \_\_\_\_\_

LOCATION DIAGRAM

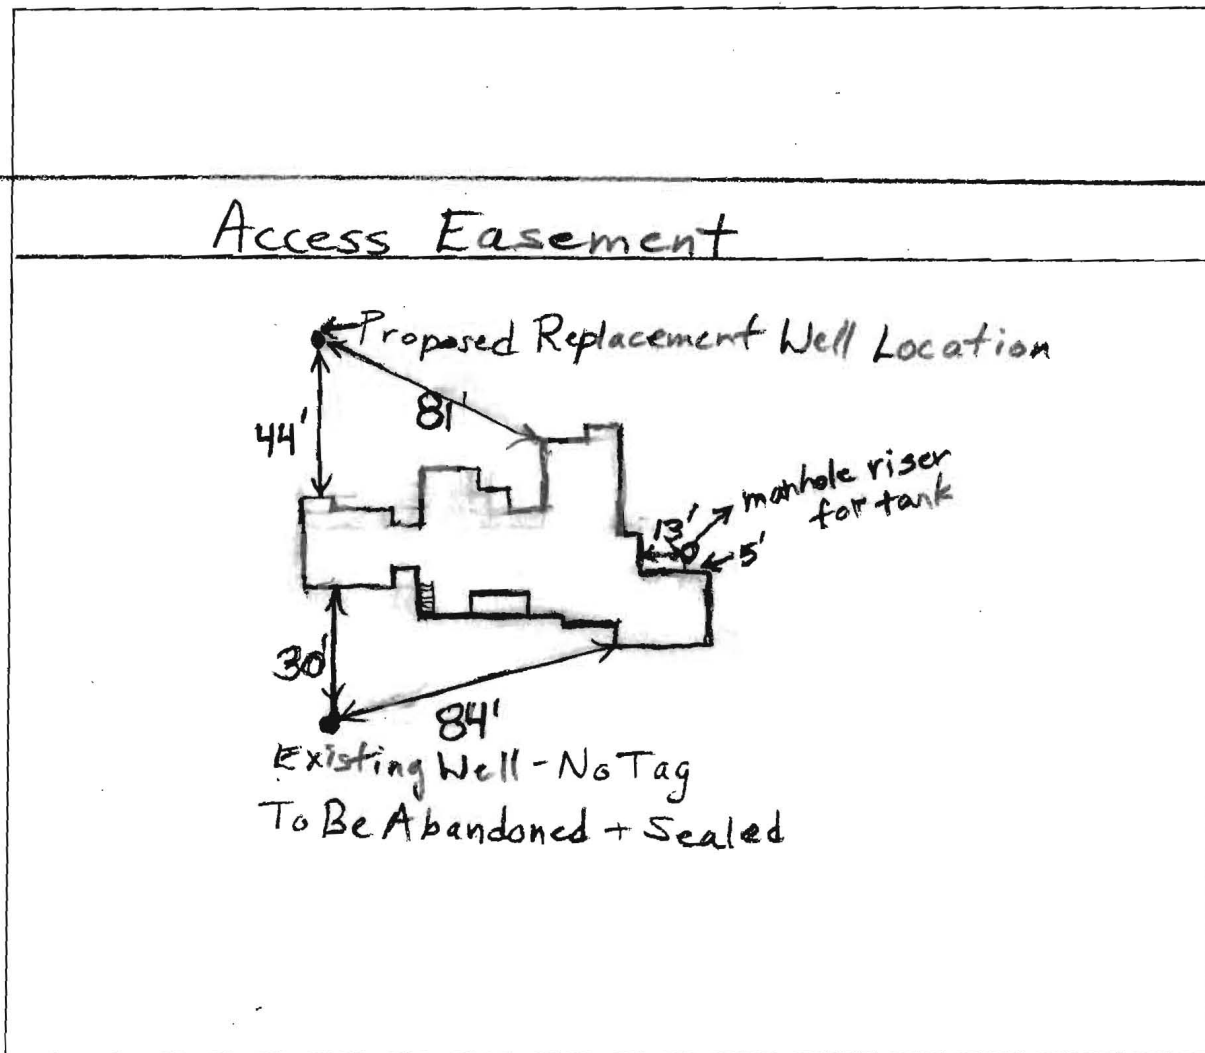

COMMENTS: Met Joe and homeowner at site. Existing well has been gravel packed to grade and still has a terrible sediment problem. To be sealed.

DATE: 9/17/2010 INSPECTOR: B. Baker

B 1 1498

SEQUENCE NO. (MDE USE ONLY)

STATE OF MARYLAND APPLICATION FOR PERMIT TO DRILL WELL

STATE PERMIT NUMBER

40-94-3565 fill in this form completely

please type

Date Received (APA)

11/13/02

OWNER INFORMATION

9344

B 3

Howard

LOCATION OF WELL

CC#

8 MM DO YY 13

15 Last Name KROPP MAIJA Owner First Name 34

2972 JENNINGS CHAPEL RD

36 Street or RFD MT. AIRY, MD 21771 55

57 Town 70 State 72 Zip 76

DRILLER INFORMATION

George F. Easterday M WD 040 Driller's Name 76 License No. 81

L. Franklin Easterday, Inc. Firm Name

9265 Brown Church Rd., MT. Airy, Md. 21771 Address

George F. Easterday Signature 11/13/2002 Date

8 COUNTY 21

23 SUBDIVISION 42


SECTION 44 46 LOT 48 50 Florence

52 NEAREST TOWN 71

MILES FROM TOWN (enter 0 if in town) 1 M I 73 76 77 78

B 4

DIRECTION OF WELL FROM TOWN (CIRCLE BOX)

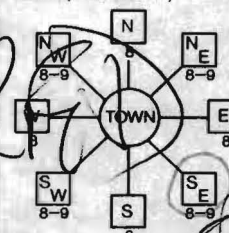

2972 Jennings Chapel Rd

11 NEAR WHAT ROAD 30

ON WHICH SIDE OF ROAD (CIRCLE APPROPRIATE BOX)



34 50 37 DISTANCE FROM ROAD ENTER FT OR MI 38 39

TAX MAP: 13 BLK: 296 PARCEL 21

B 2

WELL INFORMATION

APPROX. PUMPING RATE (GAL. PER MIN.)

5

AVERAGE DAILY QUANTITY NEEDED (GAL. PER DAY) 14 20

USE FOR WATER (CIRCLE APPROPRIATE BOX)

DOMESTIC POTABLE SUPPLY & RESIDENTIAL IRRIGATION

FARMING (LIVESTOCK WATERING & AGRICULTURAL IRRIGATION)

INDUSTRIAL, COMMERCIAL, DEWATERING

PUBLIC WATER SUPPLY WELL

TEST, OBSERVATION, MONITORING

GEO-THERMAL

NOT TO BE FILLED IN BY DRILLER HEALTH DEPARTMENT APPROVAL

Howard COUNTY NAME 516530 COUNTY NO.

STATE SIGNATURE INSERT S 41

DATE ISSUED 11/13/02 Steven R. King 11/13/03 CO SIGNATURE EXP. DATE

NORTH GRID 50 000 EAST GRID 770 000 55 57 63

APPROXIMATE DEPTH OF WELL 300 FEET 24 28

APPROXIMATE DIAMETER OF WELL 6 INCH NEAREST INCH

METHOD OF DRILLING (circle one)

BORED (or Augered) JETTED Jetted & DRIVEN

AIR-ROTary AIR-PERcussion ROTARY (Hydraulic Rotary)

CABLE REVERSE-ROTary DRIVE-POINT

other

REPLACEMENT OR DEEPEINED WELLS (CIRCLE APPROPRIATE BOX)

THIS WELL WILL NOT REPLACE AN EXISTING WELL

THIS WELL WILL REPLACE A WELL THAT WILL BE ABANDONED AND SEALED

THIS WELL WILL REPLACE A WELL THAT WILL BE USED AS A STANDBY-CONTACT LOCAL APPROVING AUTHORITY FOR POLICY ON STANDBY WELLS

THIS WELL WILL DEEPEIN AN EXISTING WELL

PERMIT NUMBER OF WELL TO BE REPLACED OR DEEPEINED (IF AVAILABLE) 41 52

Not to be filled in by driller (MDE OR COUNTY USE ONLY)

APPROP. PERMIT NUMBER G

PERMIT No. 40-94-3565 70 71 72 73 74 75 76 77 78 79

SPECIAL CONDITIONS

NOTE - APPROVING AUTHORITIES SHOULD USE SEPARATE SHEET IF NEEDED

SHOW MAJOR FEATURES OF BOX & LOCATE WELL WITH AN X


SOURCES OF DRILLING WATER

- 1. wells
- 2.
- 3.

WRITE THE BOX NUMBER FROM THE MAP HERE

E 770 000 530 000 N

DRAW A SKETCH BELOW SHOWING LOCATION OF WELL IN RELATION TO NEARBY TOWNS AND ROADS AND GIVE DISTANCE FROM WELL TO NEAREST ROAD JUNCTION

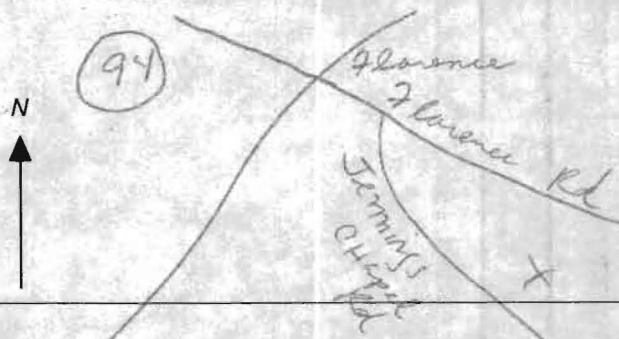

11/13/02 10-11 AM

# NOT AS A RESULT OF DROUGHT

## SITE INSPECTION SHEET

OWNER: Steven Krupp PHONE #: \_\_\_\_\_


ADDRESS: 2972 JENNINGS CHAPEL ROAD CONTRACTOR: EASTEDAY

WELL TAG #: HO-94-3565

SUBDIVISION: \_\_\_\_\_ LOT: \_\_\_\_\_ COUNTY #: Howard

PROPOSAL: Replacement Well - out of water Confirm second party HAS WPI FORM & knows to call in a WPI KN

### LOCATION DIAGRAM

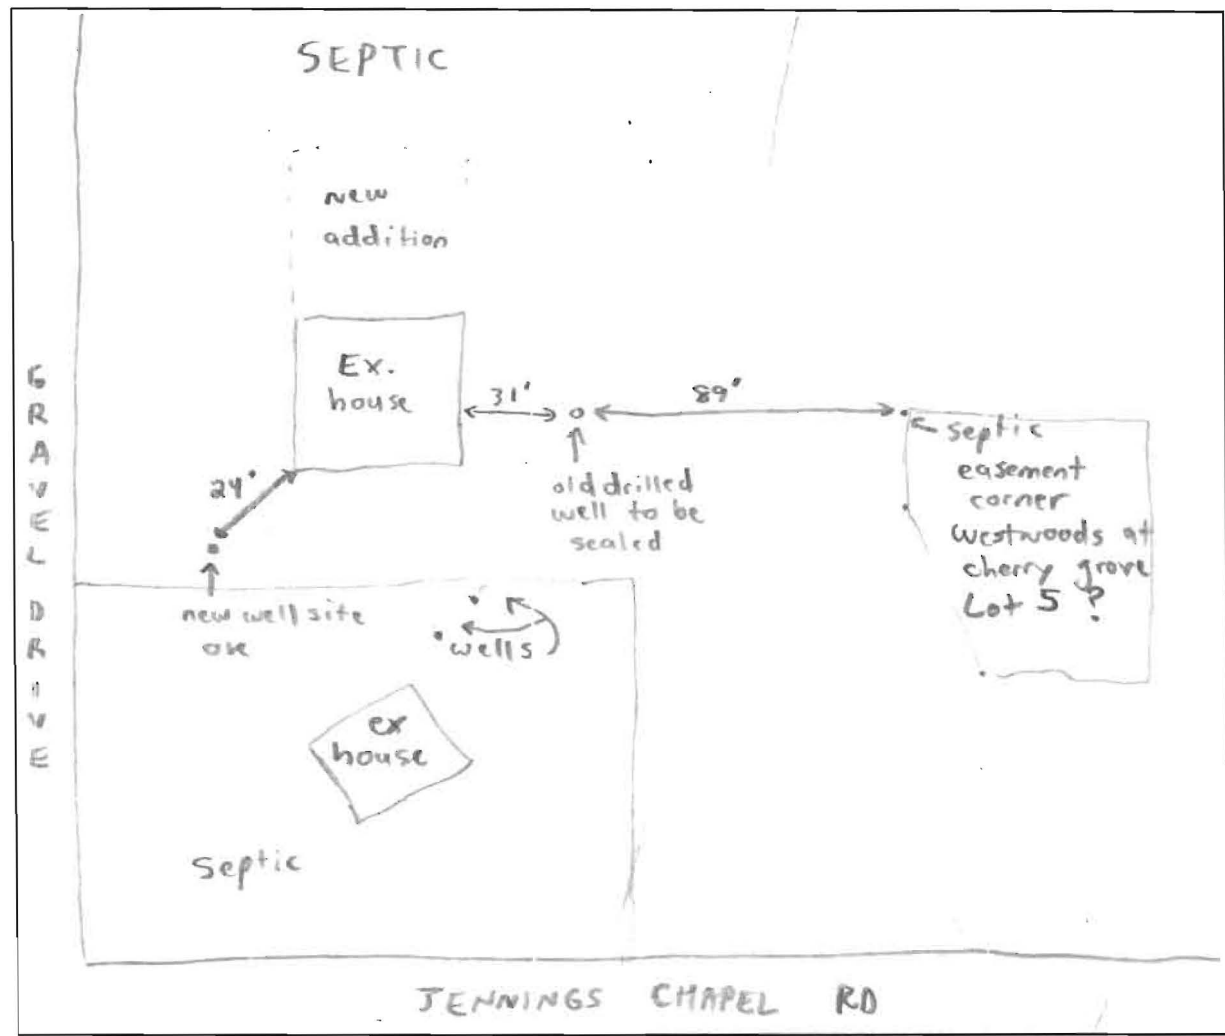

COMMENTS: Well not dry but of old construction. OK to drill at site selected. Verified surrounding wells & septic's. Old well to be sealed.

DATE: 11/13/02 INSPECTOR: Steven R. Krug