

LAYOUT _____ INSP 4 _____
INSP 2 _____ INSP 5 _____
INSP 3 _____ INSP 6 _____

ISSUE DATE: 10/16/07

APPROVAL DATE: 10/19/07



PERMIT

P 527864

A 527344

ON-SITE SEWAGE DISPOSAL SYSTEM HOWARD COUNTY HEALTH DEPARTMENT BUREAU OF ENVIRONMENTAL HEALTH

West End Renovations IS PERMITTED TO INSTALL ALTER

ADDRESS: 766 W. Watersville Rd., Mt Airy PHONE NUMBER: 443-398-1278

SUBDIVISION: _____ LOT NUMBER: _____

ADDRESS: 2550 Jennings Chapel Rd. PROPERTY OWNER: Bennett

SEPTIC TANK CAPACITY (GALLONS): 500 OUTLET BAFFLE FILTER REQUIRED

PUMP CHAMBER CAPACITY (GALLONS): N/A COMPARTMENTED TANK REQUIRED

NUMBER OF BEDROOMS: 3

SQUARE FEET PER BEDROOM: N/A


LINEAR FEET OF TRENCH REQUIRED: N/A

TRENCHES:	
LOCATION:	Install a 500 gallon septic tank in series with the existing 1,000 gallon septic tank to total 1,500 gallons of storage for a home larger than 1,500 square feet but smaller than 3,500 square feet as required by Howard County Code
NOTES:	Maintain 20 feet from the proposed addition.

PLANS APPROVED: Gabe Creighton DATE: 10/10/2007

- NOTE: PERMIT VOID AFTER 2 YEARS
- NOTE: CONTRACTOR RESPONSIBLE FOR SCHEDULING A PRE-CONSTRUCTION INSPECTION FOR ALL INSTALLATIONS
- NOTE: WATERTIGHT SEPTIC TANKS REQUIRED
- NOTE: ALL PARTS OF SEPTIC SYSTEM SHALL BE 100 FEET FROM ANY WATER WELL
- NOTE: MANHOLE RISERS REQUIRED ON ALL SEPTIC TANKS AND PUMP CHAMBERS UNLESS SPECIFICALLY AUTHORIZED

NEITHER THE HOWARD COUNTY COUNCIL NOR THE HEALTH DEPARTMENT IS RESPONSIBLE FOR THE SUCCESSFUL OPERATION OF ANY SYSTEM. PERMITTEE RESPONSIBLE FOR OBTAINING FINAL APPROVAL ON THIS PERMIT. CALL 410-313-2640 FOR INSPECTION OF SEPTIC SYSTEM

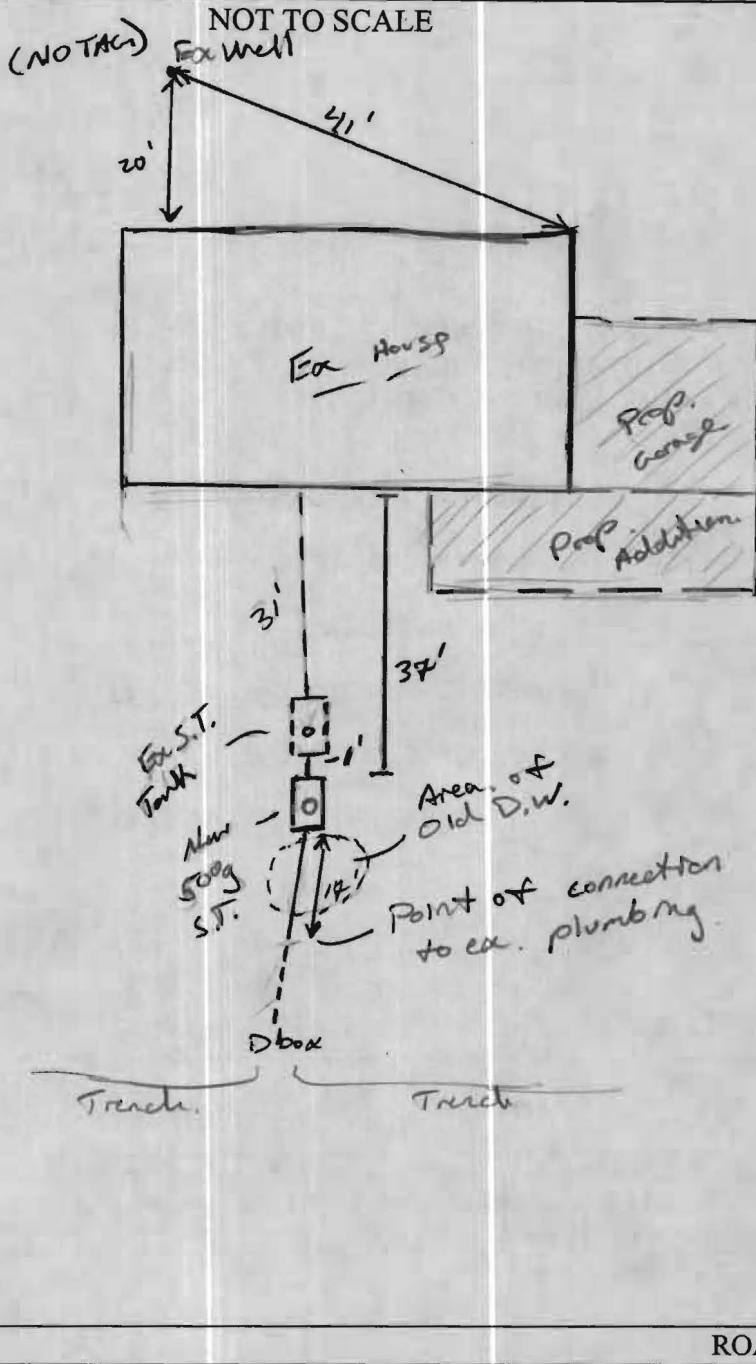

TRENCH/DRAINFIELD DATA

WIDTH	INLET	BOTTOM
_____	_____	_____
NUMBER OF TRENCHES _____		
TOTAL LENGTH _____		
ABSORPTION AREA _____		
DISTRIBUTION BOX LEVEL _____		
DISTRIBUTION BOX BAFFLE _____		
DISTRIBUTION BOX PORT _____		

SEPTIC TANK DATA

SEPTIC TANK 1 LEVEL _____

CAPACITY _____ GAL

SEAM LOC mid.

TANK LID DEPTH 3.5'

BAFFLES _____

BAFFLE FILTER _____

MANHOLE LOC _____

6" PORT LOC center

WATERTIGHT TEST _____

SEPTIC TANK 2 LEVEL Yes

CAPACITY 500 GAL

SEAM LOC Top

TANK LID DEPTH 4'

BAFFLES Yes

BAFFLE FILTER _____

MANHOLE LOC center

6" PORT LOC _____

WATERTIGHT TEST _____

PRE-CONSTRUCTION

INSTALLATION: 10/19/07 Added 500g S.T. Installed behind Ex. S.T. Contractor found old D.W. Pumped and collapsed. Filled in w/ stone. OK to backfill (150)

FINAL INSPECTOR K. Wally DATE OF APPROVAL 10/19/07