

DEPARTMENT OF INSPECTIONS, LICENSES AND PERMITS
3430 COURT HOUSE DRIVE
ELLCOTT CITY, MD 21043
PERMITS (410)313-2466
INSPECTIONS(410)313-1850

HOWARD COUNTY

HEATING-VENTILATION-AIR CONDITIONING AND REFRIGERATION PERMIT APPLICATION

HVACR PERMIT # MI11000688
BUILDING PERMIT #

BUILDING ADDRESS: SUITE/APT:

OWNERS NAME: BEN MOSIEN
ADDRESS: 9035 JEFFERSON ST

SUBDIVISION: SECTION: AREA:
CENSUS TRACT: TAX MAP: PARCEL:
LOT: TAX MAP: PARCEL:
BLOCK: ZONE:

CITY: JESSUP
STATE: MD ZIP CODE: 20794

PROPERTY ID: MAP COORDINATES:

HOME PHONE: WORK PHONE:

TYPE OF IMPROVEMENT: USE:

CHECK ONE

- SINGLE FAMILY DWELLING
- SINGLE FAMILY TOWNHOUSE
- MULTI-FAMILY
- COMMERCIAL USE

COMPANY NAME: ARUNDEL COOLING
LICENSEE NAME: JOHN VAN HORNE
ADDRESS: 707 NURSERY ROAD
CITY: LINTHICUM
STATE: MD ZIP CODE: 21090
PHONE: 410-789-8300 HVACR LICENSE NO: 2612

RESIDENTIAL COMMERCIAL
(Check appropriate category)

New

- Heating and Air Conditioning
- Heating System Only
- Other Work (Describe):

Replacement

- Heating
- Air Conditioning

2 ZONES

Additions and Alterations

- Heating
- Air Conditioning

INSTALLING A Geothermal Two stage split system

Total Fee Due: \$ 924.00

I HAVE CAREFULLY EXAMINED AND READ THIS APPLICATION AND KNOW IT IS TRUE AND CORRECT. THE WORK DESCRIBED HEREIN WILL BE PERFORMED BY A STATE HVACR LICENSED PERSON(S), AND ALL WORK WILL BE PERFORMED IN COMPLIANCE WITH APPLICABLE CODES AND STANDARDS OF HOWARD COUNTY AND THE STATE OF MARYLAND.

[Signature]
SIGNATURE OF APPLICANT DATE

JOHN VAN HORNE
PRINT NAME OF APPLICANT


Validation

Check Number: 20713
Cash: _____
Receipt Number: 246998

Make check payable to: DIRECTOR OF FINANCE OF HOWARD COUNTY

Well + Septic

m11000688

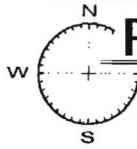


Pacek & Associates, Inc.

Engineers & Surveyors

10319 CITATION WAY
LAUREL, MD. 20723
FAX 410-880-4752
301-362-1031

JEFFERSON STREET

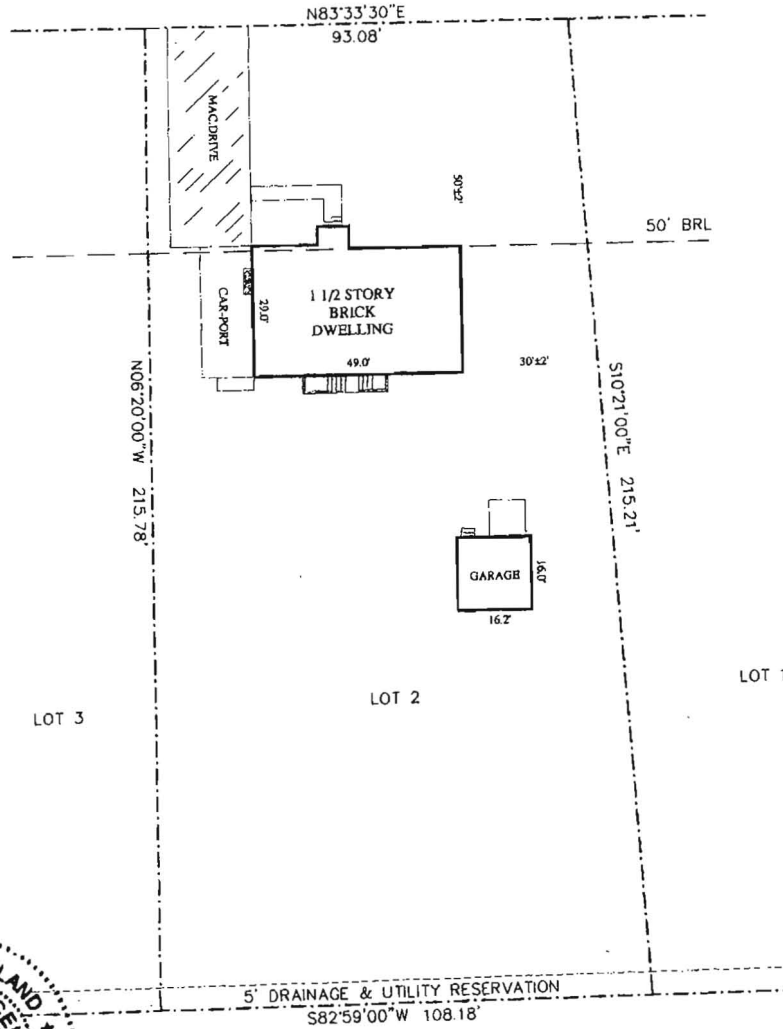

PROPERTY LINE SURVEY IS RECOMMENDED

LOCATION DRAWING FOR: 9035 JEFFERSON STREET

1. This plat is of benefit to the consumer only insofar as it is required by a lender or a title insurance company or its agent in connection with contemplated transfer, financing, or refinancing.
2. This plat is not to be relied upon for the establishment or location of fences, garages, bulkheads, or other existing or future improvements.
3. This plat does not provide for the accurate identification of property boundary lines, but such identification may not be required for transfer of title, securing financing, or refinancing.
4. A property line survey is necessary to determine the exact location of improvements and encroachments, if any.
5. Distances to property lines are accurate to within 1-foot, unless otherwise shown.
6. All fences shown hereon are approximately located.
7. No title report furnished.

CERTIFICATION:

This is to certify that the improvements indicated hereon are located as shown.

Gerald A. Plack
 Gerald A. Plack L.S. NO. 21259

LIBER 5319 FOLIO 537
 LOT 2 BLOCK
 SECT. PLAT
 SUBD. WINDEMERE ACRES
 PLAT BOOK 4 FOLIO 56
 COUNTY HOWARD CO.
 SCALE 1"=30' CASE NO. 10327LFS
 DATE 9-30-08 JOB NO. CHAA08-171