

M120006342

within the limits of it plain as shown on T

166.00' 100° N 74° 27' 00" W

166.00' 100°


S 15° 33' 00" W

S 15° 33' 00" E

LOT 52

LOT 53
43,693 sq

LOT 54

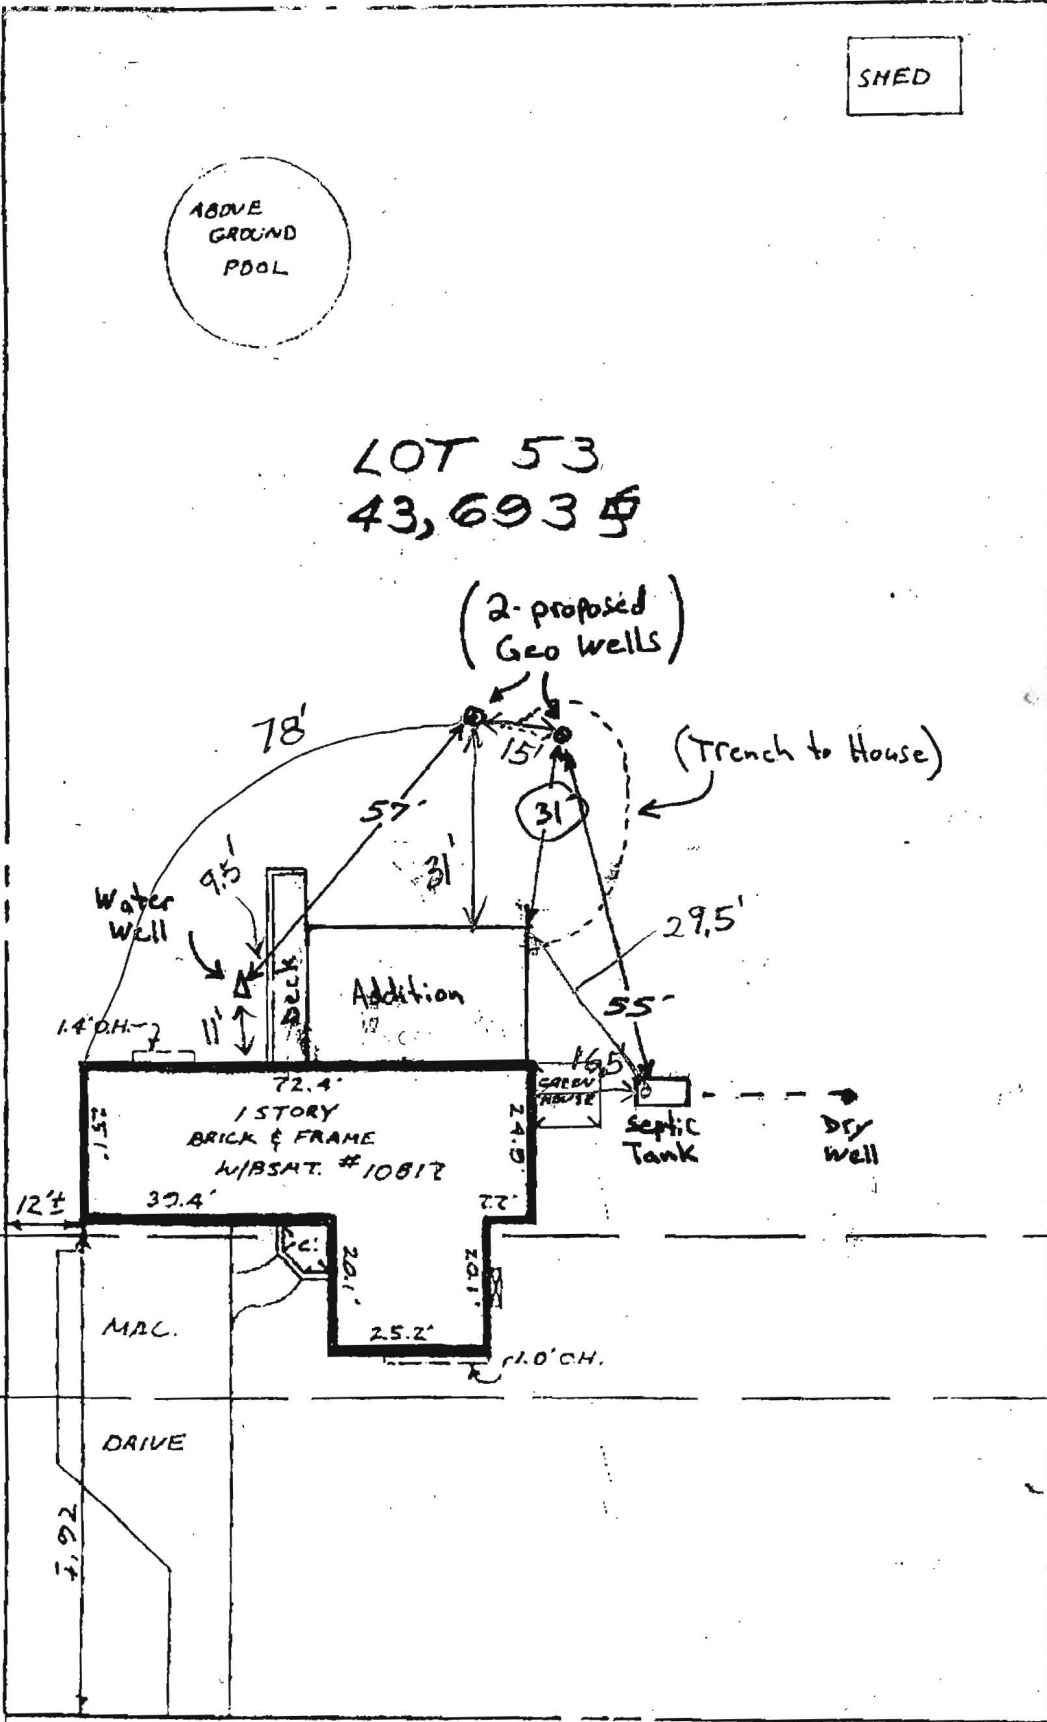

10817 Hunting Lane
Columbia, MD 21044


TE

4/30/2012

Geothermal
Borehole
Locations.

(BB)

(2-proposed
Geo wells)

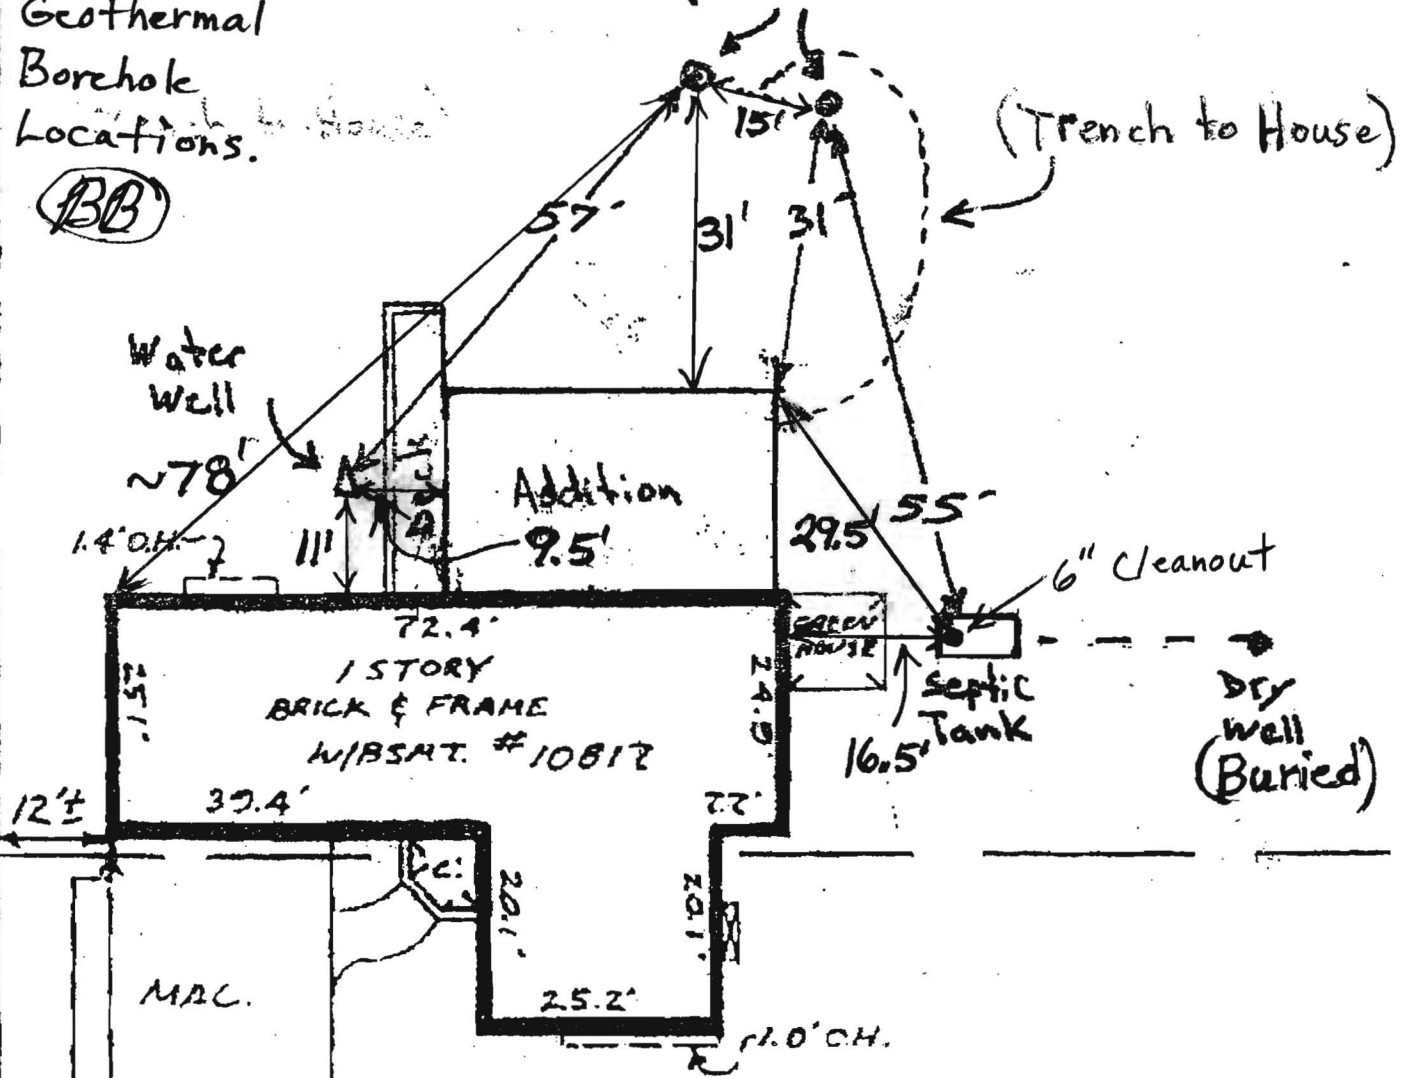

It Appears That
Public Water and Sewer
Connections are In the
Front Yard

S74°27'00" E

166.0

10817 Hunting Lane
Columbia, MD 21044