

# APPLICATION

FOR PERCOLATION TESTING AND SITE EVALUATION

EST DATE(S) \_\_\_\_\_ TEST TIME \_\_\_\_\_

AP 520082-D

AGENCY REVIEW: \_\_\_\_\_

DATE 3/5/04

DO NOT WRITE ABOVE THIS LINE

HEREBY APPLY FOR THE NECESSARY TESTING/EVALUATION PRIOR TO ISSUANCE OF SEWAGE DISPOSAL SYSTEM PERMIT(S) TO:

CHECK AS NEEDED:

- CONSTRUCT NEW SEPTIC SYSTEM(S)
- REPAIR/ADD TO AN EXISTING SEPTIC SYSTEM
- REPLACE AN EXISTING SEPTIC SYSTEM

CHECK AS NEEDED:

- NEW STRUCTURE(S)
- ADDITION TO AN EXISTING STRUCTURE
- REPLACE AN EXISTING STRUCTURE

CHECK ONE:

- CREATE NEW LOT(S)
- BUILD ON AN EXISTING LOT IN A SUBDIVISION
- BUILD ON AN EXISTING PARCEL OF RECORD

IS THE PROPERTY WITHIN 2500' OF ANY RESERVOIR?

- YES
- NO

THE TYPE OF STRUCTURE IS:

- RESIDENTIAL WITH UNKNOWN PROPOSED BEDROOMS IN THE COMPLETED STRUCTURE (NOTE UNKNOWN IF APPROPRIATE)
- COMMERCIAL (PROVIDE DETAIL OF NUMBERS AND TYPES OF EMPLOYEES/ CUSTOMERS ON ACCOMPANYING PLAN)
- INSTITUTIONAL/GOVERNMENT (PROVIDE DETAIL OF NUMBERS AND TYPES OF EMPLOYEES/USERS ON ACCOMPANYING PLAN)

PROPERTY OWNER(S) PRINCE FLORENCE UNDINE

DAYTIME PHONE \_\_\_\_\_ CELL \_\_\_\_\_ FAX \_\_\_\_\_

MAILING ADDRESS \_\_\_\_\_  
STREET CITY/TOWN STATE ZIP

APPLICANT Hailey Development c/o RICH THOMETZ

DAYTIME PHONE (301) 476-7715 CELL (301) 346-1037 FAX (301) 476-7717

MAILING ADDRESS 3905 NATIONAL DRIVE, SUITE 105, BURTONSVILLE MD. 20866  
STREET CITY/TOWN STATE ZIP

APPLICANT'S ROLE: DEVELOPER BUILDER BUYER RELATIVE/FRIEND REALTOR CONSULTANT

PROPERTY LOCATION  
SUBDIVISION/PROPERTY NAME PRINCE PROPERTY LOT NO. 5

PROPERTY ADDRESS END OF HUNTERBROOKE LANE / HUNTFIELD DRIVE  
STREET TOWN/POST OFFICE

AX MAP PAGE(S) 46 GRID 1 1/7 PARCEL(S) 104 PROPOSED LOT SIZE 3 AC. +

I, APPLICANT, I UNDERSTAND THE FOLLOWING: THE SYSTEM INSTALLED SUBSEQUENT TO THIS APPLICATION IS ACCEPTABLE ONLY UNTIL PUBLIC SEWERAGE IS AVAILABLE. THIS APPLICATION IS COMPLETE WHEN ALL APPLICABLE FEES AND A DETAILED SITE PLAN HAVE BEEN RECEIVED. I ACCEPT THE RESPONSIBILITY FOR COMPLIANCE WITH ALL M.O.S.H.A. AND "MINIMUM UTILITY" REQUIREMENTS. APPROVAL IS BASED UPON SATISFACTORY REVIEW OF A PERC CERTIFICATION PLAN.


TEST RESULTS WILL BE MAILED TO APPLICANT.

Zacharia G. Frisch (agent for Developer)  
SIGNATURE OF APPLICANT

HOWARD COUNTY HEALTH DEPARTMENT, BUREAU OF ENVIRONMENTAL HEALTH, WELL AND SEPTIC PROGRAM  
3525-H ELLICOTT MILLS DRIVE, ELLICOTT CITY, MARYLAND 21043-4544 (410) 313-1771 FAX (410) 313-2648  
TDD (410) 313-2323 TOLL FREE 1-877-4MD-DHMH

AP \_\_\_\_\_

621  
 orge brn  
 hvylm  
 4  
 brn  
 samilm  
 DN  
 10-25%  
 Rx  
 12 1/2 UP

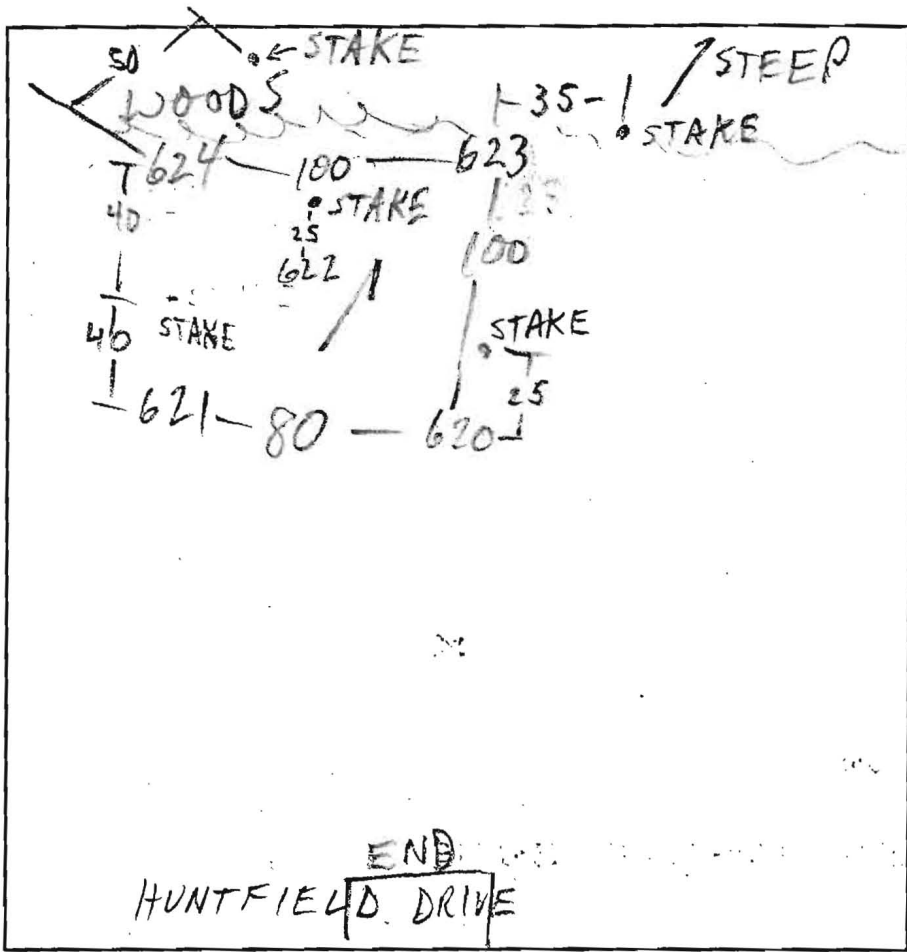

622  
 orge  
 brn  
 hvylm  
 5-5 1/2  
 blue gray  
 tan sand  
 15% Rx  
 7  
 25-35%  
 Rx  
 9  
 10 HARD

623 624  
 orge  
 brn  
 hvylm  
 4-4 1/2  
 tan  
 samilm  
 10-15%  
 frags  
 12 1/2  
 13

DATE	TEST #	DEPTH	START	BREAK 1" DROP	STOP 2" DROP	TIME OF 2ND INCH	P/F/H
4/14/04	623	6 1/2	1:35	1:41	1:49	8	P
	624 v	13					P
	621 s	4 1/2	1:55	2:02	2:18	16 EST	P
	620 m	8 1/2	2:30-15	2:34	2:41	7	P
	622 m	7? 10	3:21	3:25	3:28	3	P

620  
 orge  
 brn hvylm  
 lm +  
 sacilm  
 5 1/2  
 blue gray  
 tan  
 sand  
 15-20%  
 frags  
 7 w depth  
 11 HARD BOT

REMARKS ALL HOLES NOT PER PLAN  
 SANITARIAN M. Ripkin BACKHOE K&K OTHERS Hailey Dev  
 TEST HOLES USED IN SDA ALL AVG. PERC TIME 8 1/2 SQ. FT/BR 210  
 TRENCH WIDTH 3 INLET DEPTH 3 1/2 MAX. BOT DEPTH 5 1/2 EFFECTIVE SW 0-1.5



MIB2

MIB3

MIC3

24' Private  
Use - In-Common  
Drainage  
Access  
Utility Easement for  
lots A, 5, 6, 7

SSF  
75' BRL

Proposed Septic  
Easement  
10,037 SF

FF: 401.00  
B: 392.00

LOT 6  
3.177±Ac.  
(Net: 3.109±Ac.)  
Level Spreader (typ)  
25' LF

Signed PC  
3/1/07  
FF: 401.00  
B: 392.00

Proposed Septic  
Easement  
10,005 SF

LOT 5  
3.059±Ac.  
(Net: 3.000±Ac.)

60' BRL

N06°46'19"W  
98.46'

N72°25'21"E  
517.84'

30' BRL

30' BRL

30' BRL

30' BRL

398

398

392

392

406

406

400

400

392

392

406

406

400

400

392

392

406

406

400

400

392

392

406

406

400

400

392

392

406

406

40