

Mr. Robert Weber, R.S., Director
Bureau of Environmental Health
Howard County Health Department
7178 Columbia Gateway Dr.
Columbia, Md. 21046

November 8, 2004

Dear Mr. Weber:

Currently you are considering a perc application for a tenant house on my farm at 2640 Jennings Chapel Road, Woodbine, Md. 21797. I understand from the engineer, FSH Associates, who is assisting me with this matter that you have concerns as to the source of water for this proposed dwelling.

The dwelling being proposed is to replace an existing house trailer. The new dwelling will be a permanent structure and will be serviced by a new well on the same lot as the dwelling. The new dwelling will be in the same location as the one being replaced. Currently this dwelling is serviced by a separate well. My house is serviced by another dedicated well. However, the well servicing the tenant house and the proposed replacement for the tenant house is currently on the one acre lot on which my house sits. I have agreed and will commit to drilling a new well to service the tenant house and further that this new well will be on the lot where the new tenant house is located.

I understand the need for a well on the same parcel as the tenant house and have no problem committing to same. I am requesting to defer the drilling of this well until more details for the tenant house are defined but in any case would commit that the well must be drilled prior to making an application for a building permit for the replacement tenant house.

Thank you for your consideration of this request.

Sincerely,



Paul G. Shoffeitt
2640 Jennings Chapel Road
Woodbine, Md. 21797
410-442-2598

cc: Zach Fisch, FSH Associates

CRUMPLER PLASTIC PIPE, INC.

Manufacturers of Corrugated Plastic Drainage Pipe

P. O. BOX 2068 - ROSEBORO, N.C. 28382


Phone 910-525-4046

E-mail: cppoffice@cpp-pipe.com

Need Language
Guaranteeing Access
(Perpetual)
to Septic Easement
for Existing House

FAX
910-525-5801

TOLL FREE
1-800-334-5071

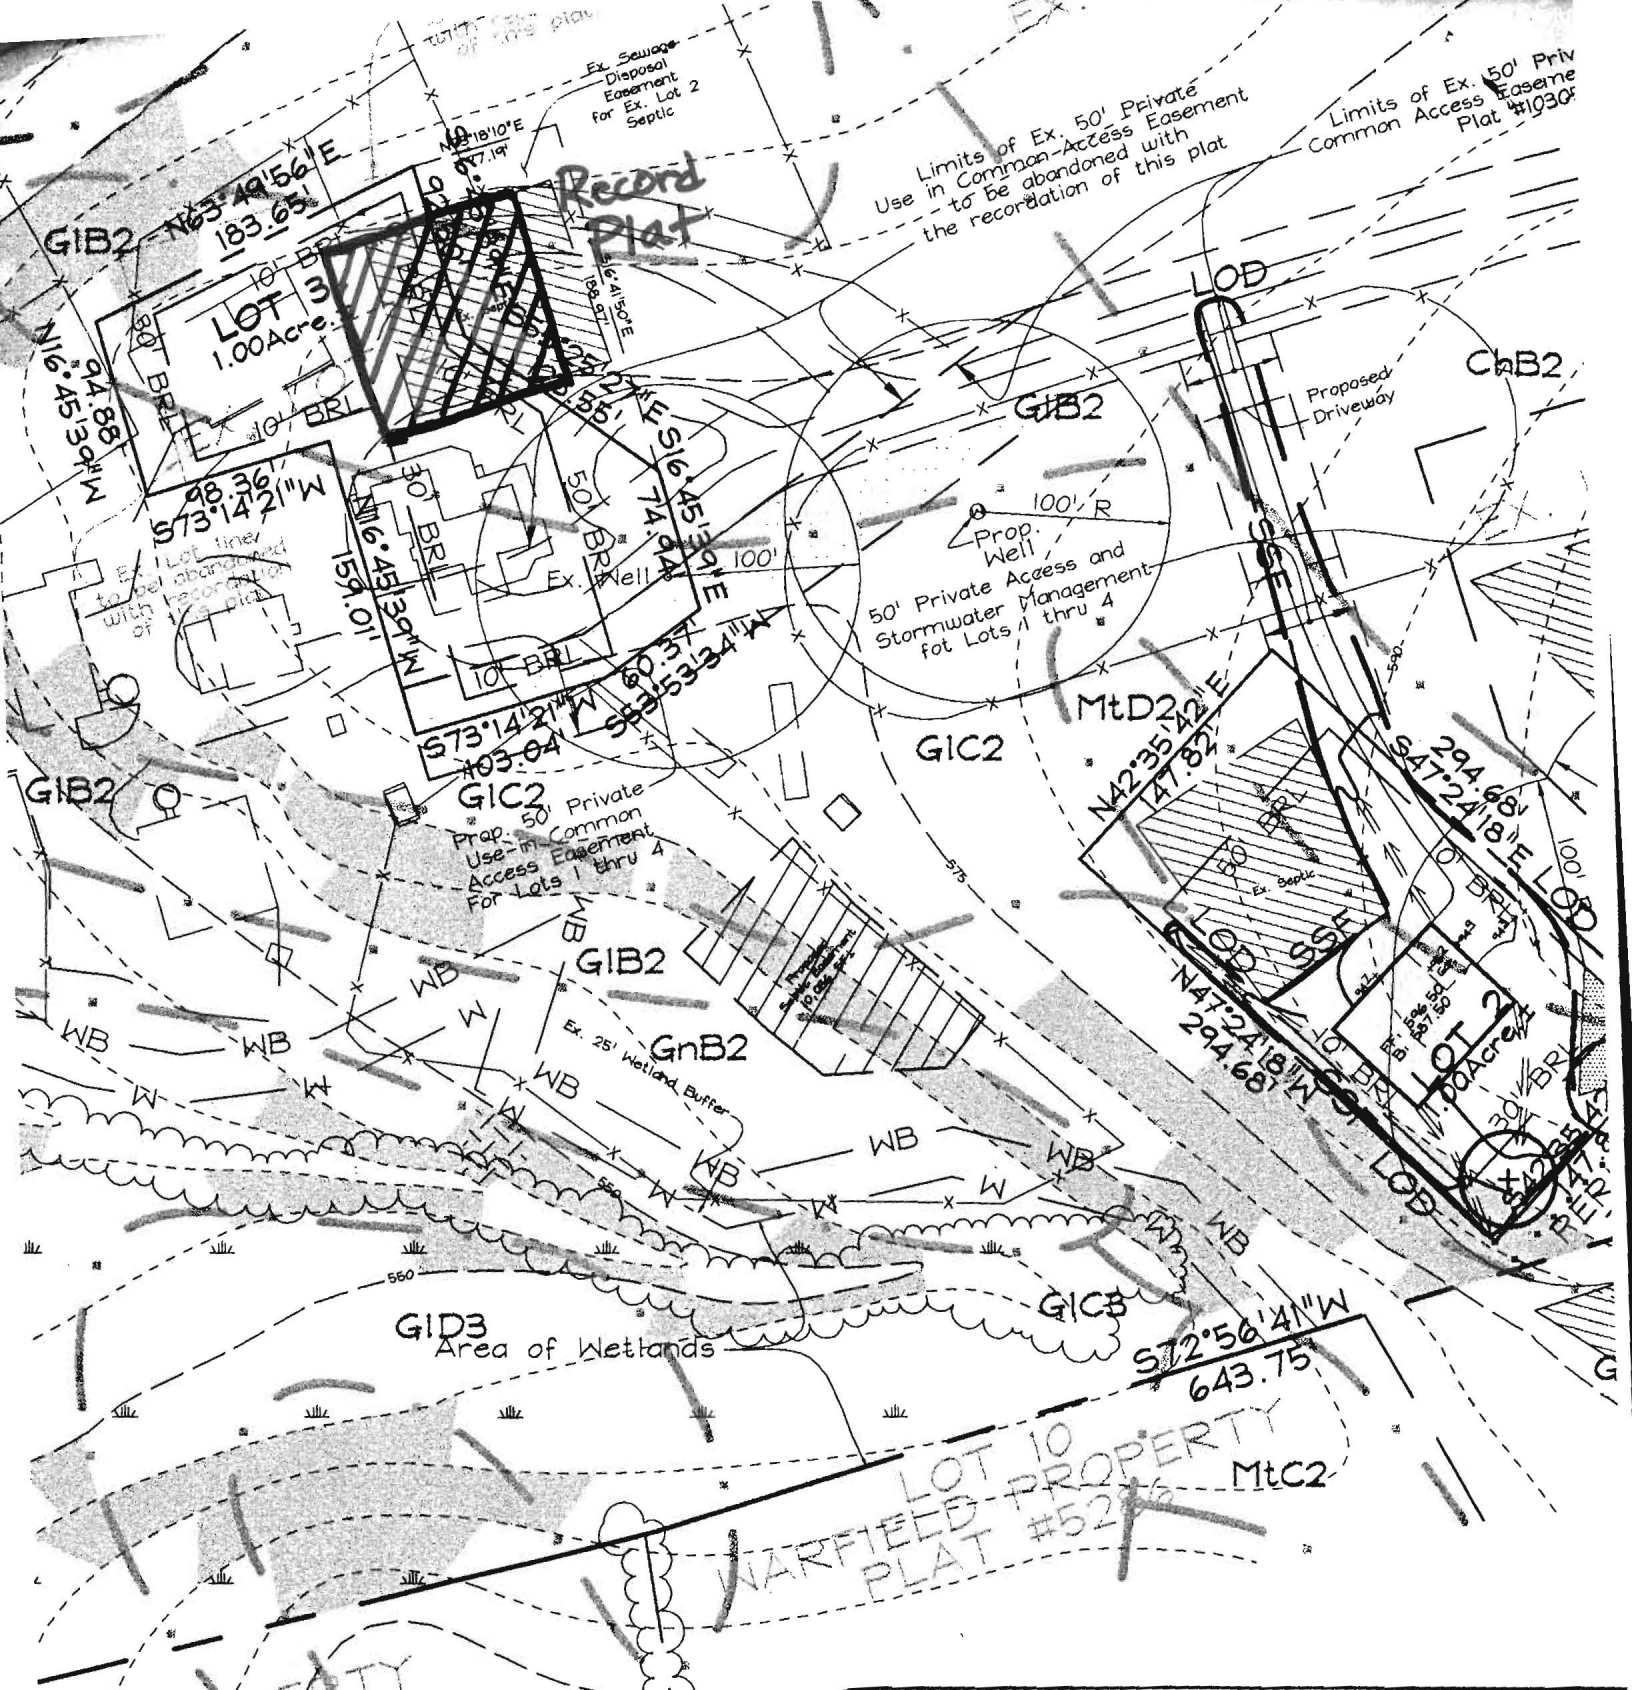

NOTES


SEE 'LANDSCAPE SPECIFICATION GUIDELINES FOR BALTIMORE-WASHINGTON METROPOLITAN AREAS' FOR ALL MATERIAL, PRODUCT, AND PROCEDURE SPECIFICATIONS.

SEE 'LANDSCAPE GUIDELINES' FOR SUPPORTING TREES LARGER THAN 2-1/2" CALIPER.

PLACE UPRIGHT STAKES PARALLEL TO WALKS & BUILDINGS.


KEEP MULCH 1" FROM TRUNK.

SEE ARCHITECTURAL PLANS FOR ADDITIONAL PLANTINGS.

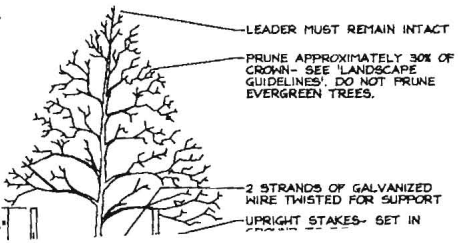

SCHEDULE A PERIMETER LANDSCAPE

CATEGORY	ADJACENT TO ROADWAYS
Perimeter/Frontage Designation	I
Landscape Type	B
Linear Feet of Roadway Frontage/Perimeter	209
Credit for Existing Vegetation (Yes, No, Linear Feet)	No
Remaining Perimeter Length	209
Credit for Wall, Fence or Berm (Yes, No, Linear Feet)	No
Remaining Perimeter Length	

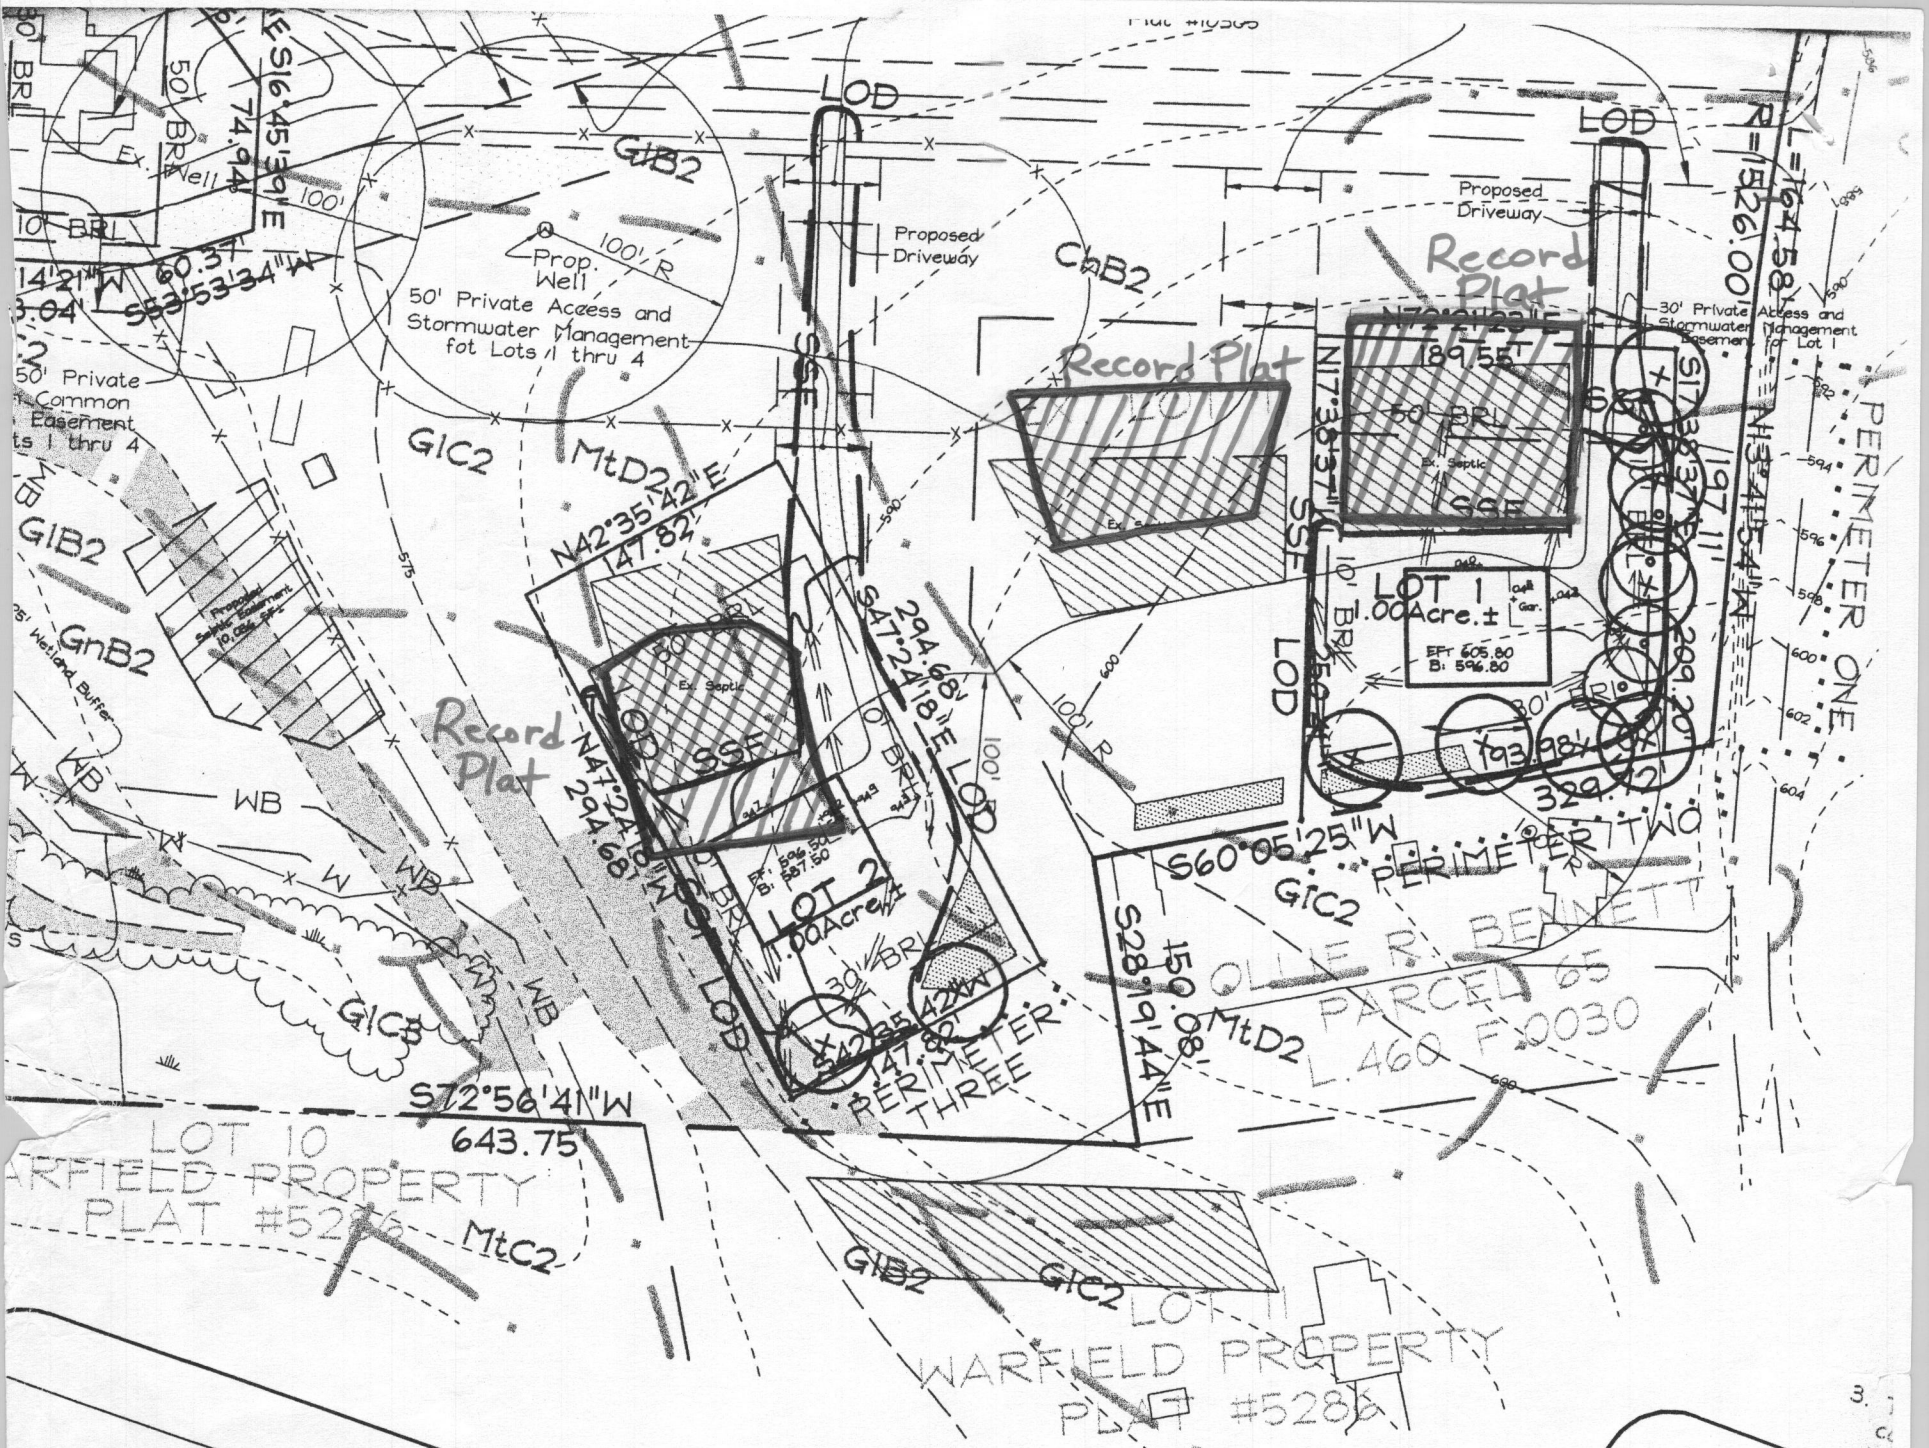

CATEGORY	SCHEDULE A PERIMETER LANDSCAPE EDGE		ADJACENT TO PERIMETER PROPERTIES			
	ADJACENT TO ROADWAYS		1	2	3	4
Perimeter/Frontage Designation	A	B	194	194	148	1095
Perimeter Type	No	No	No	No	No	No
Feet of Roadway	209	209	194	194	148	1095
Age/Perimeter	No	No	No	No	No	No
Existing Vegetation	No	No	No	No	No	No
Perimeter Length (Linear Feet)	209	209	194	194	148	1095
Wall, Fence or Berm	No	No	No	No	No	No
Perimeter Length (Linear Feet)	209	209	194	194	148	1095
Plants Required	No	No	No	No	No	No
Trees	No	No	No	No	No	No
Plants Provided	1:50 4	1:40 5	1:60 3	1:60 2	1:60 18	
Trees	4	5				
(2:1 Substitution)						
(1:1 Substitution)						
(1:1 Substitution Credits)						

KEY	QUAN.	
(+)	27	Acer Rubra
(o)	5	Pinus Strobus

SUPPL LANDSCAPE CHART
LOTS