

APPLICATION

PERCOLATION TESTING

A 37627

P _____

HOWARD COUNTY HEALTH DEPARTMENT
BUREAU OF ENVIRONMENTAL HEALTH
P.O. BOX 476 ELLICOTT CITY, MARYLAND 21043
TELEPHONE: 461-9933

*9/17/86
OK'd pending
approved plan
(SR)*

DISTRICT _____

DATE 9/8/86

TO: THE COUNTY HEALTH OFFICER
ELLICOTT CITY, MARYLAND

I, HEREBY, APPLY FOR THE NECESSARY TEST IN ORDER TO CONSTRUCT (OR RECONSTRUCT) A SEWAGE DISPOSAL SYSTEM.

PROPERTY OWNER Petty, Wilson E. and Barbara M.

ADDRESS 3908 Bruce Lane, Annandale, VA 22003 PHONE (703) 256-2977

PROSPECTIVE BUYER Chaconas, Ted P. and Teresa M.

ADDRESS 19210 New Hamp. Ave., Brinklow, MD 20862 PHONE (301) 924-5192

PROPERTY LOCATION:

SUBDIVISION Mara Meadow LOT NO. 2

ROAD AND DESCRIPTION Jones Road, between Jennings Chapel and Hipsley Mill Rds.
open field on north side of road

TAX MAP 20 PARCEL # 43

SIZE OF LOT 3 acres TYPE BLDG. single family
(SINGLE FAMILY DWELLING OR COMMERCIAL)

THE SYSTEM INSTALLED UNDER THIS APPLICATION IS ACCEPTABLE ONLY UNTIL PUBLIC FACILITIES BECOME AVAILABLE. I FULLY UNDERSTAND THE FEE CONNECTED WITH THE FILING OF THIS PERC TEST APPLICATION IS NON-REFUNDABLE UNDER ANY CIRCUMSTANCES. I ALSO AGREE TO COMPLY WITH ALL M.O.S.H.A. REQUIREMENTS IN TESTING THIS LOT.

Teresa Chaconas 9-8-86
(SIGNATURE OF APPLICANT)

APPROVED BY _____ FOR _____ DATE _____

REJECTED BY _____ FOR _____ DATE _____


HOLD PENDING FURTHER TESTS _____ DATE _____

REASONS FOR REJECTION OR HOLDING for certified hole locations

THIS IS NOT A PERMIT

2B
SOIL PROFILE

0'
silty powdery loam yellow/brown
layers of small frag saprophyte
↓
w/ fine boundary silty loam
11' 5" D

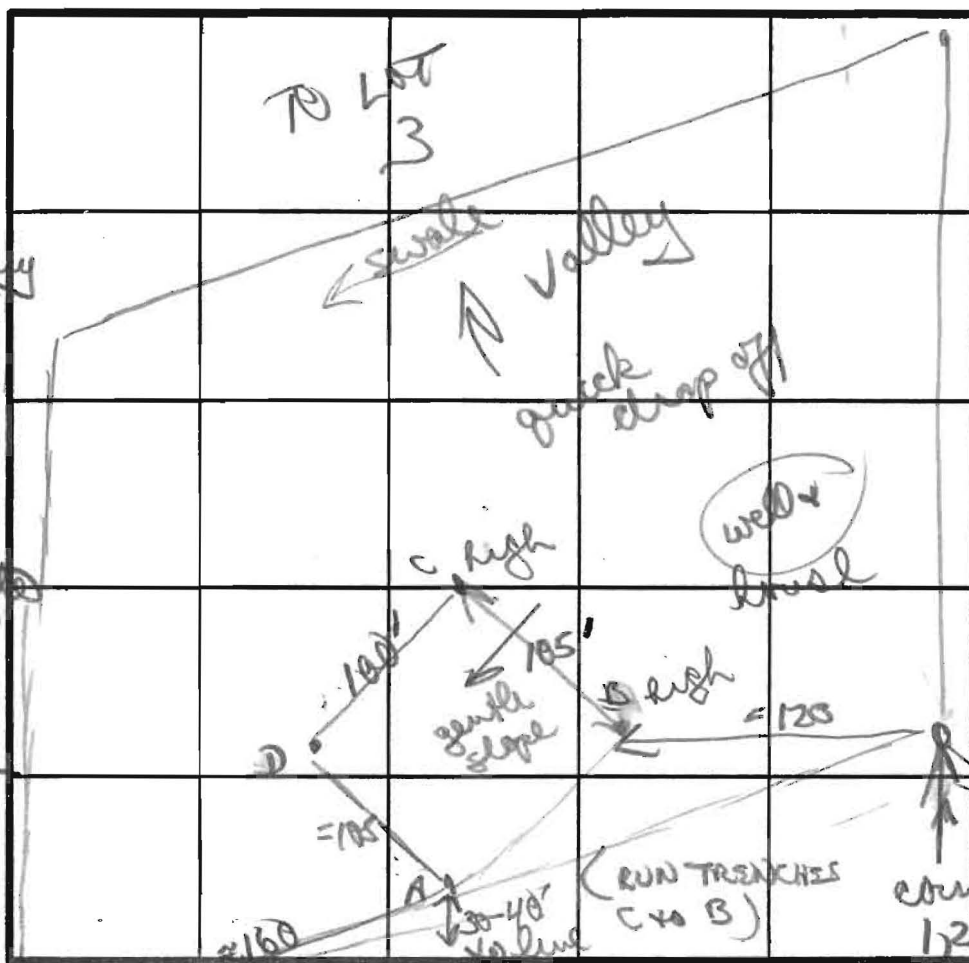

2D
Similar to 2c with rock frags 10-15% (mostly small)
from 4 1/2'
↓
11' 5" D

2c
fine/med from yellow range silty loam
↑% (5-20%) small-med frags sap
rock 11" D

cover 1,65
2A
fine/med silty loam
5'
↑ small-eye frags up to 20%
↓
10' 5" D

INDICATE NORTH - NAME ADJOINING ROADWAY AS BASE LINE.

DATE	TEST NO.	DEPTH	PRE-WET		TEST - 1" DROP		TIME	
			START	STOP	START	STOP		
9/12/86	2B	2' E	138	141	141	145	4 MIN	
		6' m	155	157	157	201	4 MIN	
		11' 5" D	bottom (see profile)					
	2c	2' S	158	200	200	202	2 MIN	
		11' D	bottom (see profile - hard)					
	2D	1 1/2' S	159	201	201	204	3 MIN	
		D	bottom (see profile)					
	2A	2 1/2' S	203	205	205	212	7 MIN	
		10' 5" D	bottom (see profile)					

SHALLOW SYSTEM DUE TO ↑ SAPROYTE % with ↑ Depth

REMARKS


TYPE OF SOIL

TESTED BY

ALSO PRESENT

powdery silty loams; silty loams with 5-20% saprophyte frags
Skip, Red, rocky

~~STATE OF MD. PROPERTY~~
STATE OF MD. PARKLAND

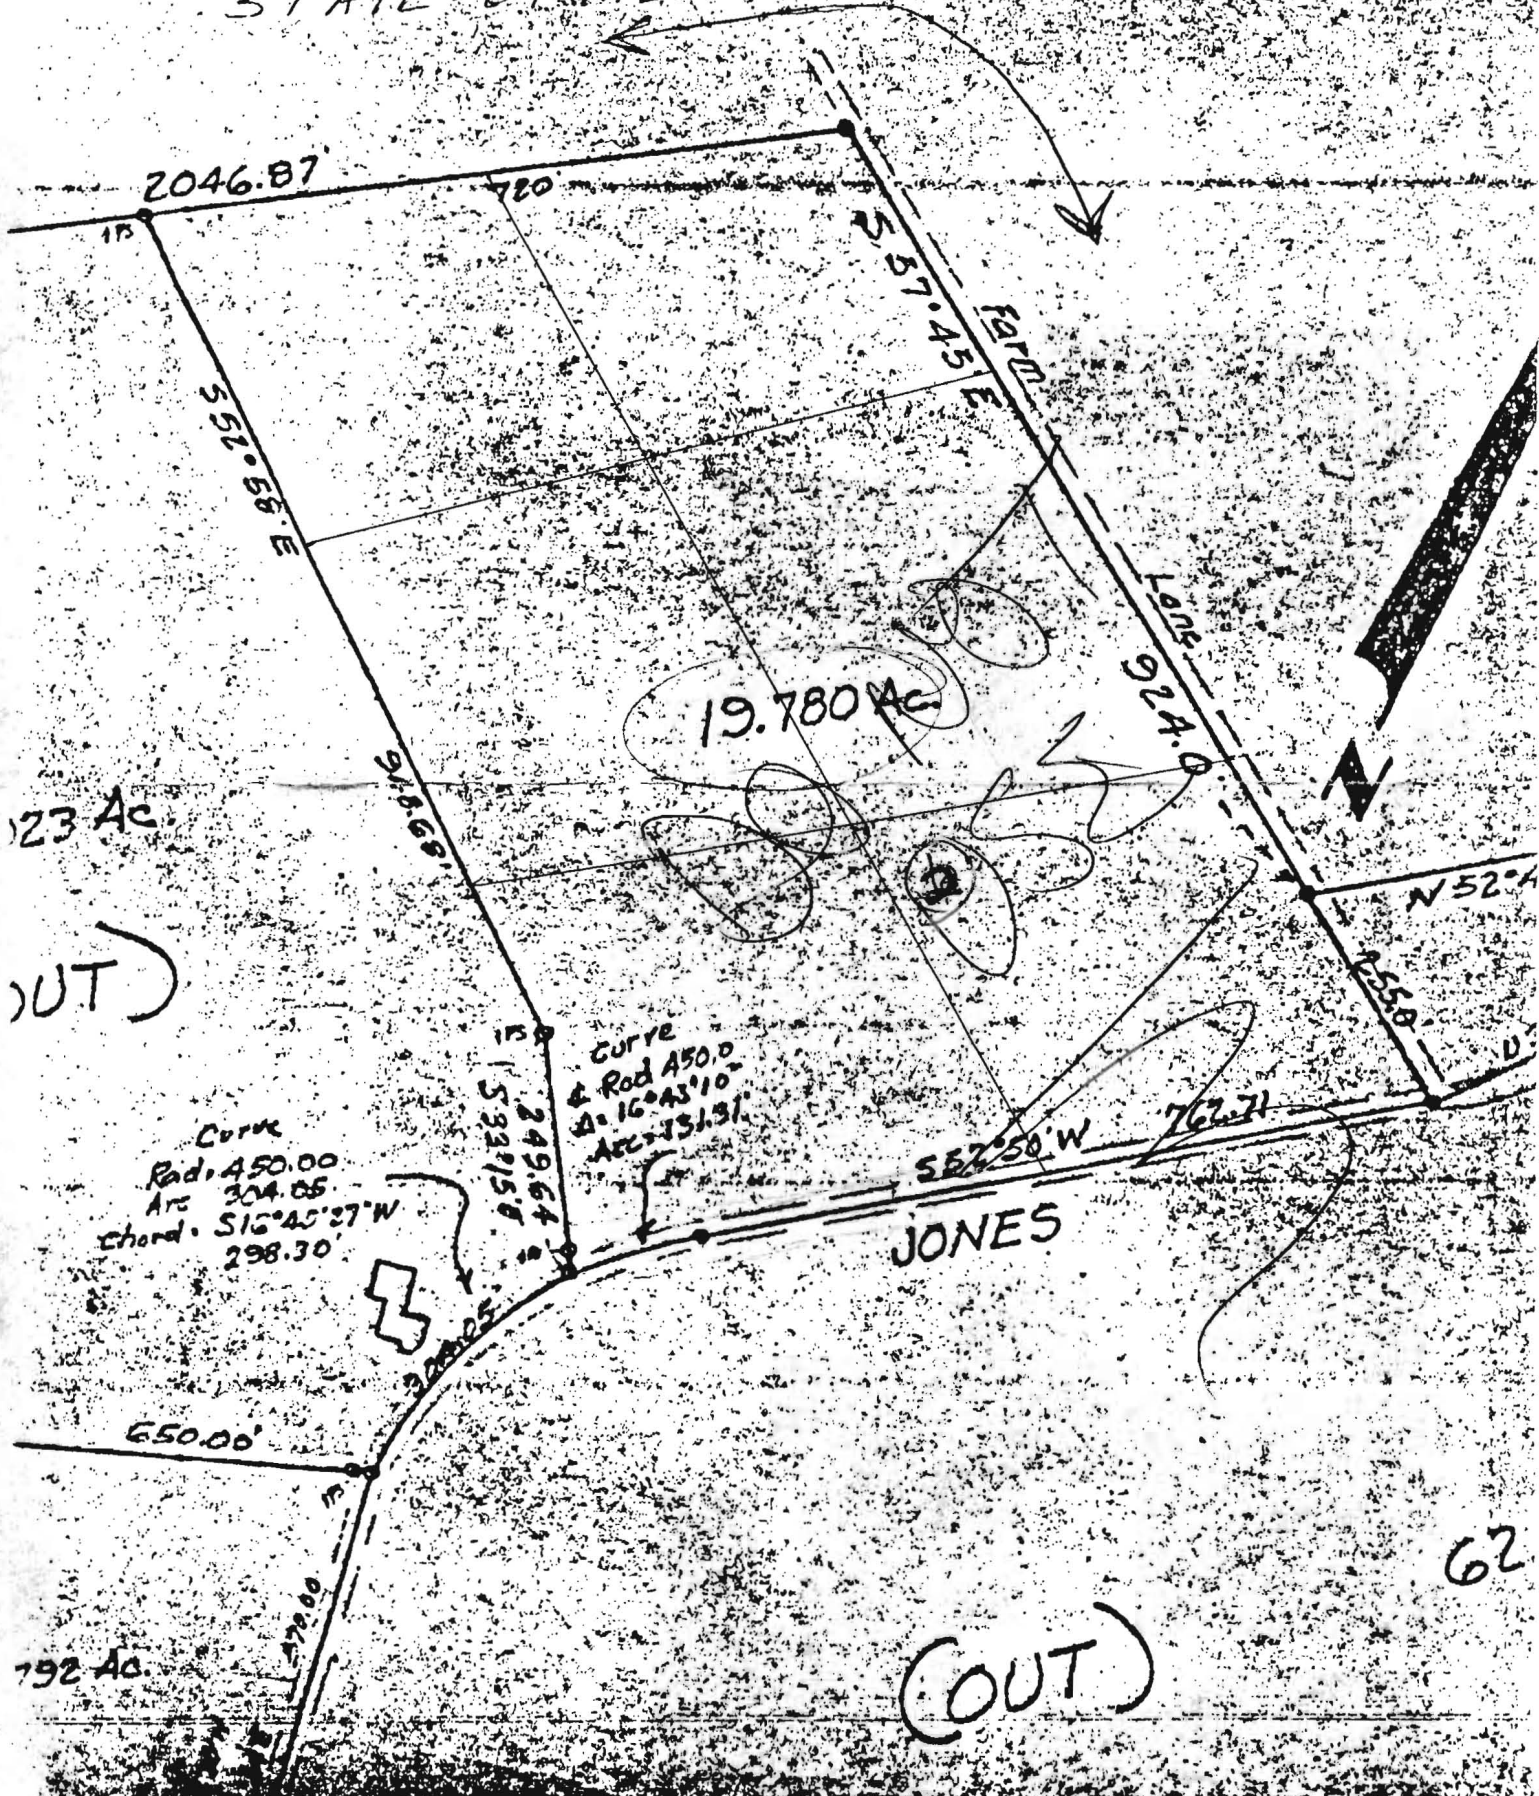


LOT 1
INDALE FARM
T.C.M.F. 9235

F-87-202

OWNER'S CERTIFICATE

TERESA CHACONAS, OWNERS OF THE PROPERTY SHOWN
 ON THE PLAN OF SUBDIVISION AND ZONING, ESTABLISHED
 BY THE BOARD OF PLANNING AND ZONING, COUNTY OF
 HOWARD, MARYLAND, HEREBY GRANT INTO HOWARD COUNTY
 COURTS, IN AND UNDER SEVERAL CASES, THE RIGHT
 TO CONSTRUCT AND MAINTAIN SEWER LINES AND
 SERVICES IN THE AREAS SHOWN HEREON AND TO
 OCCUPY THE AREAS SHOWN HEREON FOR THE PURPOSES
 OF THE STREET AND GOOD AND BEAUTIFUL

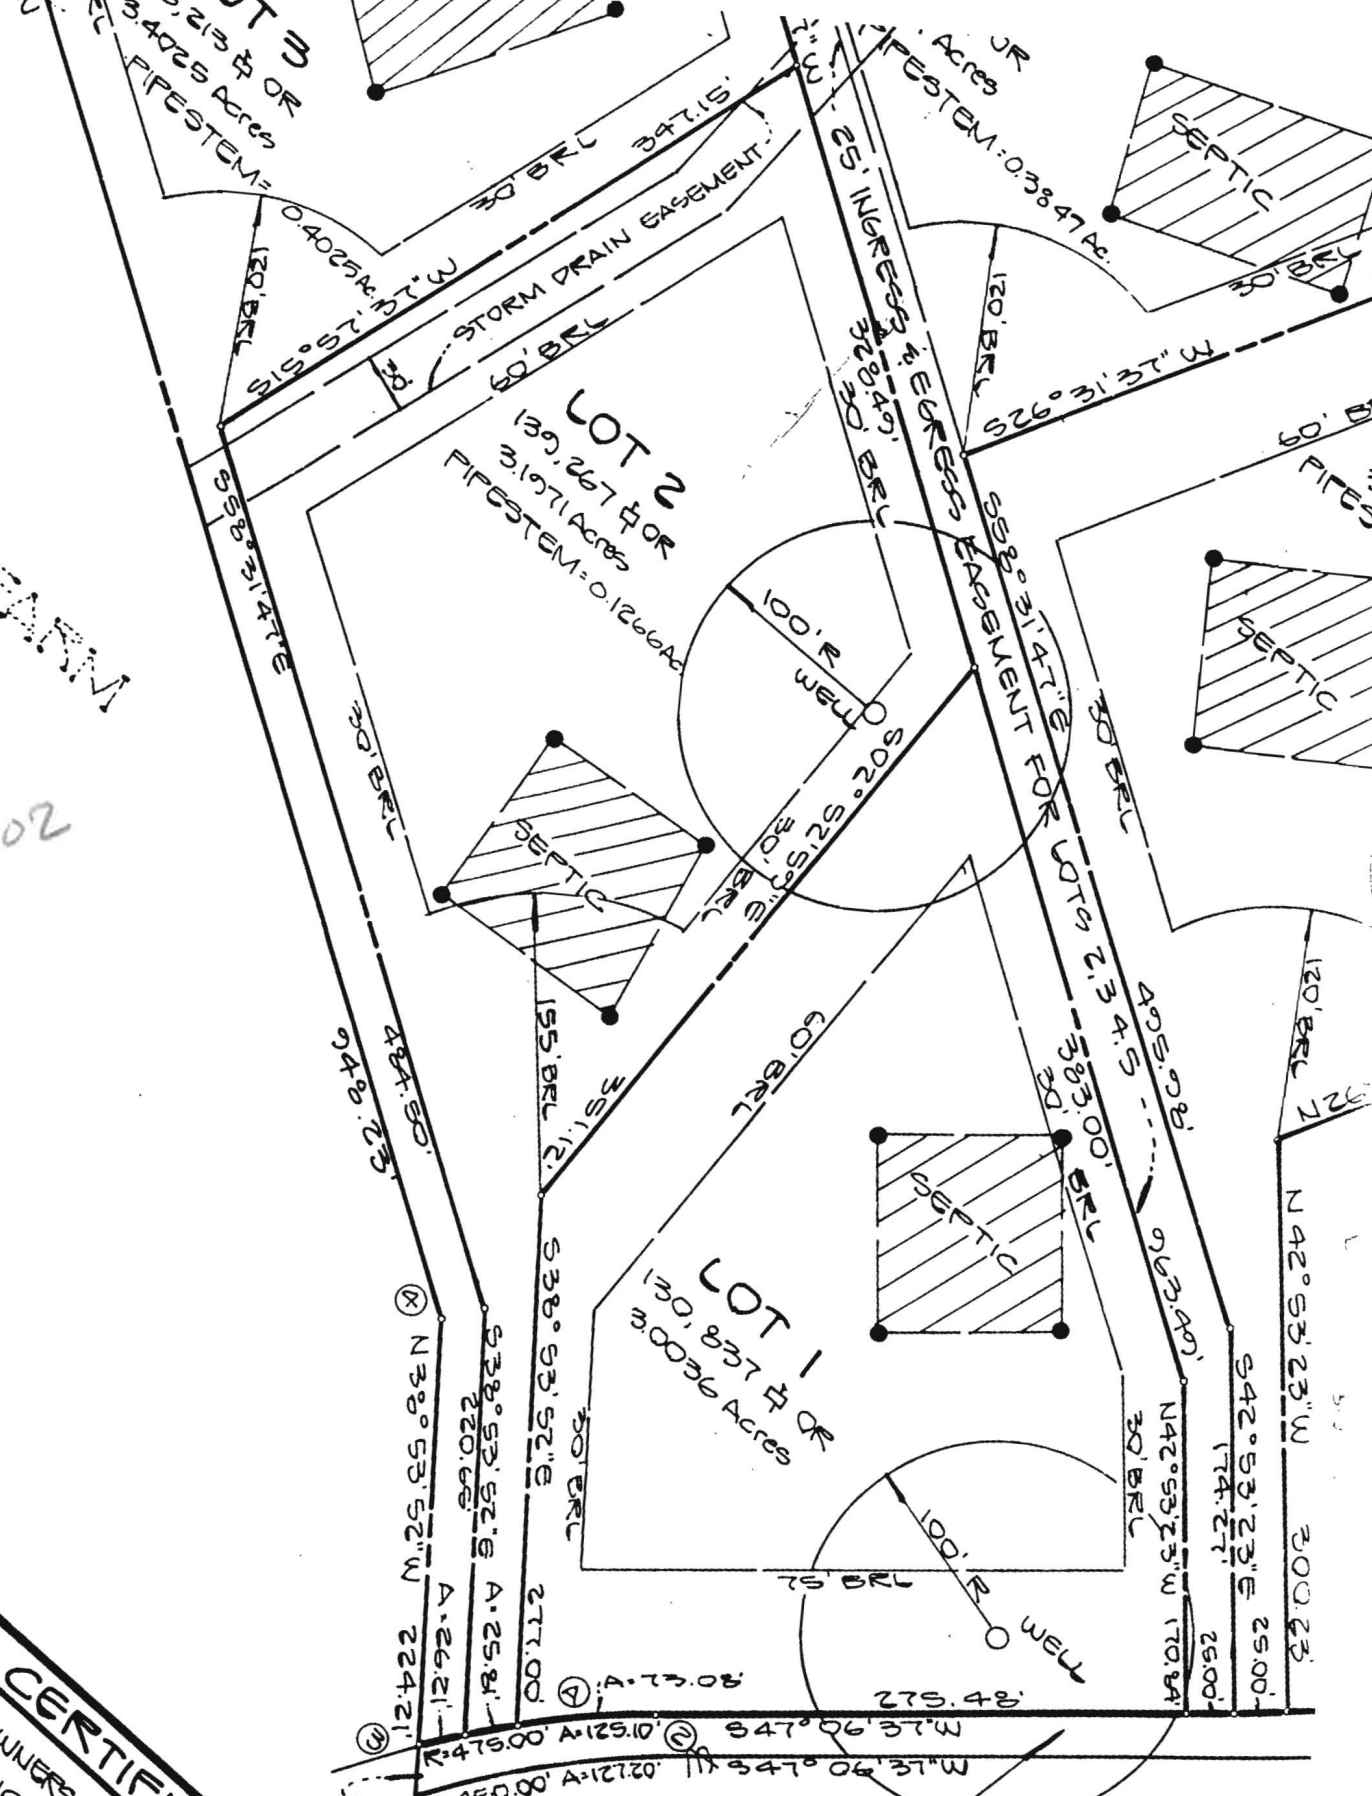

JONES
(50' ↗)

